

GOVERNMENT CORNER RESTORATION FORM

Township 27S Range 6W Sec. 2 County DOUGLAS

State OR Date 10/18/88 No. _____

Corner Designation

S3 | S2
S10 | S11

- Condition Report Only
- Not Found
- Renewed
- Unrecorded
- Surveyed In
- Referenced Out

Previous Renewals #102

Monument(s) Found: (Condition and Source)

A 1 1/4" O.D. DIA IRON PIPE WITH A
2 1/2" DIA BRASS CAP PROTRUDES 16 IN.
ABOVE GROUND AND LEANS 4 IN.
SOUTHWEST. (PER REN #102)

MONUMENT DETAIL

COUNTY SURVEYORS OFFICE
T27S R6W
S3 | S2
S10 | S11
1961

Accessories Found:

BEARINGS AND DISTANCES TAKEN TO PLUMB POSITION OF BC/1P

- 1 18" NOW 36" DIA 2 1/2 FT HIGH ROTTED OAK STUMP, WITH A PREVIOUSLY OPENED BLAZE, NO SCRIBING VISIBLE, BEARS N71 1/2° E, 352.4 FT (RECORD N74° E, 352.4 FT) ORIG. BT
- 2 20" DIA OAK NOW A DEPRESSION WITH ROOTS IS FOUND, BEARS S74° E, 433.0 FT (RECORD S71 1/2° E, 433.0 FT.) ORIG. BT
- 3 30" NOW 36" DIA W. OAK WITH A FULLY HEALED DOUBLE BLAZE BEARS N66 1/2° E, 275.4 FT (RECORD N68 3/4° E, 275.4 FT). PER REN #102
- 4 15" NOW 26" DIA. B. OAK WITH A FULLY HEALED DOUBLE BLAZE BEARS S88 1/2° W, 515.6 FT (RECORD S30° W, 517.0 FT DISTANCE IS TO CENTER OF TRUNK) PER REN #102
- 5 3/4" IRON ROD PROTRUDING 8" ABOVE GROUND IS FOUND IN AN OLD DILAPIDATED FENCE LINE, BEARS EAST, 30.7 FT (AGREES WITH RECORD) PER REN #102

#181 ✓

RENEWAL

Monument Set (Procedure and Description)

BRASS CAP IRON PIPE RETURNED TO
PLUMB POSITION AND A 2 FT DIA.
MOUND OF STONE SET AROUND BASE

Monument Detail


N/A

New Accessories

NONE

Sketch of Monument, Accessories, and General Area

- ▲ DCSO BLIP (1961)
- ORIG. BT'S
- BT'S PER REN #102
- 3/4" I.R. PER REN #102

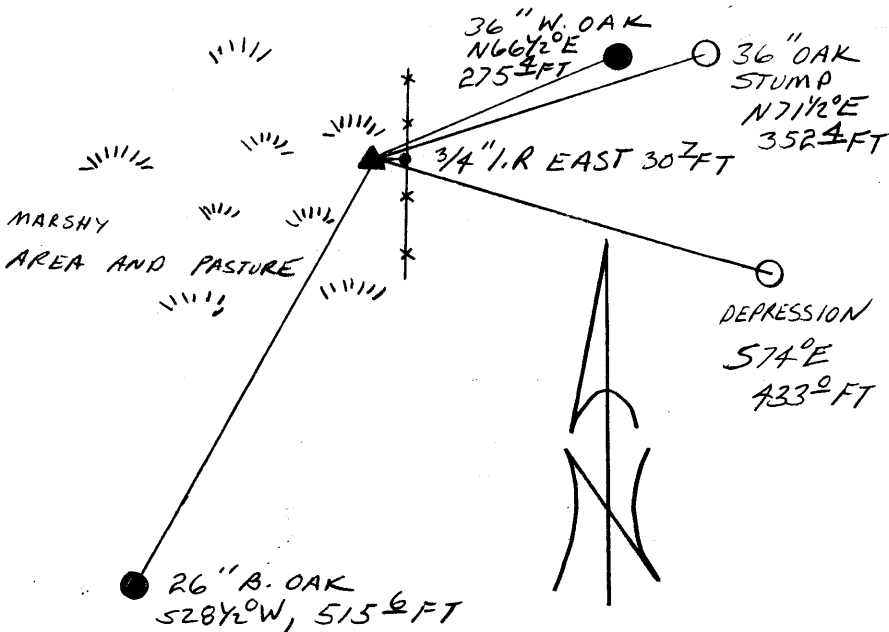


Location & Comments

CORNER LIES ON NORTHWESTERLY SIDE
OF A NORTHEASTERLY RIDGE
NEAR ITS BASE.

Comp. Declin. 18° 42' E
 Agency DCSO
 Party Chief RANDALL W. SMITH
 Notekeeper Randall W. Smith
 Witnesses STEPHEN J. FLAUSE

Address

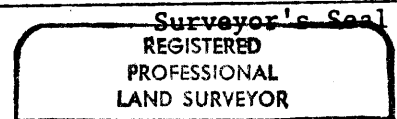

Handwritten signature of Larry E. Monrean

