

GOVERNMENT CORNER RESTORATION FORM

FILED

Township 25S Range 3W Sec. 19 County DOUGLAS

APR 3 1989

State OR Date 3/28/89

No. \_\_\_\_\_

COUNTY SURVEYOR  
DOUGLAS COUNTY, OR

Corner Designation

1/4 519 | 520

- Condition Report  Only
- Not Found
- Renewed
- Unrecorded
- Surveyed In
- Referenced Out

MONUMENT DETAIL

Previous Renewals 1944 BLM D. RESURVEY, #28, #122

Monument(s) Found: (Condition and Source)

A 2 1/2" G.L.O. BRASS CAP ON A 37" LONG  
1" IRON PIPE, ~~STAMPED~~ ~~EDGE~~ ~~ON~~ ~~TOP~~  
~~TOP~~ ~~OF~~ ~~GROUND~~, BEARING  
S20°E, 22.5 FT FROM A CORNER  
POSITION DETERMINED BY BEARING TREES.

U.S. GENERAL LAND

1/4

520 | 519

1944

OFFICE SURVEY

NOTE: G.L.O. BRASS CAP'S STAMPING  
 OF SECTION NUMBERS IS WRONG

Accessories Found:

14" NOW 21" DIA. 2 1/2 FT HIGH ROTTED D. FIR STUMP, NO SCRIBING  
FOUND, BEARS N80°E, 31.7 FT (AGREES WITH REC.) PER 1944 D. RESURVEY

30" NOW 30" DIA. 6 FT HIGH D. FIR STUMP, SCRIBING VISIBLE ON  
A PREVIOUSLY OPENED BLAZE "1/4 S 19 BT" BEARS S77°W, 16.5 FT  
(AGREES WITH REC.) PER 1944 D. RESURVEY.

42" NOW 36" DIA. 2 1/2 FT HIGH ROTTED D. FIR STUMP, WITH SCRIBING  
VISIBLE "1/4" BEARS N26°E, 39.0 FT. (AGREES WITH REC.) PER REN #28

4" NOW 15" DIA. D. FIR WITH A FULLY HEALED DOUBLE BLAZE  
BEARS S68°W, 11.1 FT (AGREES WITH REC.) PER REN #122.

4" NOW 14" DIA. D. FIR WITH A FULLY HEALED DOUBLE BLAZE  
BEARS S55 1/2°E, 89.7 FT (REC S53 1/2°E, 89.7 FT) PER REN #122.

#1434

RENEWAL

Monument Set (Procedure and Description)

A CORNER POSITION WAS DETERMINED FROM BEARING TREES. A 2 3/8" DIA. DCSO BRASS CAP ON A 1 7/8" D.I.D. BY 32" LONG IRON PIPE IS SET AND PROTRUDES 7" ABOVE GROUND. 1944 GLO BC/IP IS SET ALONG NORTH EDGE OF NEW ALSO BC/IP AND PROTRUDES 3" ABOVE GROUND.

Monument Detail

DOUGLAS COUNTY SURVEYORS

T255


1/4 | S19 | S20 | R  
3  
W

1989  
OFFICE

New Accessories

11" DIA D. FIR DOUBLE BLAZED AND SCRIBED "1/4 S20 CS BT"  
BEARS N59°E, 7.0 FT.

Sketch of Monument, Accessories, and General Area

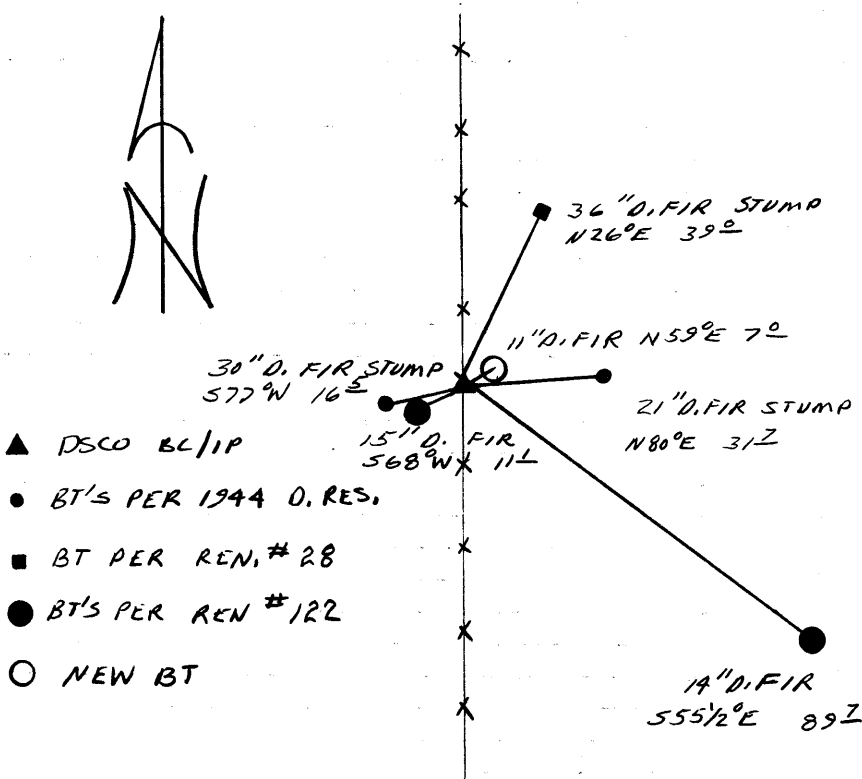

Location & Comments

CORNER LIES IN AN OLD, DETERIORATED, PARTIALLY DOWN NORTHERLY - SOUTHERLY RUNNING BARBED WIRE FENCE LINE.

Comp. Declin. 18 1/2°E  
Agency DCSO  
Party Chief RANDALL W. SMITH  
Notekeeper Randall W. Smith  
Witnesses STEPHEN J. FLAUSE

Address

Surveyor's Seal  
REGISTERED  
PROFESSIONAL  
LAND SURVEYOR

*Larry E. Monrean*

OREGON  
JULY 13, 1979  
LARRY E. MONREAN  
#1830