

GOVERNMENT CORNER RESTORATION FORM

Township 24S Range 5W Sec. 33 County DOUGLAS

State OR Date 1/10/89 No. _____

Corner Designation

S33|S34
S4|S3

- _____ Condition Report Only
- _____ Not Found
- Renewed
- _____ Unrecorded
- _____ Surveyed In
- _____ Referenced Out

Previous Renewals FB30 PG31, #13 INT24S R5W
^{#34 #61}

MONUMENT DETAIL

Monument(s) Found: (Condition and Source)

A 3/4" I.D. IRON PIPE, 45" LONG
OUT OF GROUND LEANING AGAINST
FENCE. (PER REN #13)

#46A AND #50 INT25S R5W

A HOLE 1 1/2 FT LONG BY 6 IN
WIDE AND 6 IN DEEP WAS FOUND
AT PROBABLE CORNER POSITION,

N/A

Accessories Found:

16" NOW 36" DIA. D. FIR WITH A FULLY HEALED SINGLE BLAZE
BEARS N70 1/2° E, 33.8 FT (RECORD N72 1/2° E, 33.8) PER REN #13.

10" NOW 25" DIA MADRONE WITH A FULLY HEALED DOUBLE BLAZE
BEARS N28° W 124.0 FT (AGREES WELL WITH RECORD) PER REN #50

18" NOW 26" DIA. D. FIR WITH A FULLY HEALED DOUBLE BLAZE
BEARS S24° E, 57.2 FT (RECORD S22 1/2° E, 58.0, DISTANCE
IS A POSSIBLE SLOPE MEASUREMENT) PER REN #50

NO OTHER BT'S FOUND

#148 T25-S X
~~110~~ T24-S X
#110

RENEWAL

Monument Set (Procedure and Description)

Monument Detail

A 2 1/4 IN. DIA. BRASS CAP ON A 30 1/2 IN. LONG,
1 3/8 IN. O.D. IRON PIPE IS SET AT
NORTH END OF PREVIOUSLY DESCRIBED HOLE
AS THE MOST PROBABLE POSITION OF SECTION
CORNER. BRASS CAP/IRON PIPE PROTRUDES
7 IN. ABOVE GROUND. 3/4 IN. IRON PIPE
FROM REN #13 IS SET ALONG SOUTH
EDGE OF AC/1P, AND PROTRUDES 5 IN.
ABOVE GROUND.

DOUGLAS COUNTY SURVEYORS
T 24 S


533 | 534 R
54 | 53 W

T 25 S
1989
OFFICE

New Accessories

NONE

Sketch of Monument, Accessories, and General Area

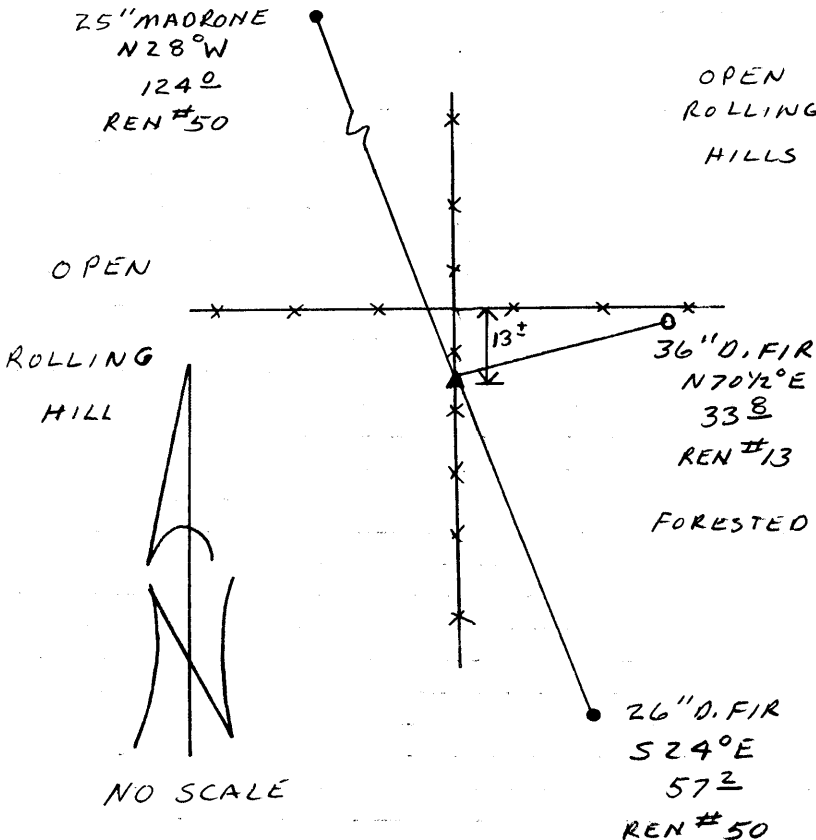

Location & Comments

CORNER IS APPROX. 13 FT
SOUTH OF A FOUR WAY
FENCE CORNER, IN SOUTH
RUNNING FENCE LINE.

SECTION CORNER IS ALSO
THE SW D/C CORNER #40
IN T 24 S R 5 W

Comp. Declin. 18 1/2° E
Agency DCSO
Party Chief RANDALL W. SMITH
Notekeeper [Signature]
Witnesses STEPHEN J. FLAUSE

Address

Surveyor's Seal

REGISTERED
PROFESSIONAL
LAND SURVEYOR

[Signature]

OREGON
JULY 13, 1979
LARRY E. MONREAN
#1830