

GOVERNMENT CORNER RESTORATION FORM

Township 30 S Range 3W Sec. 32 County DOUGLAS

State OR Date 1/4/09 No. _____

Corner Designation

S32 | S33

S5

- Condition Report Only
- Not Found
- Renewed
- Unrecorded
- Surveyed In
- Referenced Out

Previous Renewals #78, #181

Monument(s) Found: (Condition and Source)

A 3/4" I.D. IRON PIPE FIRMLY SET AND FLUSH WITH GROUND (PER REN #78)

A 1 1/4" O.D. IRON PIPE WITH A 2 1/2" DIA. ALSO BRASS CAP LOOSLY SET PROTRUDING 20" ABOVE GROUND (PER REN #181) (#118 T.31-3)

3/4" IRON PIPE IS ALONG SOUTH SIDE OF ALSO BC/IP.

ORIGINAL STONE NOT SEEN

COUNTY SURVEYORS OFFICE
T30S
S32 | S33 R
----- 3
S5 W
T31S
1966

Accessories Found:

- BT'S PER REN #78
- 20" NOW 20" DIA 6 FT HIGH GEAR STUMP WITH A FULLY HEALED DOUBLE BLAZE BEARS N7°E, 6.0 FT (AGREES WITH RECORD).
- 16" NOW 18" DIA 6 FT HIGH GEAR STUMP WITH PARTIALLY HEALED DOUBLE BLAZE, FACES ARE BURNT, NO SCRIBING VISIBLE, BEARS S1°W, 34.0 FT (REC. S1°W, 34.7 FT POSSIBLE SLOPE MEASUREMENT)
- 20" NOW 24" DIA 6 FT HIGH GEAR STUMP WITH A FULLY HEALED DOUBLE BLAZE BEARS S35°W, 31.7 FT (REC. S35°W, 34.0 FT). DIST. ~~TO~~ POSSIBLY TO CENTER OF TRUNK, NOT ROOT CROWN.
- 20" NOW 25" DIA BURNT AND DEAD STANDING GEAR WITH A FULLY HEALED SINGLE BLAZE, BEARS N5°W, 22.0 FT (AGREES WITH RECORD)

#235 T30-3 X
#257 T31-3 X

RENEWAL

Monument Set (Procedure and Description)

Monument Detail


DIRT MOUND AROUND BC/IP,
BRASS CAP NOW PROTRUDES 6 IN ABOVE
GROUND.

N/A

New Accessories

NO TREES ALIVE OR SUITABLE STUMPS IN AREA TO
USE AS BT'S OR BO'S

Sketch of Monument, Accessories, and General Area

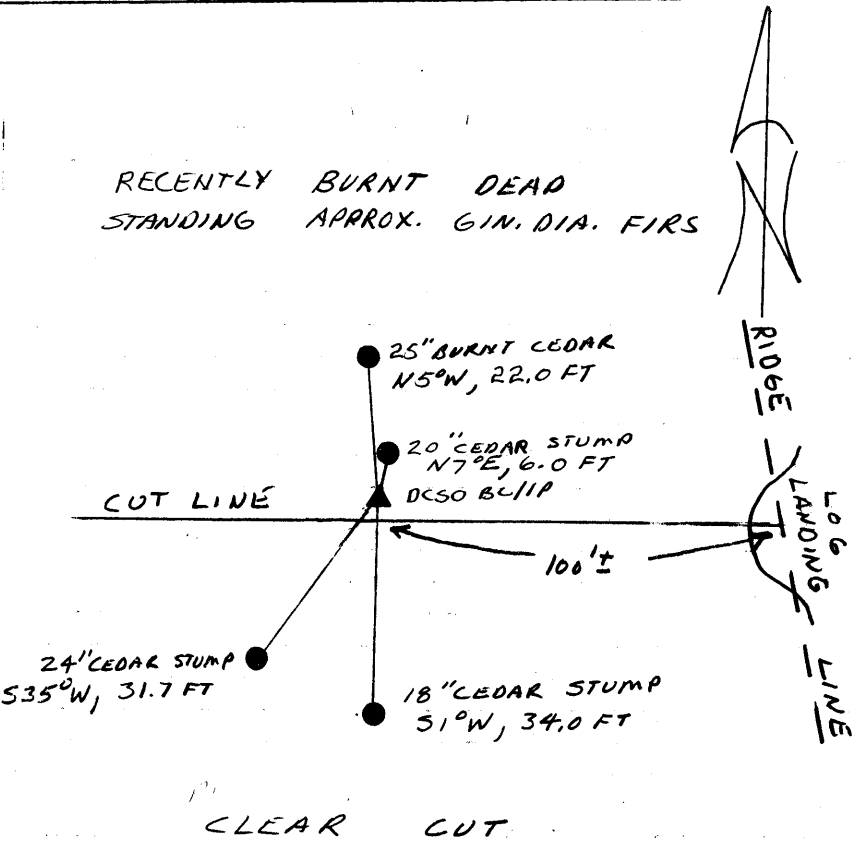

Location & Comments

CORNER LIES ON STEEP
WEST SLOPE APPROX. 100 FT
WEST OF TOP OF RIDGE, ON
AN EAST-WEST CUT LINE.

Comp. Declin. 18 1/2° E
Agency DCSO
Party Chief RANDALL W SMITH
Notekeeper Randall W Smith
Witnesses STEPHEN J FLAUSE

Address

Surveyor's Seal

REGISTERED
PROFESSIONAL
LAND SURVEYOR

Larry E. Monrean

OREGON
JULY 13, 1979
LARRY E. MONREAN
#1830