

GOVERNMENT CORNER RESTORATION FORM

FILED

Township 27S Range 3W Sec. 5

County DOUGLAS

JH
APR 20 1989

State OREGON

Date APRIL 5, 1989

No. _____

Corner Designation

T27S R3W

58 | 59

517 | 516

COUNTY SURVEYOR
DOUGLAS COUNTY, ORE.

- Condition Report Only
- Not Found
- Renewed
- Unrecorded
- Surveyed In
- Referenced Out

Previous Renewals 1958 BLM DEPENDENT RESURVEY

Monument(s) Found: (Condition and Source)

A 3 1/2 INCH DIAM. BLM DISK MARKED AS AT RIGHT ON A 2 1/2 INCH O.D. GALVANIZED IRON PIPE, FIRMLY SET AND PROTRUDING 5 INCHES ABOVE GROUND.

U.S. CADASTRAL SURVEY

T27S R3W

58 | 59

517 | 516

1958

BUREAU OF LAND MANAGEMENT

Accessories Found:

EVIDENCE OF FOUR ORIGINAL BEARING TREES FOUND. A LAUREL, 16 INS DIAM, NOW A 22 INCH D.B.H. MADRONE WITH FULLY HEALED DOUBLE BLAZE BEARS N47E, 31² FEET DIST. (ORIGINAL RECORD N50⁴E, 30⁴ FT. DIS. GOOD TO CENTER OF TREE AT BLAZE HEIGHT.). A FIR, 30 INS DIAM, NOW A 4 1/2 INCH DIAMETER 4 FOOT HIGH FIR STUMP WITH NO SCRIBING OR BLAZES VISIBLE BEARS S80²E, 49² FEET DISTANT (ORIGINAL RECORD S88²E, 48² FT. DIS.; BLM RECORD S83²E, 48² FT. DISTANCE IS POSSIBLE FACE MEAS.) A FIR, 36 INS DIA, NOW A 41 INCH DBH DOUGLAS FIR WITH BURNED BARK SCRIBING "S" VISIBLE BEARS S04²W 14⁵ FEET DISTANT (ORIGINAL RECORD S4²W, 13² FT. DIS. THIS IS A POSSIBLE FACE MEASUREMENT), A FIR 40 INS DIA, NOW A 48 INCH DIAMETER 3 FOOT HIGH FIR STUMP WITH NO BLAZES OR SCRIBING VISIBLE BEARS N42²W, 37² FEET DISTANT (ORIGINAL RECORD N42²W 36³ FT. DIS. THIS IS A POSSIBLE FACE MEASUREMENT).

FROM THE BLM 1958 DEPENDENT RESURVEY 3 BEARING TREES ARE FOUND. THE NE CEDAR BEARING TREE IS NOT FOUND DUE TO ROAD WORK IN AREA. A MADRONE 8 INS DIAM, NOW A DEAD 7 INCH D.B.H. MADRONE SNAG WITH A HEALED SINGLE BLAZE BEARS S29¹2²E, 28² FEET DISTANT (RECORD S31¹4²E 29² FT. DIST THIS IS A POSSIBLE SLOPE FACE MEASUREMENT). A CEDAR 9 INS DIAM, NOW A DEAD 10 INCH D.B.H. CEDAR WITH A PARTIALLY HEALED SINGLE BLAZE SHOWING THE SCRIBING "27S R3W S17B" BEARS S48²W 52² FEET DISTANT AS PER RECORD. A CHINQUAPIN 10 INS DIAM, NOW A 10 INCH D.B.H. 8 FOOT TALL SNAG WITH A PARTIALLY HEALED SINGLE BLAZE BEARS N73¹2²W, 62² FEET DISTANT (RECORD N73¹2²W, 62² FT. IS A SLOPE MEASUREMENT).

#1554

Monument Set (Procedure and Description)

Monument Detail


NA

NA

New Accessories

TWO NEW BEARING TREES ARE SCRIBED AND TAGGED. A 10 INCH D.B.H. MADRONE SCRIBED "T275 R3W S17 CS BT" ON A DOUBLE BLAZE BEARS S68 1/2 W 13 1/2 FEET DISTANT. AN 8 INCH D.B.H. INSENCE CEDAR SCRIBED "T275 R3W S8 CS BT" BEARS N66 1/2 W, 28 1/2 FEET DISTANT.

Sketch of Monument, Accessories, and General Area

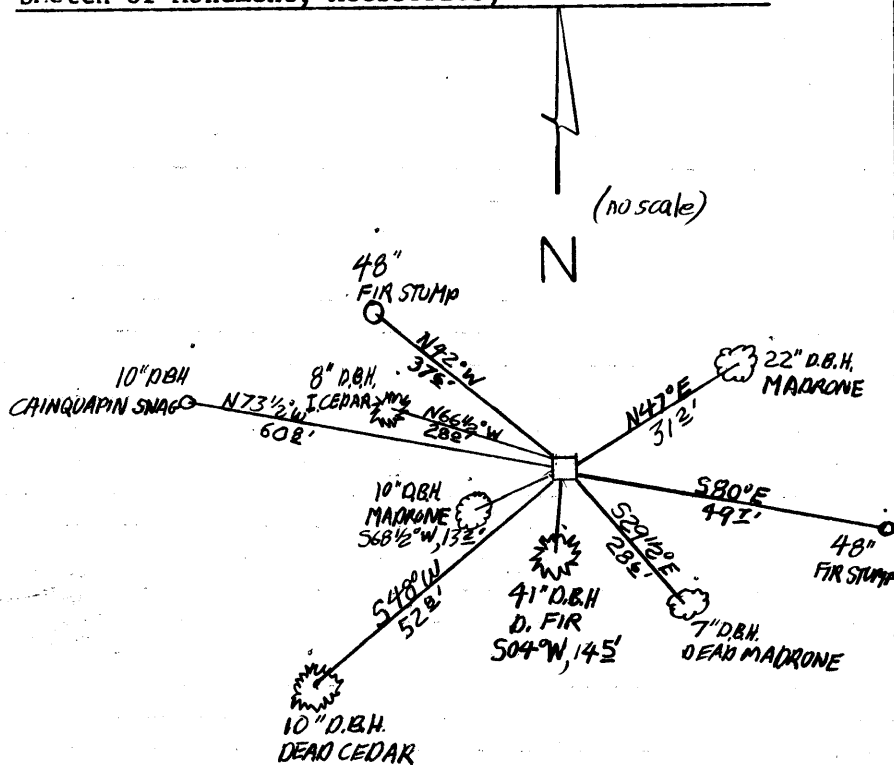

Location & Comments

MONUMENT LIES APPROX. TEN FEET SOUTHERLY FROM CENTERLINE OF A CAT FIRE ROAD NEAR THE TOP OF A STEEP ENE SLOPE AT THE WEST CUTTING LINE OF A LARGE CLEAR CUT. CLEAR CUT EXTENDS UP ENE SLOPE FROM JIM CREEK.

Comp. Declin. 13 E
Agency DCSD
Party Chief R.W. SMITH
Notekeeper Stephen John Flause
Witnesses S.J. FLAUSE

Address

Surveyor's Seal

REGISTERED PROFESSIONAL LAND SURVEYOR

Larry E. Monrean

OREGON
JULY 13, 1979
LARRY E. MONREAN
#1830