



RENEWAL

Monument Set (Procedure and Description)

Monument Detail

NONE

N/A


New Accessories

10" DIA. W. OAK DOUBLE BLAZED AND SCRIBED "SW DLC 48 CS BT"  
BEARS 53°E, 22.8 FT.

19" DIA. W. OAK DOUBLE BLAZED AND SCRIBED "SW DLC 48 CS BT"  
BEARS 558°E, 105.7 FT.


Sketch of Monument, Accessories, and General Area

Location & Comments

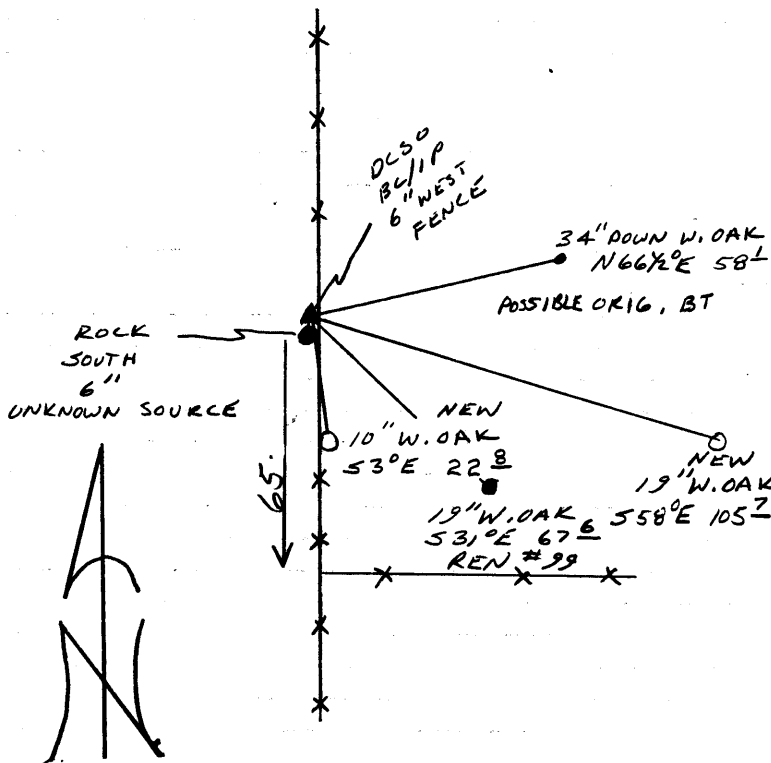

Comp. Declin. 18 1/2° E  
 Agency DCSO  
 Party Chief RANDALL W SMITH  
 Notekeeper Randall W Smith  
 Witnesses STEPHEN J FLAUSE  
LINDA RIGUTTO

Address

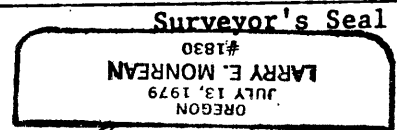

*Larry E. Monrean*

