


CERTIFIED RECORD OF LAND CORNER MONUMENTATION

History of original corner establishment:

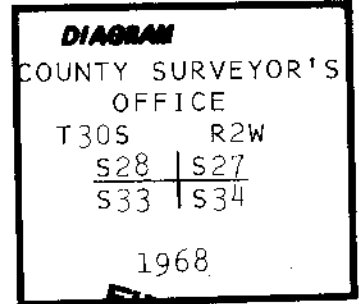

**FILED**  
**RECEIVED** *fl*  
 APR 5 1985  
 COUNTY SURVEYOR  
 DOUGLAS COUNTY, ORE

Description of corner evidence found:


FOUND A 2 1/2" BRASS CAP ON A 1" IRON PIPE ON SOUTH SIDE OF 7"X8"X18" STONE WITH AN "X" CHISELED ON TOP FROM WHICH;

- A 30" FIR BEARS N30°W 22.2 FEET, BARK SCRIBE VISIBLE.
- A 24" FIR BEARS N42°E 30.2 FEET, BARK SCRIBE VISIBLE.
- A 30" FIR BEARS S20°E 18.4 FEET, SCRIBE VISIBLE.
- A 26" FIR STUMP BEARS S10°W 38.5 FEET, SCRIBE VISIBLE.
- THE REMAINS OF A 12" FIR BEARS S54 1/2°W 16.7 FEET, SCRIBE VISIBLE.

Description of monument and accessories I established to perpetuate the original location of this corner:

I SCRIBED A 6" FIR WHICH BEARS S33°W 71.7 FEET, MARKED T30S R2W S33 BT.

LOYD R. MOFFIT  
 FRIAR-MOFFIT & ASSOC.  
 717 W. 10TH ST.  
 MEDFORD, OR 97501

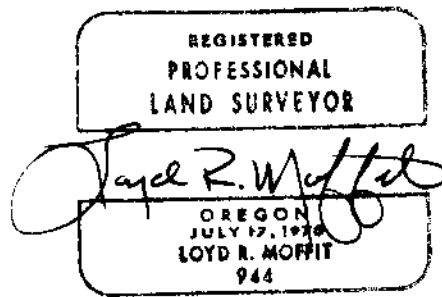

Office of..... Surveyor..... County of..... Douglas.....  
 State of..... Oregon....., I hereby certify that the within instrument was filed in this office  
 for record on the..... 5..... day of..... April....., 19..... 85.....  
 ..Fritz Ingram..... by ..Virginia A. Sawyer.....  
 (COUNTY OFFICIAL) (DEPUTY)

#254 X

C.S. File No. 63/8-2

c