


CERTIFIED RECORD OF LAND CORNER MONUMENTATION

History of original corner establishment:

CORNER WAS ESTABLISHED IN 1978 BY O.L.S. 536.

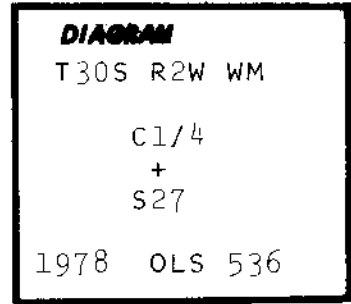

FILED
RECEIVED *JK*
APR 5 1985

Description of corner evidence found:

FOUND A 3" BRASS CAP ON A 2" IRON PIPE FROM WHICH;
A BLOWN DOWN 16" FIR BEARS S32°W 14.5 FEET, SCRIBE VISIBLE.
A BLOWN DOWN 8" FIR BEARS N83°E 10.9 FEET, SCRIBE VISIBLE.

COUNTY SURVEYOR
DOUGLAS COUNTY, ORE

Description of monument and accessories established to perpetuate the original location of this corner:

I SCRIBED: AN 18" FIR BEARS S43°E 12.9 FEET, MARKED C1/4 S27 BT.
A 24" FIR BEARS S44°W 39.9 FEET, MARKED C1/4 S27 BT.

LOYD R. MOFFIT
FRIAR-MOFFIT & ASSOC.
717 W. 10TH ST.
MEDFORD, OR 97501



Office of... Surveyor..... County of... Douglas
Oregon
State of....., I hereby certify that the within instrument was filed in this office
for record on the... 5... day of... April....., 19... 85
Fritz Ingram..... by *Virginia A. Langston*
(COUNTY OFFICIAL) (DEPUTY)

#253 +

C.S. File No. 63/8-5 c