


**CERTIFIED RECORD OF LAND CORNER MONUMENTATION**

History of original corner establishment:

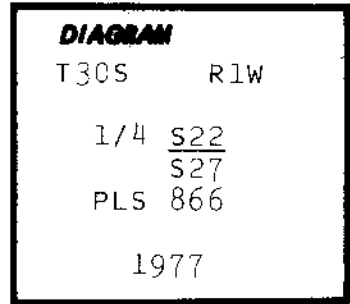

**FILED**  
**RECEIVED** *RL*  
APR 5 1985  
**COUNTY SURVEYOR**  
**DOUGLAS COUNTY, ORE**

Description of corner evidence found:


FOUNDA 2" BRASS CAP ON A 2" IRON PIPE PROJECTING 6" ABOVE  
STONE MOUND FROM WHICH;

- AN 8" SNAG BEARS S32°E 24.5 FEET, SCAR VISIBLE.
- AN 8" SNAG BEARS S34°W 22.5 FEET, SCAR VISIBLE.
- A 16" CEDAR BEARS N64°W 51.0 FEET, SCRIBE VISIBLE.
- A 12" OAK BEARS N52°W 47.0 FEET, SCAR VISIBLE.

Description of monument and accessories | established to perpetuate the  
original location of this corner:

I SCRIBED A 6" FIR WHICH BEARS S16°E 4.3 FEET, MARKED 1/4  
S27 BT.

LOYD R. MOFFIT  
FRIAR-MOFFIT & ASSOC.  
717 W. 10TH ST.  
MEDFORD, OR 97501

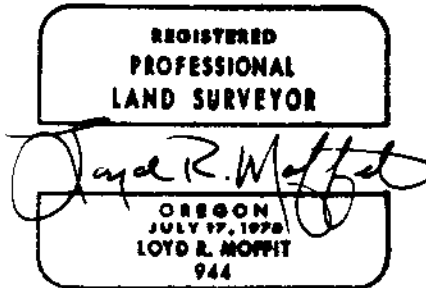

Office of..... Surveyor..... County of..... Douglas.....  
 State of..... Oregon....., I hereby certify that the within instrument was filed in this office  
 for record on the..... 5..... day of..... April..... 1985.....  
 Fritz Ingram..... by..... *Virginia A. Hansen*.....  
 (COUNTY OFFICIAL)..... (DEPUTY)

#223 +