

FILED
RECEIVED

MAY 16 1985

OREGON CORNER RESTORATION FORM

Section 6 Township 26 S Range 7 W

County DOUGLAS Date MAY 13, 1985

COUNTY SURVEYOR
DOUGLAS COUNTY, ORE.

Corner Designation

$\frac{1}{4}$ COR. BET S 31 T255 R7W &
S 6 T265 R7W

- Condition Report Only
- Not Found
- Renewed
- Unrecorded
- Surveyed In
- Referenced Out

Previous Renewals/Surveys, etc.

BLM SURVEY 1971

Monument(s) & Accessories Found: (Condition and Source)

FOUND BLM BRASS CAP AND BEARING TREE 20" FIR
S 30° W 16.2 FT.

Monument Detail

Sketch

THIS AREA WAS TO BE LOGGED IN 1984 SO I REMOVED THE PIPE & BRASS CAP & REPLACED WITH A $\frac{5}{8}$ " X 30" IRON ROD SET DEEP IN THE GROUND IN THE EXACT POSITION OF THE PIPE & BRASS CAP. AFTER THE LOGGING & SCALP BURNING, I RESET THE PIPE & BRASS CAP IN ITS ORIGINAL POSITION PUTTING IT DIRECTLY OVER THE IRON ROD.

Monument Set (Procedures and Description)

New Accessories

THE ORIGINAL BT IS NOW A 20" FIR STUMP 7' TALL
I REDESCRIBED THE TREE " $\frac{1}{4}$ S BT" AND MARKED
A BEARING TREE TAG ON WEST SIDE FACING ROAD.
COR. IS ON A LANDING 50' EAST OF ROAD.
NO OTHER TREES AVAILABLE

Location & Comments

Surveyor's Seal

Compass Declination 19 1/2

Firm/Agency SUN STUDS


Address PO. Box 1127

ROSEBURG

Party Chief BURTON W. HOLT

Notes

Witness GARY ANGIOLET

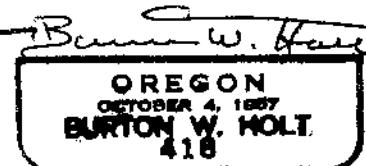

C.S. File No. 63/8-12

#116 T. 26-7 ✓
#135 T25-7 ✓

OK JLM