


CERTIFIED RECORD OF LAND CORNER MONUMENTATION

History of original corner establishment:

THIS CORNER WAS ESTABLISHED IN 1978 BY
R.L.S. 866.

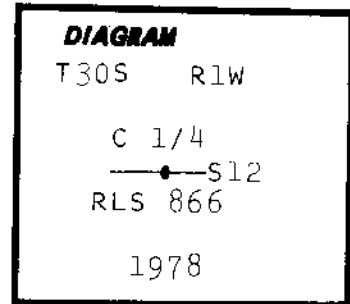

**FILED
RECEIVED** *JK*

MAY 23 1985

**COUNTY SURVEYOR
DOUGLAS COUNTY, ORE.**


Description of corner evidence found:

FOUND A 3" BRONZE CAP ON A 2 1/2" IRON PIPE FROM WHICH;
A 10" DEAD FIR BEARS N59°W 5.9 FEET, SCRIBE VISIBLE.
A 10" FIR (DOWN) BEARS N63°E 3.0 FEET, SCRIBE VISIBLE.

Description of monument and accessories established to perpetuate the original location of this corner:

I MARKED TWO NEW B.T.'S;
A 10" FIR BEARS N18°E 28.9 FEET, SCRIBED C 1/4 S12 BT.
A 11" FIR BEARS N86°E 34.1 FEET, SCRIBED C 1/4 S12 BT.

FRIAR-MOFFIT & ASSOC.
717 W. 10TH ST.
MEDFORD, OR 97501

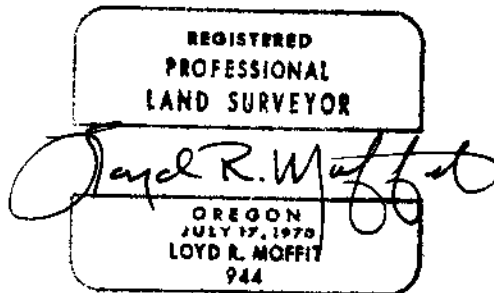

Office of..... Surveyor..... County of..... Douglas.....
State of..... Oregon....., I hereby certify that the within instrument was filed in this office
for record on the..... 23 day of..... May....., 1985.
Fritz Ingramy..... by..... *Virginia Ferguson*.....
(COUNTY OFFICIAL)..... (DEPUTY)

#228 ✓