

CERTIFIED RECORD OF LAND CORNER MONUMENTATION


History of original corner establishment:

THIS CORNER WAS RE-ESTABLISHED IN 1967
BY R.E 4287.

FILED
RECEIVED *rl*

MAY 23 1985

COUNTY SURVEYOR
DOUGLAS COUNTY, ORE.

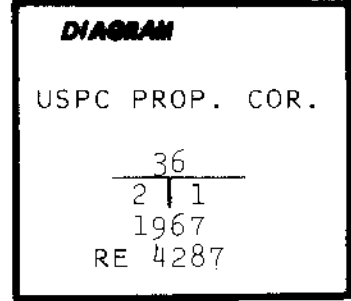

T 30 S R 1 W

Description of corner evidence found:


FOUND 2 1/2" ALUMINUM CAP ON 3/4" IRON PIPE FROM WHICH;

- A 30" FIR BEARS S62°W 17.2 FEET, SCRIBE VISIBLE.
- A 48" DEAD FIR BEARS S46°E 20.5 FEET, SCRIBE VISIBLE.
- A 40" FIR BEARS N10°E 88.9 FEET, SCRIBE VISIBLE.

Description of monument and accessories I established to perpetuate the original location of this corner:

I MARKED A NEW 10" FIR B.T. WHICH BEARS S 33°E 24.1 FEET FROM THE SECTION CORNER, SCRIBED T30S RLW S1 BT.

FRIAR-MOFFIT & ASSOC.
717 W. 10TH ST.
MEDFORD, OR 97501

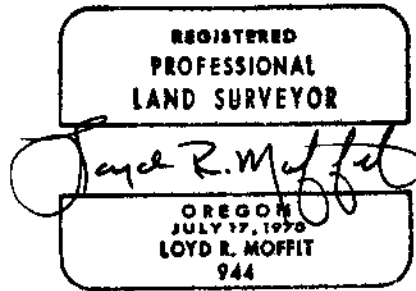

Office of..... Surveyor..... County of... Douglas.....
 State of..... Oregon....., I hereby certify that the within instrument was filed in this office
 for record on the 23 day of May....., 19... 85
 Fritz Ingram by *Virginia S. Lingen*
 (COUNTY OFFICIAL) (DEPUTY)

#149 ✓
#226 ✓