


**CERTIFIED RECORD OF LAND CORNER MONUMENTATION**

**History of original corner establishment:**

THIS CORNER WAS RE-ESTABLISHED IN 1923 BY THE G.L.O.

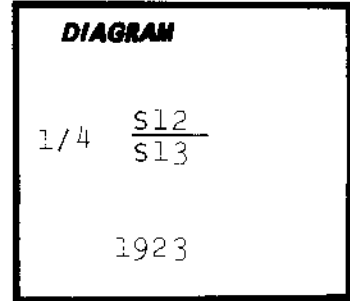

**FILED  
RECEIVED** *fl*

MAY 23 1985

**COUNTY SURVEYOR  
DOUGLAS COUNTY, ORE.**

T 30 S R 1 W

**Description of corner evidence found:**


FOUND A 2 1/2" BRASS CAP (G.L.O.) ON A 3/4" IRON PIPE FROM WHICH;

- A 12" DEAD FIR BEARS N15°E 10.1 FEET, SCRIBE VISIBLE.
- A 16" FIR (DOWN) BEARS S41°W 11.4 FEET, HEALED BLAZE.
- A 14" FIR BEARS S72°W 58.6 FEET, SCRIBE VISIBLE. (Rec. S 65° 19' W)
- A PINE STUMP (ORIGINAL B.T.) BEARS N17°W 87.4 FEET, SCAR VISIBLE.
- A 40" PINE (ORIGINAL B.T.) BEARS S25°E 103.5 FEET, SCRIBE VISIBLE.

**Description of monument and accessories I established to perpetuate the original location of this corner:**

I MARKED A NEW 10" FIR B.T. WHICH BEARS EAST 9.4 FEET FROM THE SECTION CORNER, SCRIBED 1/4 S12 BT.

FRIAR-MOFFIT & ASSOC.  
717 W. 10TH ST.  
MEDFORD, OR 97501

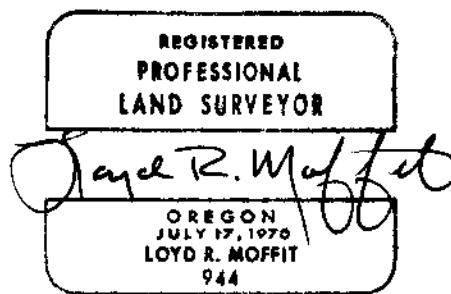

Office of... Surveyor..... County of... Douglas  
 State of... Oregon..... I hereby certify that the within instrument was filed in this office  
 for record on the 23 day of May 1985  
 Fritz Ingram by Virginia Rayson  
 (COUNTY OFFICIAL) (DEPUTY)

#225 ✓