


CERTIFIED RECORD OF LAND CORNER MONUMENTATION

History of original corner establishment:

THIS CORNER WAS RE-ESTABLISHED IN 1963 BY THE DOUGLAS COUNTY SURVEYOR'S OFFICE.

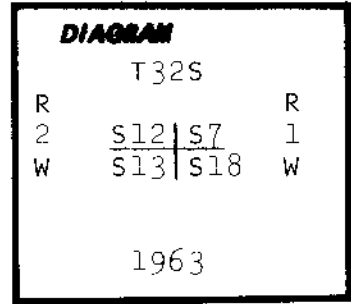

FILED
RECEIVED *LR*

JUN 7 1985

COUNTY SURVEYOR
DOUGLAS COUNTY, ORE.

Description of corner evidence found:

FOUND A 2 1/2" BRONZE CAP ON A 1" IRON PIPE FROM WHICH;

- A 18" FIR (DEAD) BEARS N22°E 49.6 FEET, BLAZES HEALED.
 - A 14" FIR BEARS S34°E 21.6 FEET, SCRIBED VISIBLE.
 - A 13" FIR BEARS S72°W 40.3 FEET, SCRIBE VISIBLE.
 - A 15" FIR BEARS N85°W 23.3 FEET, SCRIBE VISIBLE.
 - A 6" FIR (DEAD) BEARS N37°W 48.7 FEET, SCRIBE VISIBLE.
- (Record, Chinquapin)

Description of monument and accessories established to perpetuate the original location of this corner:

I MARKED A NEW 7" FIR B.T. WHICH BEARS N01°E 15.9 FEET FROM THE CORNER, SCRIBED T32S RLW S7 BT.

LOYD R. MOFFIT
717 W. 10TH ST.
MEDFORD, OR 97501



Office of..... Surveyor..... County of..... Douglas.....
 State of..... Oregon....., I hereby certify that the within instrument was filed in this office
 for record on the..... 7..... day of..... June....., 19..... 85.....
 by..... Francis L. Ingram..... (COUNTY OFFICIAL)..... by..... *Virginia A. Hansen*..... (DEPUTY)

#123 T32-2 4
100 T32-1 4

C.S. File No. 63/8-17 c