


CERTIFIED RECORD OF LAND CORNER MONUMENTATION

History of original corner establishment:

THIS CORNER WAS RE-ESTABLISHED IN 1976 BY THE DOUGLAS COUNTY SURVEYOR'S OFFICE.

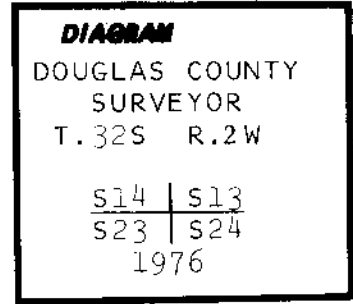

FILED RECEIVED *LR*

JUN 7 1985

Description of corner evidence found:

FOUND A 2 1/2" BRASS CAP ON A 1 1/2" IRON PIPE FROM WHICH,


- A 16" FIR BEARS N46°W 46.4', SCAR VISIBLE.
- A 14" FIR BEARS S34°E 26.0', SCRIBE VISIBLE.
- A 24" FIR BEARS S44°W 72.0', SCRIBE VISIBLE.
- A 27" FIR BEARS N25°W 84.0', SCAR VISIBLE.

COUNTY SURVEYOR DOUGLAS COUNTY, ORE.

Description of monument and accessories | established to perpetuate the original location of this corner:

I SCRIBED A 6" FIR WHICH BEARS N12°E 23.5', MARKED
T32S R2W S13 BT

LOYD R. MOFFIT
717 W. 10TH ST.
MEDFORD, OR 97501

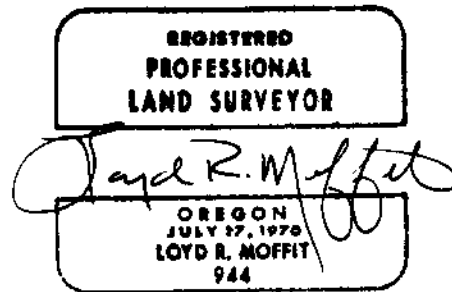

Office of..... Surveyor..... County of..... Douglas.....
 State of... Oregon....., I hereby certify that the within instrument was filed in this office
 for record on the... 7... day of... June....., 19... 85
 Francis L. Ingram..... by *Virginia C. Rayson*
 (COUNTY OFFICIAL) (DEPUTY)