

FILED
RECEIVED *sh*

AUG 14 1985

OREGON CORNER RESTORATION FORM

Section 29 Township 29S Range 6W

County Douglas Date Aug 7, 1985

COUNTY SURVEYOR
DOUGLAS COUNTY, ORE.

Corner Designation

SE 1/16

- Condition Report Only
- Not Found
- Renewed
- Unrecorded
- Surveyed In
- Referenced Out

Previous Renewals/Surveys, etc.


ADMINISTRATIVE SURVEY BY BLM - 1977 (No Record)

Monument(s) & Accessories Found: (Condition and Source)

FOUND 2" IRON PIPE WITH A 5' STEEL FENCE POST ALONGSIDE.

FOUND A 18" FIR STUMP BEARING $S 6\frac{3}{4}^{\circ} E$, 25.3 FT MARKED $\frac{1}{16}$ BT

Monument Detail

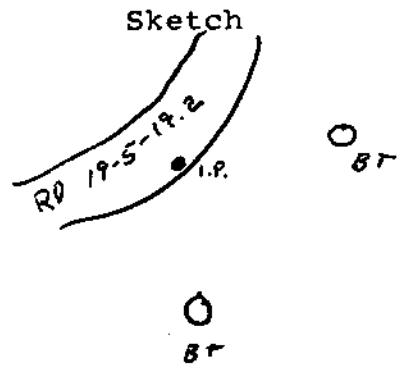

Monument Set (Procedures and Description)

BOTH BEARING TREE STUMPS ARE BARKED AND HAVE TIN ROOFS NAILED TO TOP.

New Accessories

A 17" D. FIR STUMP BEARS $N 71^{\circ} E$, 26.5 FT. MARKED $SE \frac{1}{16}$ BT

Location & Comments

LOCATED OFF OF BOOMER HILL ON EDGE OF RD NO. 29-5-19.2

Compass Declination 20°

Firm/Agency _____

SUN STUDS INC.

Address PG. BX 1127

ROSEBURG

Party Chief _____

Notes _____

Witness GARY ANGOLET

Surveyor's Seal

REGISTERED
PROFESSIONAL
LAND SURVEYOR

Burton W. Holt

OREGON
OCTOBER 4, 1997
BURTON W. HOLT
418