

OREGON CORNER RESTORATION FORM

Section 25 Township 26 Range 6W

County Douglas Date May 23, 1986

FILED
6/2/86
JL

JUN 9 1986

COUNTY SURVEYOR
DOUGLAS COUNTY, ORE.

Corner Designation

Witness Corner to N.W. corner
of John Akin DLC # 53



- Condition Report Only
- Not Found
- Renewed
- Unrecorded
- Surveyed In
- Referenced Out

Previous Renewals/Surveys, etc. C.S. 52/87 July 1964

Monument(s) & Accessories Found: (Condition and Source)

- Found a 1 inch iron pipe with brass cap marked County Surveyor's Office, 1954 NW corner DLC S3T26R6 W.C.
- 78.55 feet S 45° W to a chiselled X in top of R.R. pier, and,
- 95' North of a 27" walnut tree.

Monument Detail

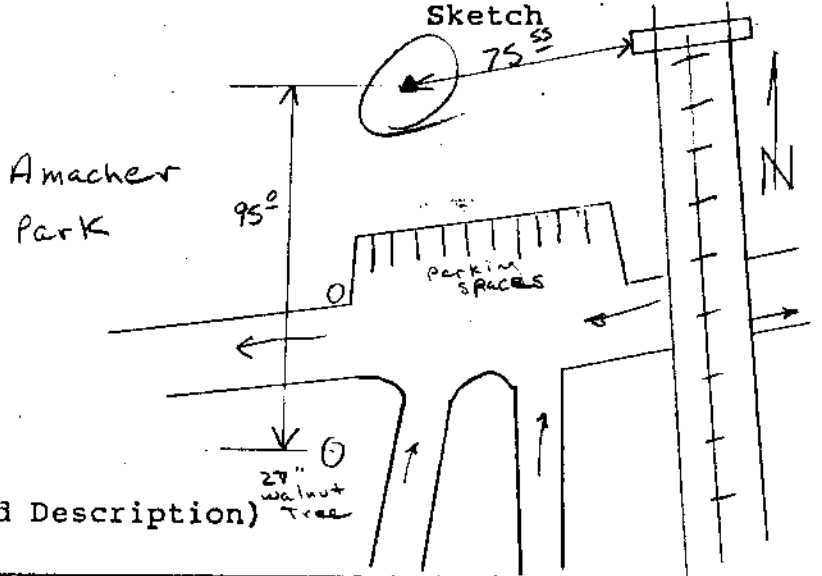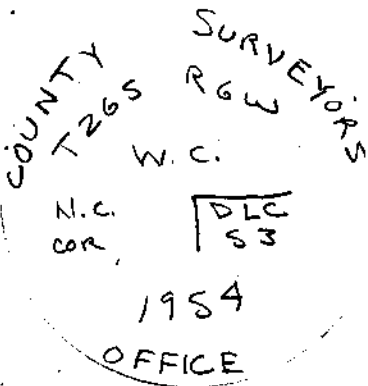

Monument Set (Procedures and Description)

N/A

New Accessories

N/A

Location & Comments

Surveyor's Seal

Compass Declination
 See above info. Firm/Agency ODOT
 Address 1523 S.E. Jackson
Roseburg
 Party Chief C. Black
 Notes R. Bennett
 Witness E. Wilcox

C.S. File No. 63/9-3