

FILED

*ff*

OREGON CORNER RESTORATION FORM

JUN 9 1986

Section 2 Township 29 Range 6W

County Douglas Date 5/30/86

COUNTY SURVEYOR  
DOUGLAS COUNTY, ORE.

Corner Designation

$\frac{1}{4}$  Corner to Sec. 35 T28-6 E Sec. 2, T29-6W

- Condition Report Only
- Not Found
- Renewed
- Unrecorded
- Surveyed In
- Referenced Out



Previous Renewals/Surveys, etc. CORNER FOUND OK by R. Smith Douglas Co. Surveyor's office 7/20/84

Monument(s) & Accessories Found: (Condition and Source)

- FOUND Conglomerate Rock with mark on it. Also found  $1\frac{3}{4}$  inch. I.P. 8" North of conglomerate rock. The I.P. extends approx. 12" above ground and is leaning N.E. Also Found the following Bearing Trees: A 10" (Now 18") W. OAK N 8° E 57.5 ft. with healed blaze and yellow tag. A 12" (Now 24") W. OAK S 34° 45' E 66 ft. with healed blaze and yellow tag

Monument Detail

Sketch

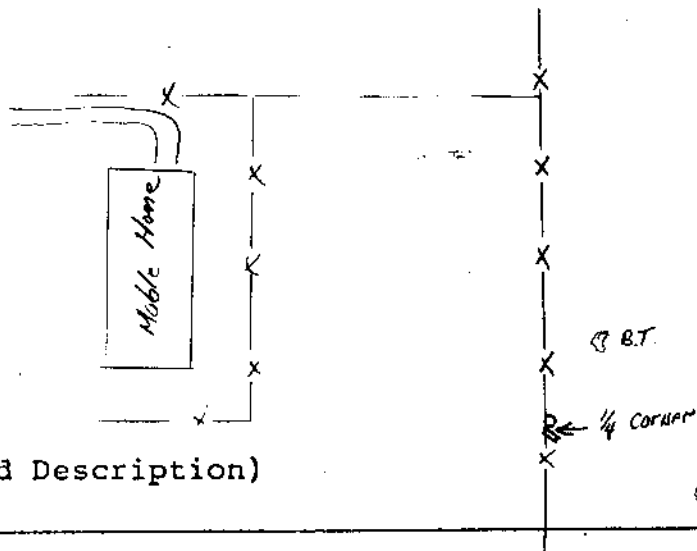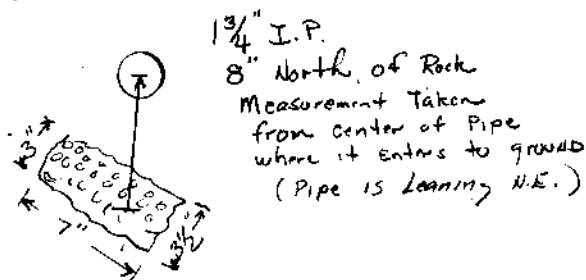

Monument Set (Procedures and Description)

New Accessories

Location & Comments

Surveyor's Seal

1/4 corner is located in North-South fence line on a gentle west slope Compass Declination \_\_\_\_\_  
 Firm/Agency O.D.O.T  
 Address 1529 S.E. CORB  
Roseburg Roseburg 97470  
 Party Chief L. Lathrop  
 Notes L. Lathrop  
 Witness R. Small

C.S. File No. 63/2-8