

FILED

JUN 27 1986

OREGON CORNER RESTORATION FORM

Section 2A Township 27 S Range 6 W

COUNTY SURVEYOR
DOUGLAS COUNTY, ORE.

County Douglas Date 6/26/86

Corner Designation

S.W. Corner DLC #56

- Condition Report Only
- Not Found
- Renewed
- Unrecorded
- Surveyed In
- Referenced Out


Previous Renewals/Surveys, etc. Renewed # 33, also
Renewal # 149, done by Douglas Co Surveyors Office in
May of 1977.

Monument(s) & Accessories Found: (Condition and Source)

Found in good condition was a Brass disc attached to a
1" iron pin. Also found was a 28" w oak now a 34", which
bears N 57° E, 112° ft. to face. An iron pin N 20° W 34.15'
was not found. We also found (two) 9" chisled "X" on both
the east and west curbs of W. Umpqua St. 1.5' north of
the south end of the curb. The west "X" bears N 1 1/2° W,
39.09 ft, the east "X" bears N 29 1/2° W, 59.09'. Also
found was a steel fence post, with survey marker 1'± from DLC cor

Monument Detail

Brass Disc.

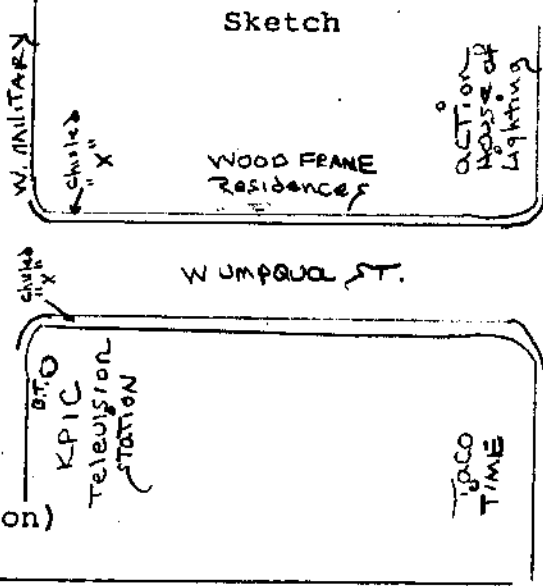

Monument Set (Procedures and Description)

New Accessories

Location & Comments

monument lies ± 3" Compass Declination
up on ditch bank @ Firm/Agency Oregon Dept
X-section of W. Umpqua of Transportation
and military ave. Address 1523 S.E. Cobb
monument lies flush Roseburg Oregon 97470
with ground, with Party Chief L. Lathrop
metal post next to Notes R. Small
DLC Corner. Witness E. Wilcox

Surveyor's Seal