

FILED

J.R.

SEP 12 1986

OREGON CORNER RESTORATION FORM

Section 13 Township 24S Range 7W

County Douglas Date 9/5/86

COUNTY SURVEYOR
DOUGLAS COUNTY, ORE.

Corner Designation

1/4 (one Quarter)

- Condition Report Only
- Not Found
- Renewed
- Unrecorded
- Surveyed In
- Referenced Out

Previous Renewals/Surveys, etc. Survey Renewed in 1973
by Bureau of Land Management, Douglas Co. Surveyors
Record, Volume 37, Page 15287

Monument(s) & Accessories Found: (Condition and Source)


Found was 2 1/2" Brass Disc on galv. Pipe in good Condition
15" above groundline. also found were 3 of 4 Recorded
Boundary Trees. First a 15" Fir, 46 1/2 lks, S 67 1/2° W.
next a 20" Fir 111 1/2 lks, N 49 1/2° E, then a
42" Fir stump (now potted) @ 10 lks, S 40° W. A
66" Fir Stump was not Relocated.

Monument Detail

2 1/2" BRASS DISC



umpqua River sketch

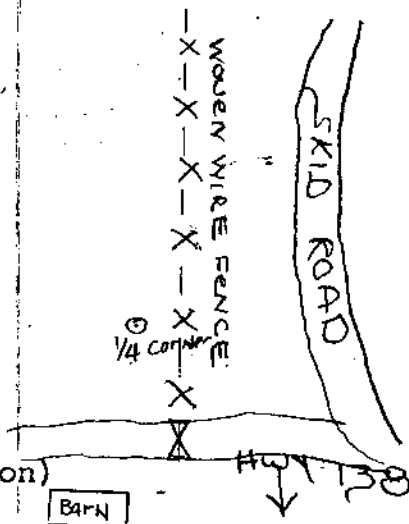

Monument Set (Procedures and Description)

New Accessories

Location & Comments

monument 40' W. of Compass Declination _____
N.S. fence. corner Firm/Agency O.D.O.T.
near hill top over _____
looking Umpqua River Address 1523 S.E. Cobb
near Tye Curve, Roseburg Oregon 97470
corner can be reached Party Chief L. Lathrop
through Feezol prop. Notes R. Small
off Hwy 138, just below Witness R. Wilcox
entering Tye Curve
from southern direction.

Surveyor's Seal

