

FILED

SEP 12 1986

OREGON CORNER RESTORATION FORM

Section 17 Township 29 S Range 8 W

COUNTY SURVEYOR
DOUGLAS COUNTY, ORE.

County Douglas Date 6/27/86

Corner Designation

~~S 1/16~~ Section 17 ~~E 1/16~~

- Condition Report Only
- Not Found
- Renewed
- Unrecorded
- Surveyed In
- Referenced Out

Previous Renewals/Surveys, etc. we could not find previous renewal @ Surveyors office.


Monument(s) & Accessories Found: (Condition and Source)

we found a 3/4" iron rod in broken down waven wire fence, near an abandoned house. we also found two bearing trees; 40" cedar bearing S 33° E, DIST. 12.5, and dated 4/62, also a 26" red fir bearing N 3° W, DIST of 30.7', and dated 4/62.

Monument Detail

Sketch

3/4" iron rod in dilapidated waven wire fence.

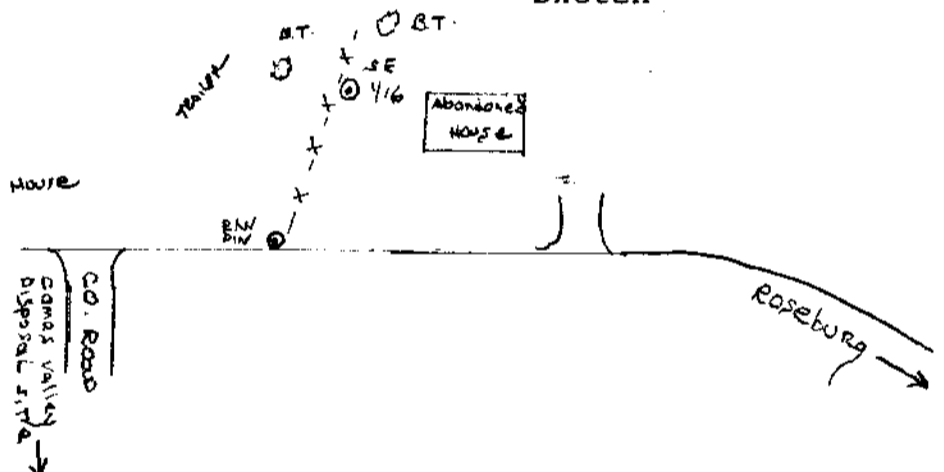

Monument Set (Procedures and Description)

New Accessories

Location & Comments

The 3/4" iron rod in broken down fence was in good condition and is elevated approx. 3" above groundline.

Compass Declination _____
 Firm/Agency Oregon Dept. of Transportation
 Address 1523 SE Cobb
 Party Chief L. Cathrop
 Notes P. small
 Witness A. Wilcox

Surveyor's Seal

