

FILED

SL

SEP 12 1986

OREGON CORNER RESTORATION FORM

Section 9 Township 29S Range 8W

COUNTY SURVEYOR
DOUGLAS COUNTY, ORE.

County Douglas Date 7/3/86

Corner Designation

CS
~~SE~~ $\frac{1}{16}$ Section 9

- Condition Report Only
- Not Found
- Renewed
- Unrecorded
- Surveyed In
- Referenced Out

Previous Renewals/Surveys, etc. None

Monument(s) & Accessories Found: (Condition and Source)


FOUND: 3" Brass CAP at $\frac{1}{16}$ corner stamped US Dept. of the Interior
 Bur. of Land Management cadastral survey S $\frac{1}{16}$ | 59 1980
 Found one Bearing tree which bears N $52\frac{1}{2}^{\circ}$ W 20 LKS with
 open scride T29 R9W
 There is a $4\frac{1}{2}$ " high Fiber glass Post along side the Brass
 cap.

Monument Detail



3" Brass CAP
5" Above ground

Sketch

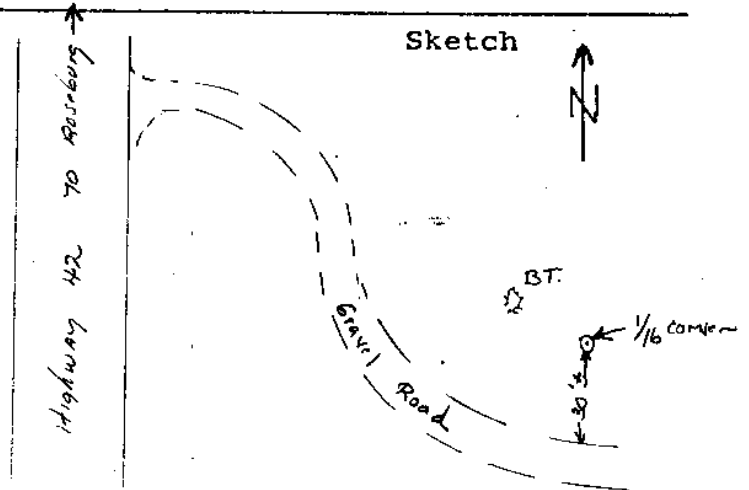

Monument Set (Procedures and Description)

New Accessories

Location & Comments

The corner lies approx.
30 feet north of a
gravel Road and is
5" above the ground

Compass Declination _____
 Firm/Agency Oregon State
Highway Div.
 Address 1523 SE COBB
Roseburg, Ore.
 Party Chief L. Lathrop
 Notes R. Small
 Witness R. Wilcox

Surveyor's Seal



C.S. File No. 63/9-15