

FILED

JS

SEP 12 1986

OREGON CORNER RESTORATION FORM

Section 2 Township 29S Range 8W

COUNTY SURVEYOR
DOUGLAS COUNTY, ORE.

County Douglas Date 7-15-86

Corner Designation

W $\frac{1}{16}$ Sec 2 (Ber. $\frac{3}{11}$)

- Condition Report Only
- Not Found
- Renewed
- Unrecorded
- Surveyed In
- Referenced Out

Previous Renewals/Surveys, etc. _____

Monument(s) & Accessories Found: (Condition and Source)


FOUND 1 IN IRON Bolt + Nut 6 IN above Ground ALSO
 FOUND the following BEARING Trees
 1 FT STUMP 6 FT TALL N 77° E 11° FT
 10 IN STUMP 6 FT TALL S 35° E 11° FT

Monument Detail



1 IN IRON Bolt
AND Nut

Sketch

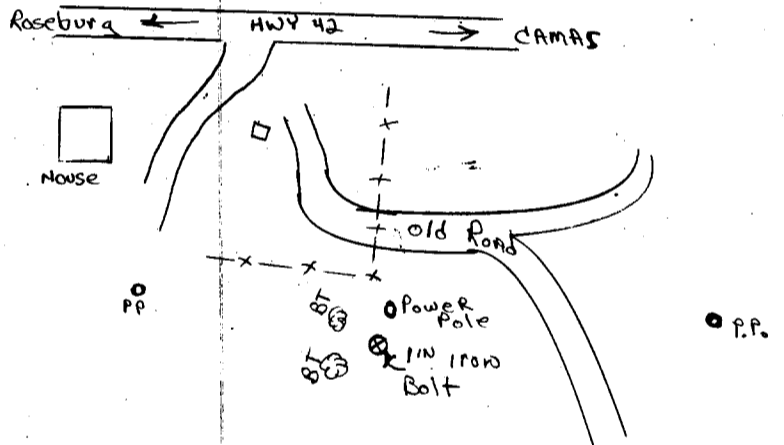

Monument Set (Procedures and Description)

New Accessories

Location & Comments

Surveyor's Seal

Compass Declination _____

Firm/Agency O.D.O.T.

Address 1523 SE COBB

Party Chief L LATHROP

Notes R Wilcox

Witness R LAPKE

REGISTERED
PROFESSIONAL
LAND SURVEYOR

Roger E. Patitz

OREGON
JULY 11, 1969
ROGER E. PATITZ
906

C.S. File No. 63/9-18