

FILED

sh

SEP 12 1986

OREGON CORNER RESTORATION FORM

Section 1-2-11-12 Township 29S Range 8W

COUNTY SURVEYOR
DOUGLAS COUNTY, ORE.

County DOUGLAS Date 7-16-86

Corner Designation

SEct Corner to 2-1-11-12

- Condition Report Only
- Not Found
- Renewed
- Unrecorded
- Surveyed In
- Referenced Out


Previous Renewals/Surveys, etc. REF # 125 JM Powell
NOV 28, 1966

Monument(s) & Accessories Found: (Condition and Source)

FOUND 2 1/2 IN BRASS CAP 7 IN ABOVE GROUND MARKED
S1/S2, T29S, R8W DATED 1924 ALSO FOUND THE FOLLOWING
BEARING TREES
40 IN STUMP NOW ROTTED N26°E 25' FT
21 IN FIR HEALED N15°W 31' FT
22 IN CEDAR N41°E 55' FT HEALED
27 IN W FIR S16°E 32' FT HEALED

Monument Detail

Sketch

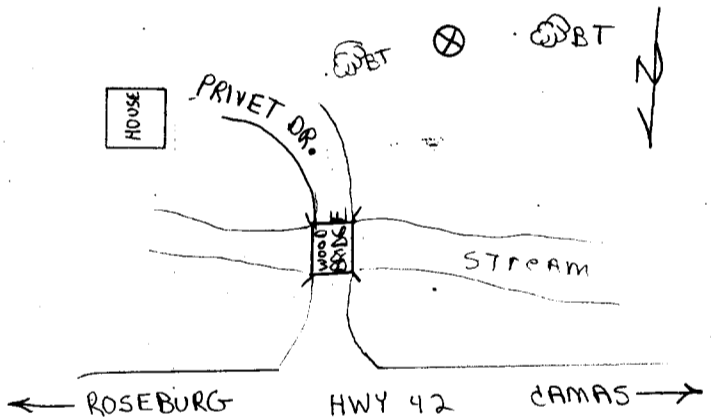

Monument Set (Procedures and Description)

New Accessories

Location & Comments

Compass Declination _____
 Firm/Agency O.D.O.T.
 Address 1523 SE COBB
 Party Chief L LATHROP
 Notes R WILCOY
 Witness R LARKE

Surveyor's Seal

