

FILED

SEP 12 1986

OREGON CORNER RESTORATION FORM

Section 10+11 Township 29S Range 8W

County DOUGLAS Date 7-14-86

COUNTY SURVEYOR
DOUGLAS COUNTY, ORE.

Corner Designation

1/4 Sect 10 AND 11



- Condition Report Only
- Not Found
- Renewed
- Unrecorded
- Surveyed In
- Referenced Out

Previous Renewals/Surveys, etc. RENEWED #60
J.W. BYRON Sept 1958

Monument(s) & Accessories Found: (Condition and Source)

FOUND 2 1/2" BRASS CAP MARKED 10/5 T29S, R8W, 1958
1 FT. ABOVE GROUND WITH PILE OF ROCKS AT BASE. ALSO FOUND
THE FOLLOWING BEARING TREES ORIG. 52" SNAG NOW
ROTTED N38°W 33 1/2 FT
FD 20" W R. FIR 576°W 61 3/4 FT TAGED
FD 10" FIR N25 1/2°E 7 LKS OPEN BLAZE

Monument Detail

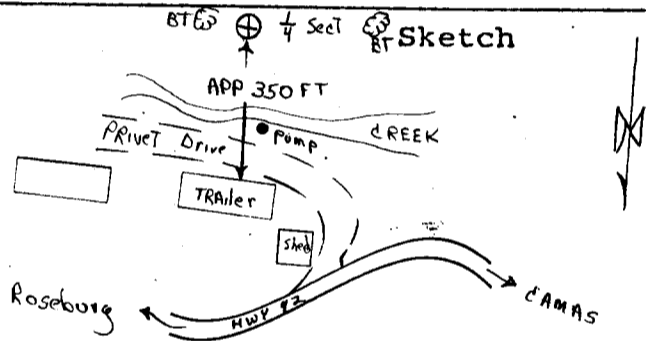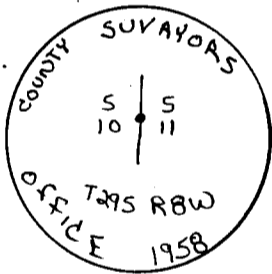

Monument Set (Procedures and Description)

New Accessories

Location & Comments

Found on North Compass Declination _____
Slope of Hill. Firm/Agency O.O.O.T.
APPROX. 350 FT.
FROM Trailer Address 1523 S E J

 _____ Party Chief R LATHROP
 _____ Notes R SMALL
 _____ Witness R WILCOX

Surveyor's Seal

