

OREGON CORNER RESTORATION FORM

FILED

SEP 12 1986

Section 17+20 Township T29S Range R8W

County Douglas Date 9-3-86

COUNTY SURVEYOR
DOUGLAS COUNTY, ORE.

Corner Designation

1/4 Sec. Cor. Between Sec 20 and Sec 17

- Condition Report Only
- Not Found
- Renewed
- Unrecorded
- Surveyed In
- Referenced Out


Previous Renewals/Surveys, etc. REN # 73 J BYRON 10-1950
See Corner NO. 14 For Bearing trees

Monument(s) & Accessories Found: (Condition and Source)

Found 1/4 Sec. cor to Sec 17+20. A 2 1/2" BRASS CAP
ON GALV. Pipe 6" Above Ground next To sawed off
Abandoned Power Pole with bearing tree tag
Monument Marked T29S R8W S17
office 1958. No Bearing Trees Noted

Monument Detail

Sketch

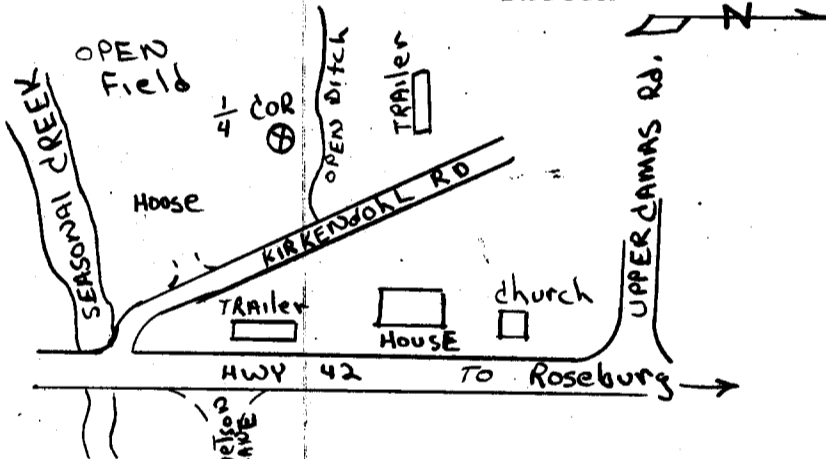

Monument Set (Procedures and Description)

New Accessories

Location & Comments

MONUMENT IN
middle of field just
west of Kirkendall
Rd, and south of
Double Wide
Trailer House

Compass Declination

Firm/Agency O.O.O.T

Address 1523 S E Cobb

Roseburg Ore

Party Chief B LATHROP

Notes R Small

Witness C Jud

Surveyor's Seal

