

FILED

NOV 28 1986

OREGON CORNER RESTORATION FORM

Section 25/30 Township 29S Range 8W

COUNTY SURVEYOR
DOUGLAS COUNTY, ORE

County DOUGLAS Date 9-26-86

Corner Designation

Sect. corner to 25+30 36+31

- Condition Report Only
- Not Found
- Renewed
- Unrecorded
- Surveyed In
- Referenced Out

Previous Renewals/Surveys, etc. REN #117 7-3-62 JAMES W BYRON


Monument(s) & Accessories Found: (Condition and Source)

FOUND A 2 1/2" BRASS CAP ON A 1 1/2" GALVANIZED PIPE 13" ABOVE
GROUND LINE. ALSO FOUND THE FOLLOWING BEARING TREES
A 6" ASH NOW 11" ASH N 5 1/2° E 43" FT WITH PARTLY OPEN SCRIBE
A 40" OAK S 88° W 210" FT BARK MISSING ONE SIDE NO SCRIBE
A 7" OAK N 21° W 45" NO VISIBLE BLAZE

Monument Detail



Sketch

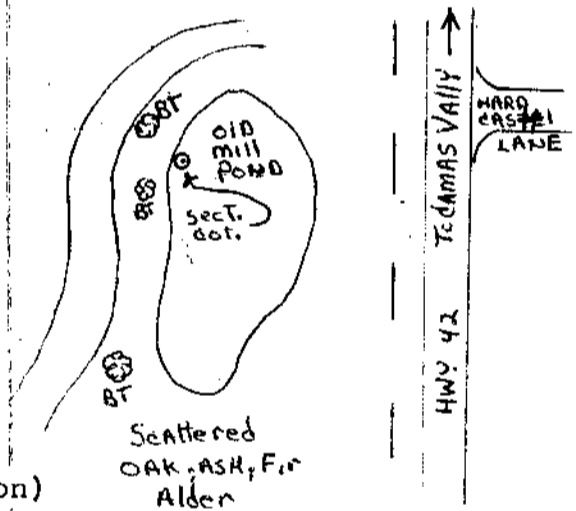

Monument Set (Procedures and Description)

New Accessories

Location & Comments

CORNER IS LOCATED
NEAR N.W. Edge of old
Abandoned log Pond
which is now Dry

Compass Declination _____

Firm/Agency O.D.O.T

Address 1523 S.E. Cobb

Roseburg Ore

Party Chief L LATHROP

Notes R SMALL

Witness R Wilcox

Surveyor's Seal

REGISTERED
 PROFESSIONAL
 LAND SURVEYOR

Roger E. Peltz

OREGON
 JULY 31, 1968
 ROGER E. PELITZ
 908