

FILED

ff

NOV 28 1986

OREGON CORNER RESTORATION FORM

Section 9+16 Township 29S Range 8W

County DOUGLAS Date 9-26-86

COUNTY SURVEYOR
DOUGLAS COUNTY, ORE.

Corner Designation

W $\frac{1}{16}$ Sect. 9+16

- Condition Report Only
- Not Found
- Renewed
- Unrecorded
- Surveyed In
- Referenced Out

Previous Renewals/Surveys, etc.

Co. Surveyors Rec. Pg # 17002


Monument(s) & Accessories Found: (Condition and Source)

FOUND @ W $\frac{1}{16}$ Between Sec 9+16 A 3rd BRASS CAP 6^{IN}
Above Ground MARKED $\frac{1}{16}$ $\frac{59}{372}$ USDEPT OF THE INTERIOR
BUR. OF LAND MA. DATED 1980. ALSO FOUND THE FOLLOWING
BEARING TREES

8 IN W. Fir N 83 $\frac{1}{4}$ W 9 $\frac{1}{2}$ LKS WITH TAG
8 IN W. Fir S 88 $\frac{1}{2}$ E 20 LKS MOSTLY HEALED BLAZE

Monument Detail

Sketch

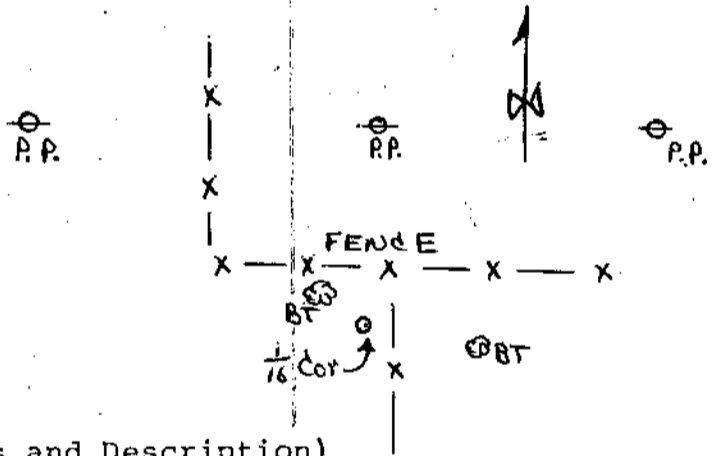

Monument Set (Procedures and Description)

New Accessories

Location & Comments

Surveyor's Seal

Compass Declination _____
 Firm/Agency O. O. O. T.

Address 1523 S.E. COBB
Roseburg Ore
 Party Chief L. LATHROP
 Notes C. Judd
 Witness R. Wilcox

REGISTERED
PROFESSIONAL
LAND SURVEYOR

Roger E Patitz

OREGON
JULY 11, 1988
ROGER E. PATITZ
908