

FILED

NOV 28 1986

OREGON CORNER RESTORATION FORM

Section 9 Township T29S Range 8W

County DOUGLAS Date 9-26-86

COUNTY SURVEYOR  
DOUGLAS COUNTY, ORE.

Corner Designation

CENTER  $\frac{1}{4}$  Sect 9

- Condition Report Only
- Not Found
- Renewed
- Unrecorded
- Surveyed In
- Referenced Out

Previous Renewals/Surveys, etc. BLM VOL 44 PG 17010


Monument(s) & Accessories Found: (Condition and Source)

FOUND CENTER  $\frac{1}{4}$  SECT 9 A 3IN BRASS CAP MARKED C $\frac{1}{4}$ S9  
T29S RBW US Dept. of The Interior BUREAU OF LAND MANAGEMENT  
4" Above Ground Also Found The Following Bearing Trees

11" Fir N 57 $\frac{3}{4}$  E 24 $\frac{1}{2}$  FT Dated 6/80 (37 lks)  
9" Fir S 7 $\frac{1}{4}$  W 27 $\frac{1}{2}$  FT Dated 6/80 (41 lks)

Monument Detail

Sketch

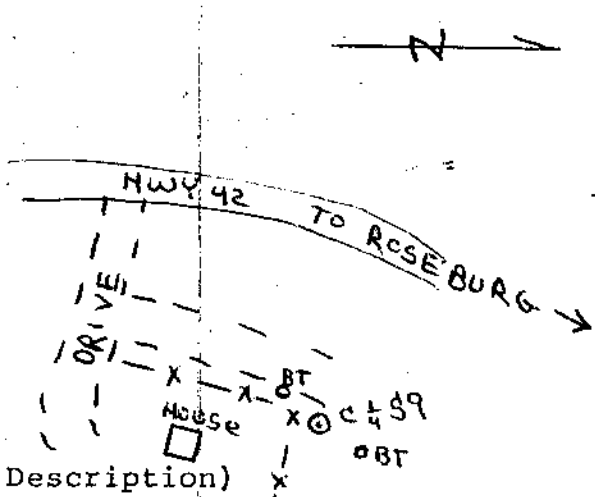

Monument Set (Procedures and Description)

New Accessories

Location & Comments

Surveyor's Seal

Compass Declination \_\_\_\_\_

Firm/Agency ODOT

Address 1535 SE COBB

Roseburg Ore

Party Chief L LAMROP

Notes R SMALL

Witness R Wilcox

REGISTERED  
PROFESSIONAL  
LAND SURVEYOR

*Roger E. Patitz*

OREGON  
JULY 11, 1989  
ROGER E. PATITZ  
908