

FILED

NOV 28 1986

OREGON CORNER RESTORATION FORM

Section _____ Township T29S Range R8W

COUNTY SURVEYOR
DOUGLAS COUNTY, ORE.

County DOUGLAS Date 9-26-86

Corner Designation

OLD CORNER To Old 42+43+44

- Condition Report Only
- Not Found
- Renewed
- Unrecorded
- Surveyed In
- Referenced Out

Previous Renewals/Surveys, etc. BLM VOL 33 Pg. 13886

Monument(s) & Accessories Found: (Condition and Source)

FOUND 3" BRASS CAP 5" Above Ground MARKED

OLD 42 / OLD 43 U.S. Dept. of the INTERIOR BUREAU OF LAND
MANAGEMENT DATED 1965


ALSO FOUND The Following Bearing Trees

A 16" Ash S 19° W 102 IKS NO BLAZE Visible

A 43" Ash N 43° E 101 IKS SCAR Visible

Monument Detail

Sketch

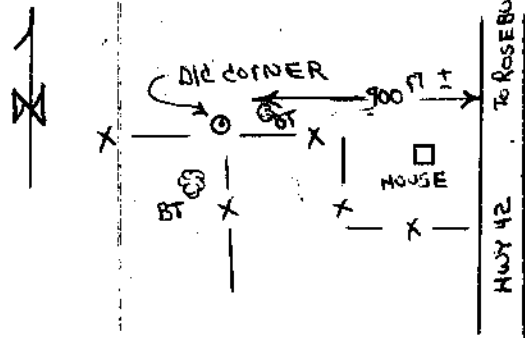

Monument Set (Procedures and Description)

New Accessories

Location & Comments

Surveyor's Seal

Compass Declination _____

Firm/Agency O.D.O.T.

Address 1523 S.E. COBB

Roseburg Ore

Party Chief L. Lathrop

Notes R. Small

Witness R. Wilcox

REGISTERED
PROFESSIONAL
LAND SURVEYOR

Roger E. Pattiz

OREGON
JULY 31, 1988
ROGER E. PATTIZ
508