

1798-74

FILED  
RECEIVED *JH*  
NOV 5 1985

OREGON CORNER RESTORATION FORM


Section 12 Township 22S Range 8W

County Douglas Date 6-27-85

COUNTY SURVEYOR  
DOUGLAS COUNTY, ORE.

Corner Designation

South  $\frac{1}{4}$  Corner  
Section 12

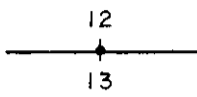

- Condition Report Only
- Not Found
- Renewed
- Unrecorded
- Surveyed In
- Referenced Out


Previous Renewals/Surveys, etc. G.L.O. Survey by Harvey Gordon and Charles Gardner in 1856 and G.L.O. Survey by William Byars in 1881. Renewals by Floyd Cole in 1913 and by Milo Godfrey in 1962

Monument(s) & Accessories Found: (Condition and Source)

Found 1962 Douglas County Brass Cap set firmly in ground.  
15" Oak, S18W, 43.4' (Scar Vis.), 1962 C.S.BT. Rec. S17 $\frac{1}{2}$ W, 43.7'  
16" Fir, N09W, 38.1' (Scar Vis.), 1962 C.S.BT. Rec. N09W, 38.3'  
East-West-North Fence Corner Bears S60W, 13.7'

Monument Detail

16" FIR  
1962 B.T.

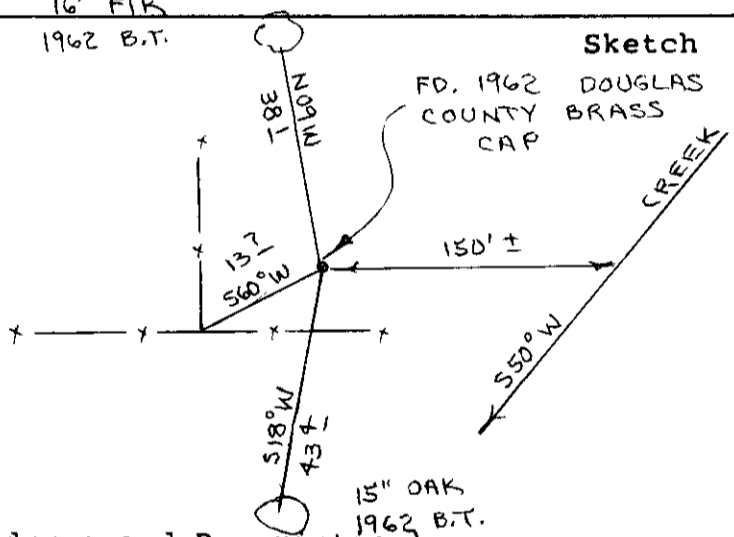

Monument Set (Procedures and Description)

New Accessories


Set metal fence post, with survey attention sign wired to,  
beside brass cap.

Location & Comments

Corner lies on flat  
ground about 150'  
West of small creek.

Compass Declination 20 $\frac{1}{2}$   
Firm/Agency Roberts  
Surveying Inc.  
Address 29 West 29th St.  
Eugene, Oregon 97405  
Party Chief Les Roberts  
Notes Ted Baker  
Witness \_\_\_\_\_

Surveyor's Seal

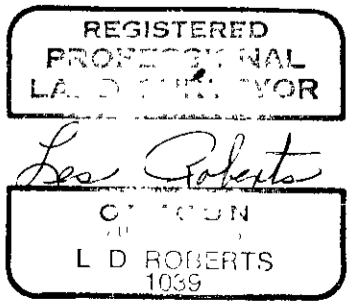

M 90-74

FILED  
RECEIVED *ZH*  
NOV 5 1985

OREGON CORNER RESTORATION FORM


Section 12 Township 22S Range 8W

County Douglas Date 6-27-85

COUNTY SURVEYOR  
DOUGLAS COUNTY, ORE.

Corner Designation

East  $\frac{1}{4}$  Corner  
Section 12

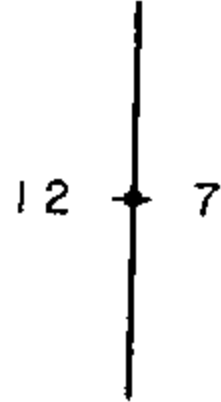

- Condition Report Only
- Not Found
- Renewed
- Unrecorded
- Surveyed In
- Referenced Out


Previous Renewals/Surveys, etc. G.L.O. Surveys by Harvey Gordon & Charles Gardner in 1856 and by William Byars in 1881. Survey M6-7 by Ben Irving in 1929 and Renewal by Milo Godfrey in 1962.

Monument(s) & Accessories Found: (Condition and Source)

Found 1962 Douglas County Brass Cap set firmly in ground. 34" Fir, S40° 27'15"E., 755.5' (scar vis.), No record.

Monument Detail

Sketch

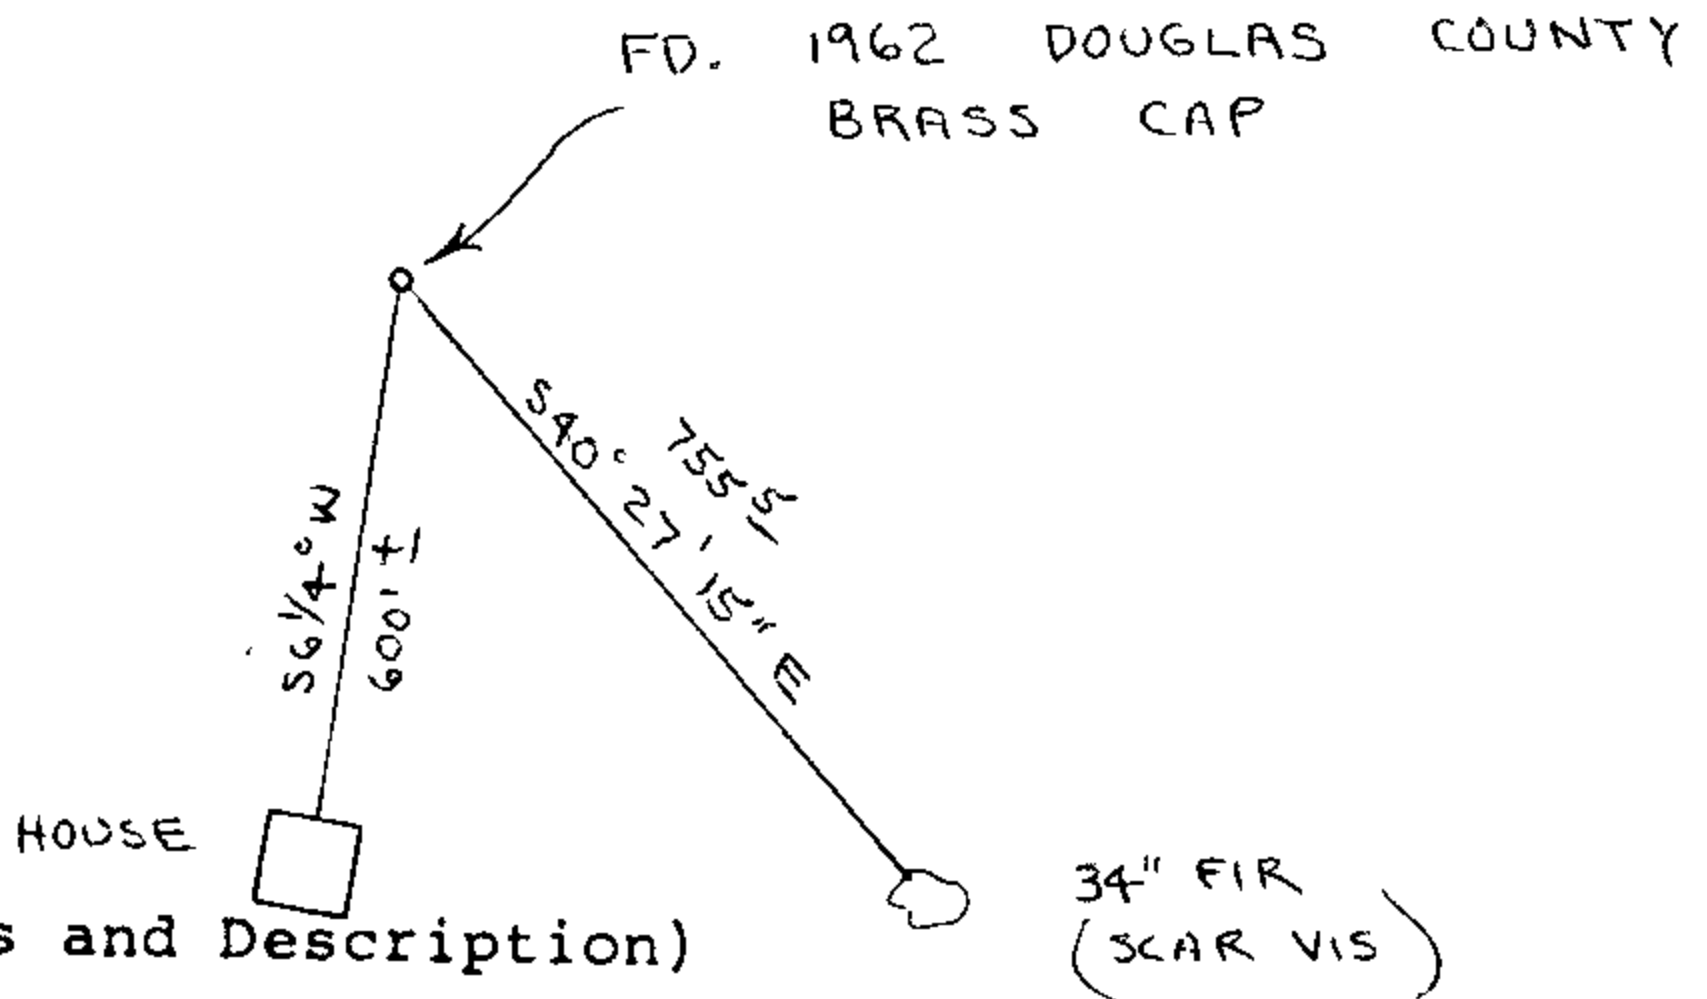

Monument Set (Procedures and Description)


New Accessories

Set metal fence post, with survey attention sign wired to, beside brass cap.

Location & Comments

Corner lies on grassy slope. Farm House Bears S6  $\frac{1}{4}$  W, 600' Compass Declination 20  $\frac{1}{2}$   
Firm/Agency Roberts Surveying Inc.  
Address 29 West 29th St. Eugene, Oregon 97405  
Party Chief Les Roberts  
Notes Ted Baker  
Witness

Surveyor's Seal

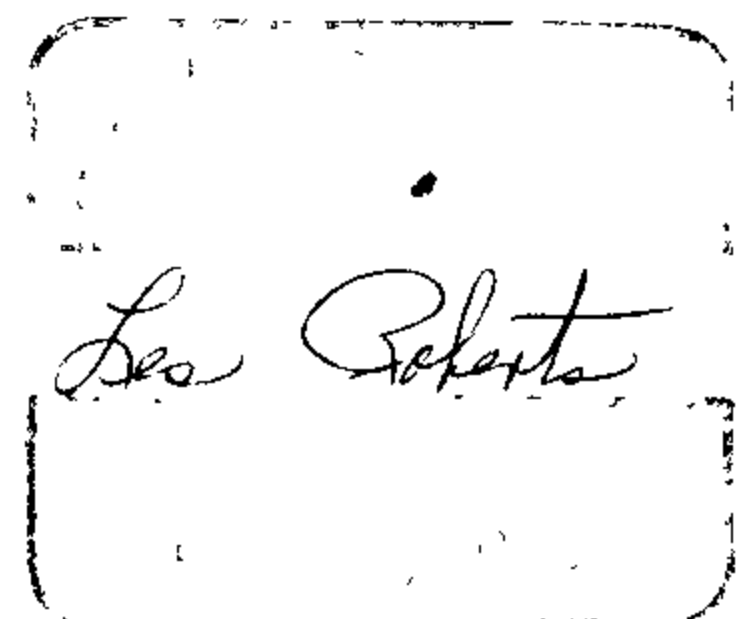

M 90-7A

FILED  
RECEIVED *ZR*

NOV 5 1985

OREGON CORNER RESTORATION FORM


Section 12 Township 22S Range 8W

County Douglas Date 7-02-85

COUNTY SURVEYOR  
DOUGLAS COUNTY, ORE.

Corner Designation

North  $\frac{1}{4}$  Corner  
Section 12

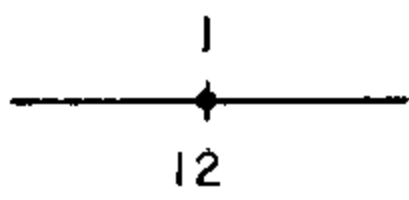


- Condition Report Only
- Not Found
- Renewed
- Unrecorded
- Surveyed In
- Referenced Out

Previous Renewals/Surveys, etc. G.L.O. Survey by William Byars in 1881 and Survey M6-7 by Ben Irving in 1929.

Monument(s) & Accessories Found: (Condition and Source)

- 29" Hemlock, N32E, 58.1' (Scar Vis.), 1929 C.S.BT.
- 48" Downed Fir, S05W, 11.9' (Bark Scribed), 1929 C.S.BT.
- 4" x 6" x 20" Sandstone set by Ben Irving was not found.

Monument Detail

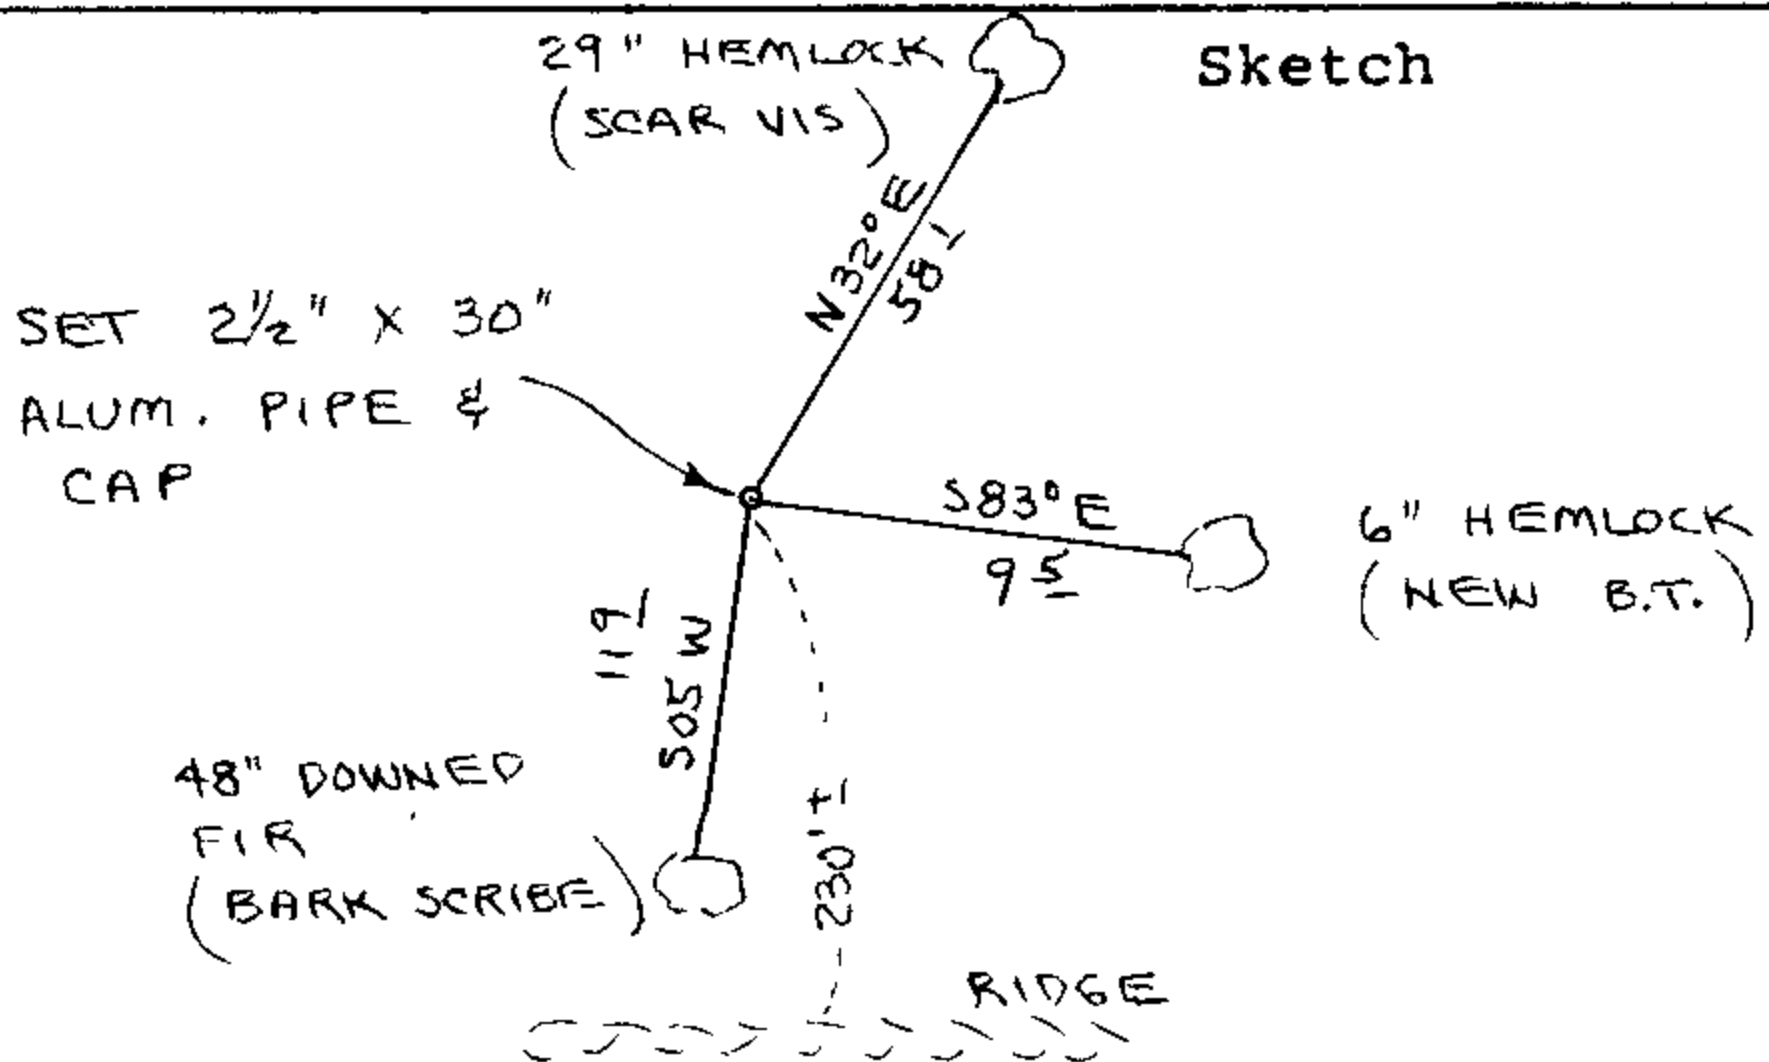

Monument Set (Procedures and Description)

Set 2 1/2" x 30" Aluminum Pipe and Cap. Purple Magnetic Marker buried Under Aluminum Pipe. Set metal fence post, with land survey monument sign wired to, beside aluminum cap.

New Accessories

6" Hemlock, S83E, 9.5' (Scribed/Painted Red)

Location & Comments

Corner lies about 230 feet North of East-West Ridge.

Compass Declination 20 1/2

Firm/Agency Roberts Surveying Inc.


Address 29 West 29th St. Eugene, Oregon 97405

Party Chief Ted Baker

Notes \_\_\_\_\_

Witness Stu Duce

Surveyor's Seal

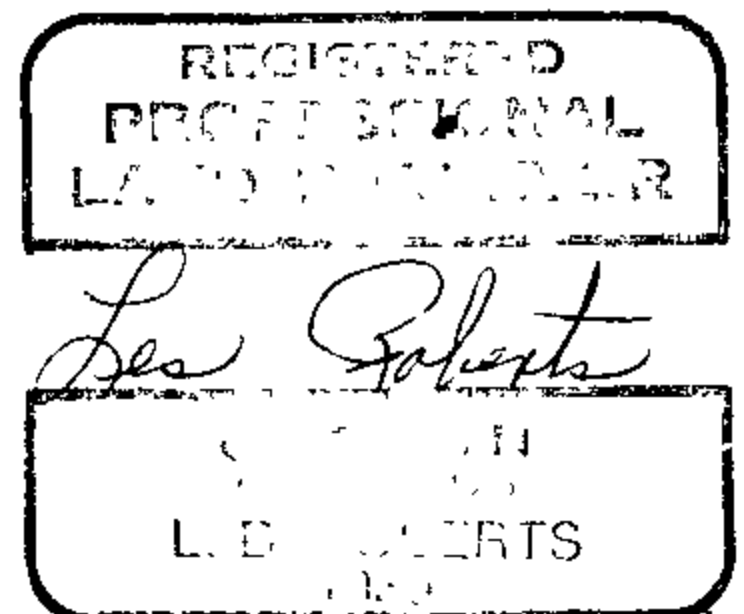

#156 ✓

C.S. File No. 63/1824

M 90-7A

FILED  
RECEIVED *SR*


OREGON CORNER RESTORATION FORM  
Section 12 Township 22S Range 8W  
County Douglas Date 7-03-85

NOV 5 1985

COUNTY SURVEYOR  
DOUGLAS COUNTY, ORE.

Corner Designation

West  $\frac{1}{4}$  Corner  
Section 12

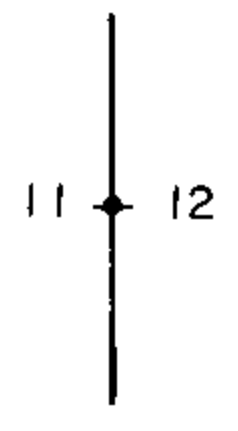

- Condition Report Only
- Not Found
- Renewed
- Unrecorded
- Surveyed In
- Referenced Out


Previous Renewals/Surveys, etc. G.L.O. Survey by William Byars in 1881 and Cadastral Survey by Floyd Brooks and Peter Peterson in 1967.

Monument(s) & Accessories Found: (Condition and Source)

Found 1967 B.L.M. Brass Cap set Firmly in Ground.  
9" Fir, N24W, 22.5' (Scar Vis.), 1967 BT. Rec. N25W, 22.4'  
12" Fir, S49E, 48.3' (Scar Vis.), 1967 BT. Rec. S49E, 47.5'

Monument Detail

9" FIR  
(SCAR VIS)

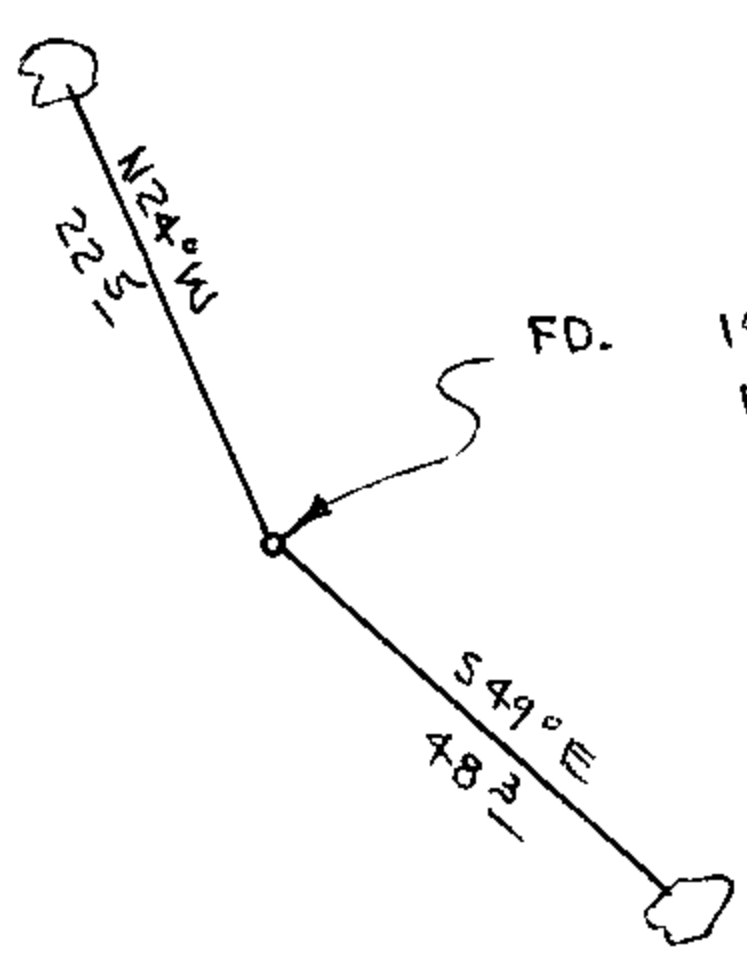

Sketch

Monument Set (Procedures and Description)


New Accessories

Set Metal Fence Post, with Survey Attention Sign Wired to, beside Brass Cap.

Location & Comments

Corner lies on steep East slope about 200 feet from top of flat ridge, Compass Declination 20 1/2  
Firm/Agency Roberts Surveying Inc.  
Address 29 West 29th St. Eugene, Oregon 97405  
Party Chief Ted Baker  
Notes  
Witness Stu Duce

Surveyor's Seal

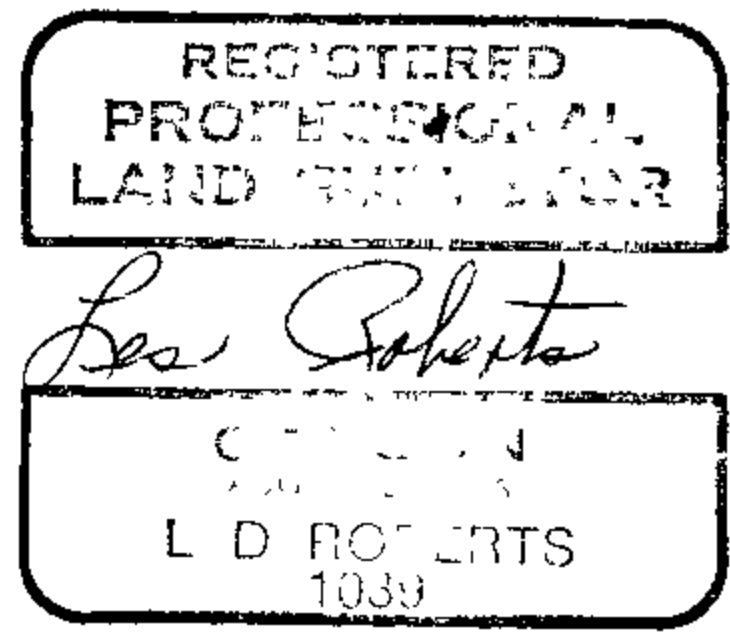

M 90-7A

FILED  
RECEIVED *JK*

OREGON CORNER RESTORATION FORM

NOV 5 1985


Section 12 Township 22S Range 8W

COUNTY SURVEYOR  
DOUGLAS COUNTY, ORE.

County Douglas Date 7-12-85

Corner Designation

S.W. Corner  
Section 12

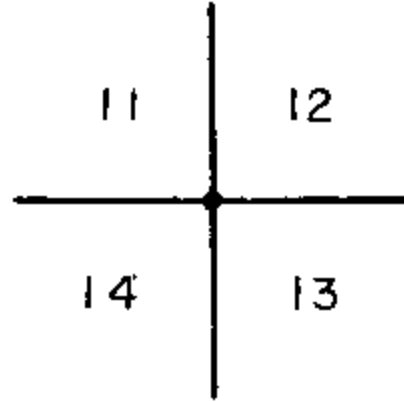

- Condition Report Only
- Not Found
- Renewed
- Unrecorded
- Surveyed In
- Referenced Out


Previous Renewals/Surveys, etc. G.L.O. Surveys by Harvey Gordon & Charles Gardner in 1856 and by William Byars in 1881. Renewal by Milo Godfrey in 1962.

Monument(s) & Accessories Found: (Condition and Source)

Found 1962 Douglas County Brass Cap set firmly in ground.

- 48" Fir Snag, N70W, 17.4' (Face Vis.), 1856 BT. Rec. N70W, 15.8'
- 7" Maple, N80W, 30.9' (Scar Vis.), 1962 C.S. BT. Rec. N79 1/2 W, 31.2'
- 12" Maple, S85W, 45.2' (Scar Vis.), 1962 C.S. BT. Rec. S87W, 45.7'
- 18" Alder, S62E, 34.7' (Scar Vis.), 1962 C.S. BT. Rec. S62E, 34.1'
- 18" Fir, N53E, 14.8' (Scar Vis.), 1962 C.S. BT. Rec. N52E, 14.9'

Monument Detail

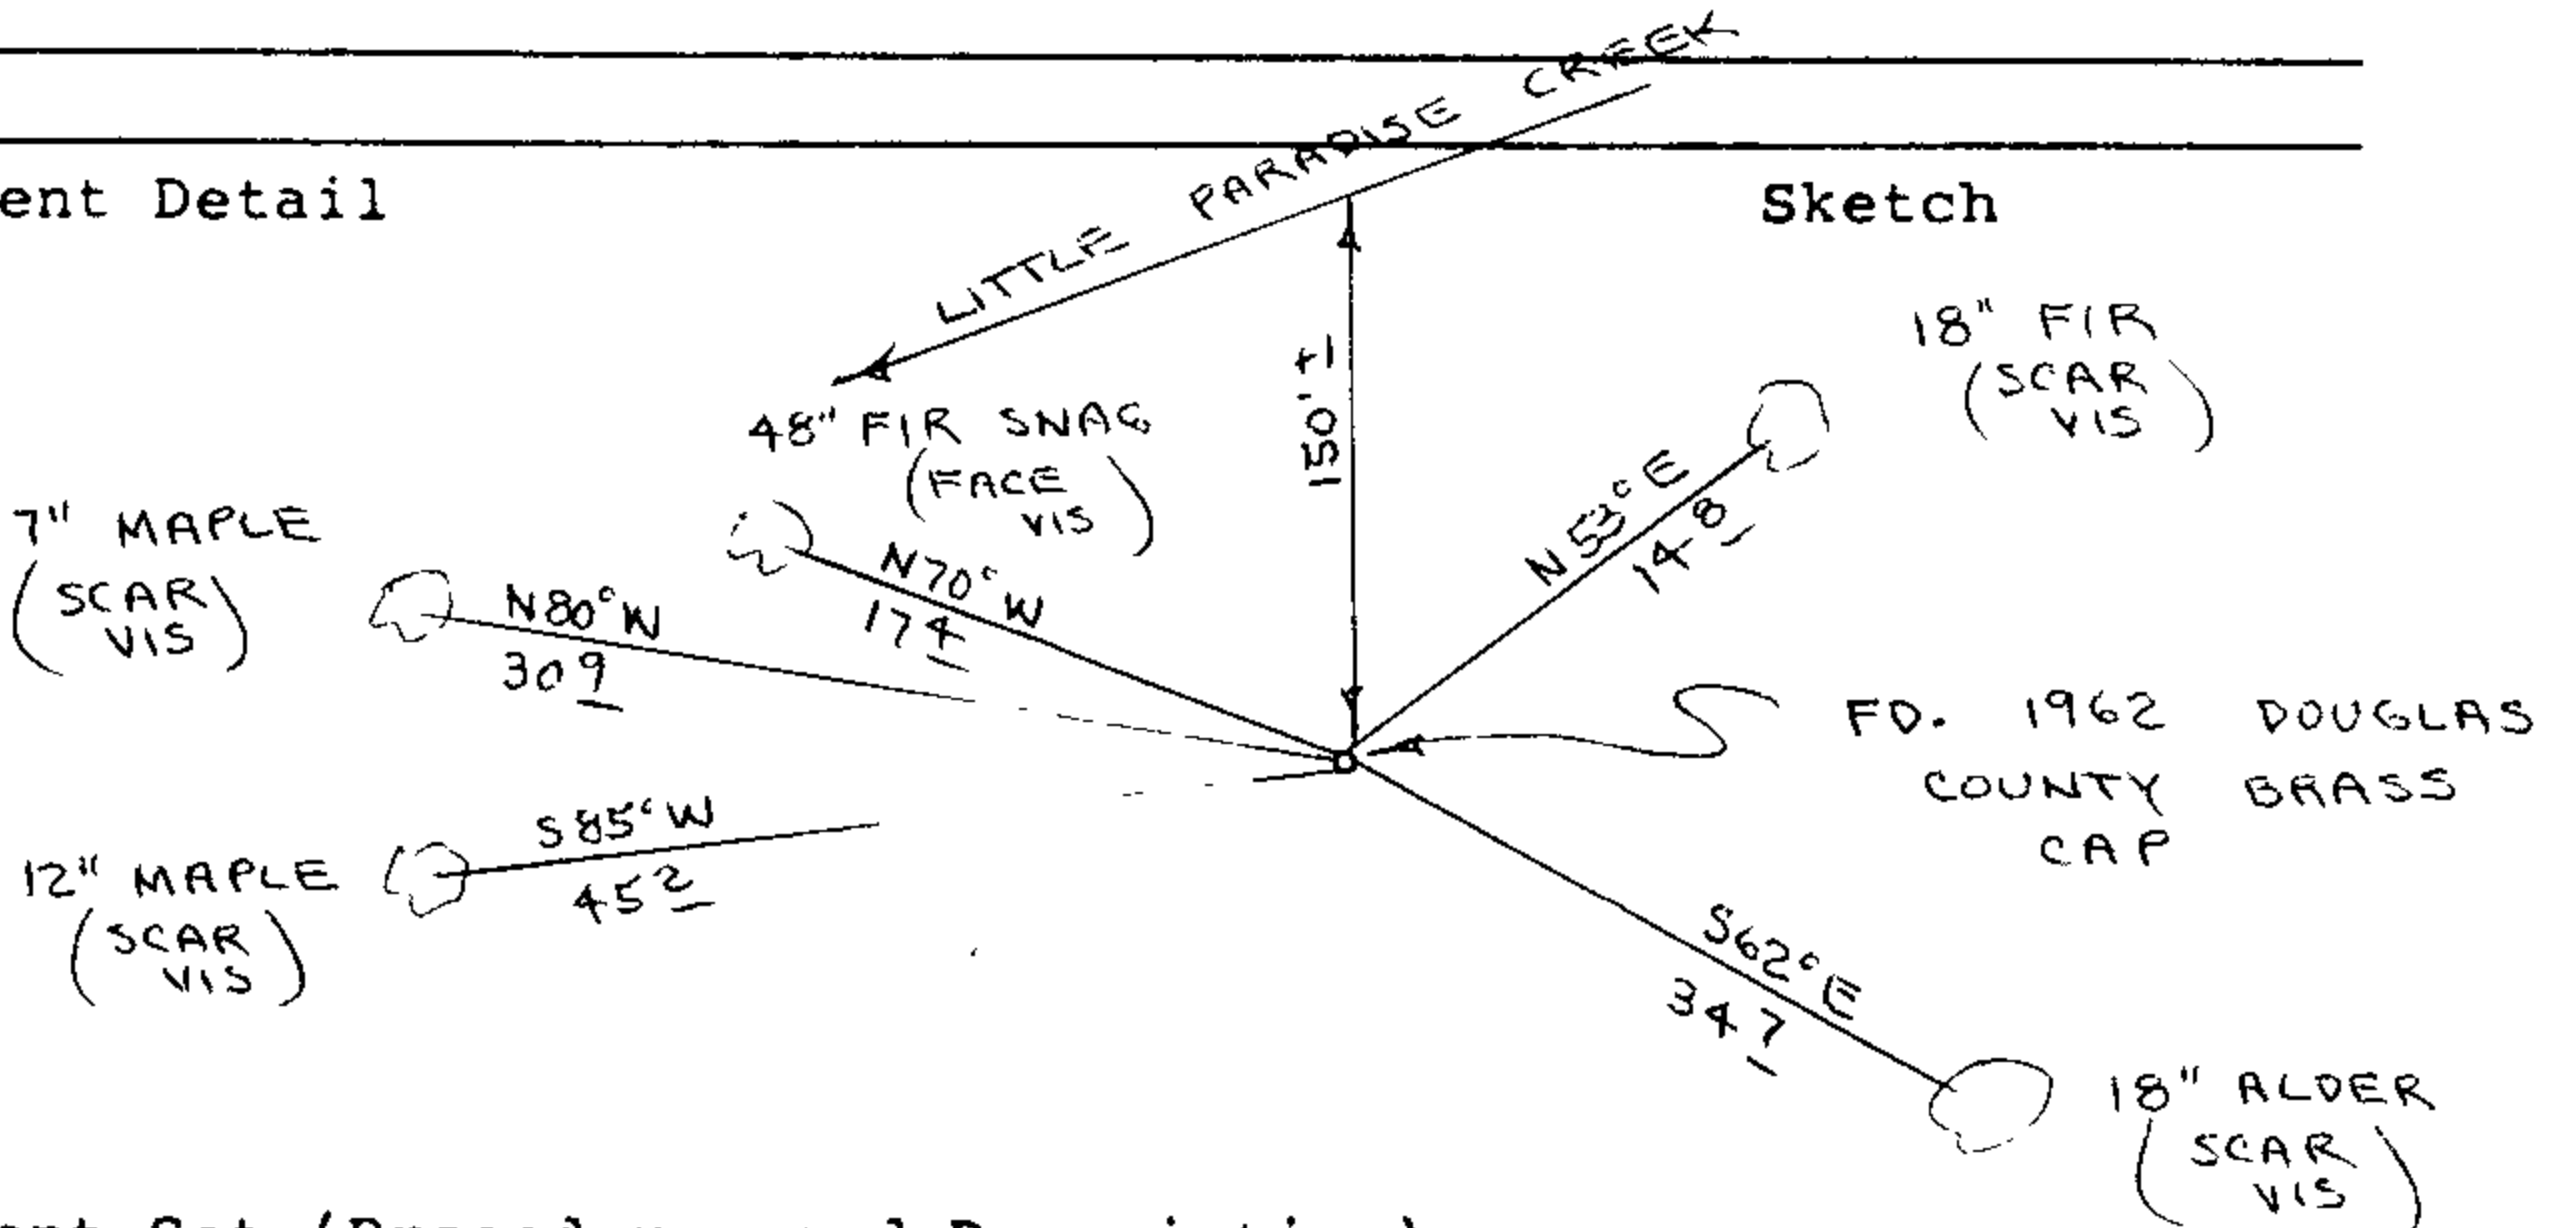

Monument Set (Procedures and Description)

\_\_\_\_\_  
 \_\_\_\_\_  
 \_\_\_\_\_  
 \_\_\_\_\_

New Accessories


Set metal fence post, with survey attention sign wired to, beside brass cap.

\_\_\_\_\_  
 \_\_\_\_\_

Location & Comments

Corner lies on steep N.W. slope about 150 feet above Little Paradise Creek  
Compass Declination 20 1/2  
Firm/Agency Roberts Surveying Inc.  
Address 29 West 29th St. Eugene, Oregon 97405  
Party Chief Ted Baker  
Notes  
Witness Stu Duce

Surveyor's Seal

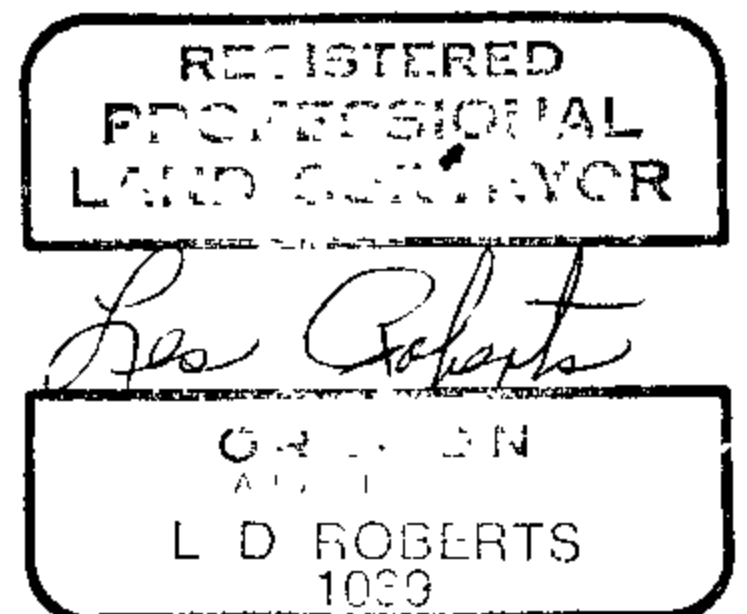

C.S. File No 63/18-4e

M 90-74

FILED

RECEIVED

NOV 5 1985

OREGON CORNER RESTORATION FORM


Section 12 Township 22S Range 8W

County Douglas Date 7-05-85

COUNTY SURVEYOR  
DOUGLAS COUNTY, ORE.

Corner Designation

N.E. Corner  
Section 12

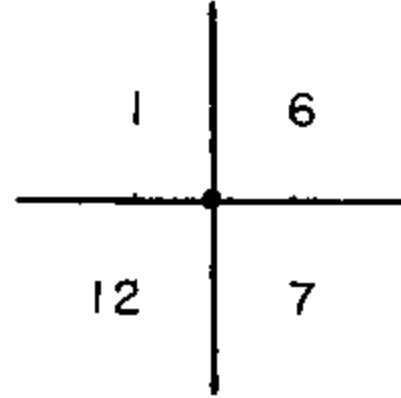


- Condition Report Only
- Not Found
- Renewed
- Unrecorded
- Surveyed In
- Referenced Out

Previous Renewals/Surveys, etc. G.L.O. Surveys by Harvey Gordon & Charles Gardner in 1856 and by William Byars in 1881. Survey M6-7 by Ben Irving in 1929 and Renewal by Godfrey in 1962. Also 1968 Cad-  
Monument(s) & Accessories Found: (Condition and Source) astral Survey.

Found 1968 B.L.M. Brass Cap set firmly in ground.

35" Fir	N06W, 15.7' (Scar Vis.)	1856 BT. Rec. N15W, 15.8'
44" Fir	S48E, 29.4' (Bark Scribed)	1856 BT. Rec. S42E, 27.7'
58" Fir Snag	S43W, 19.4' (Bark Scribed)	1856 BT. Rec. S42W, 23.1'
22" Hemlock	N40E, 49.4' (Scar Vis.)	1962 BT. Rec. N39E, 48.7'
10" Hemlock	S21E, 13.5' (Scar Vis.)	1968 BT. Rec. S22E, 13.9'

Monument Detail

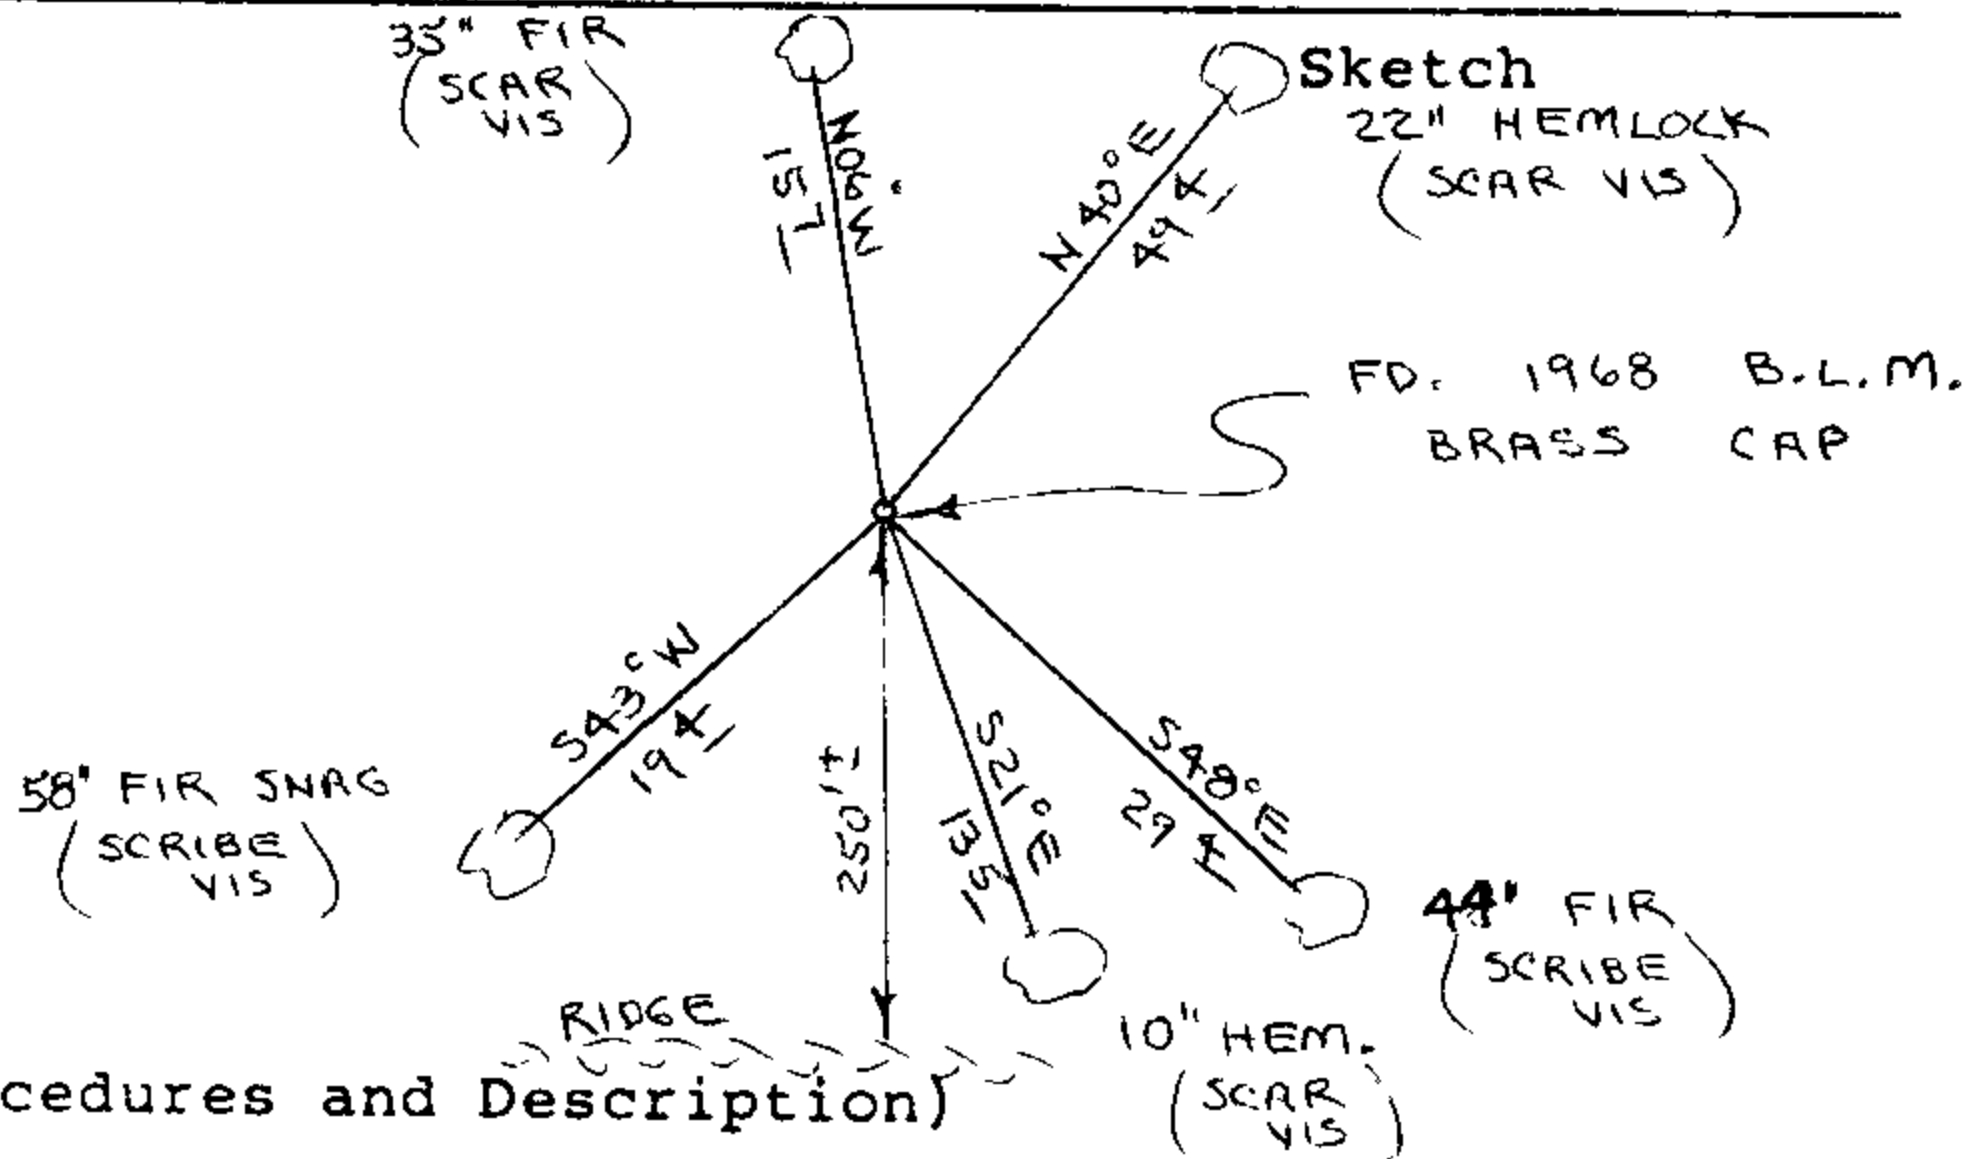

Monument Set (Procedures and Description)


New Accessories

Set metal fence post, with survey attention sign wired to, beside brass cap.

Location & Comments

Corner lies on very steep North slope about 250 feet North of flat ridge. Compass Declination 20 1/2  
 Firm/Agency Roberts Surveying Inc.  
 Address 29 West 29th St. Eugene, Oregon 97405  
 Party Chief Ted Baker  
 Notes \_\_\_\_\_  
 Witness Stu Duce

Surveyor's Seal

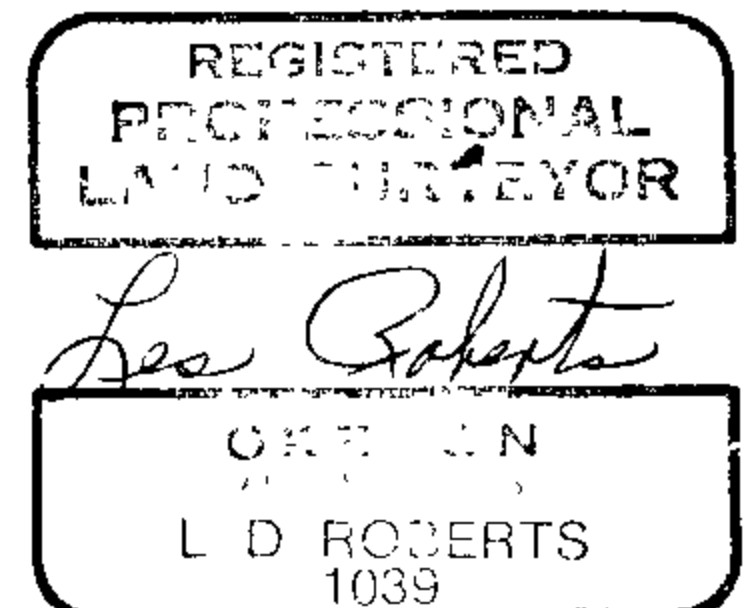

1790.74

FILED  
RECEIVED *sh*

OREGON CORNER RESTORATION FORM

NOV 5 1985


Section 12 Township 22S Range 8W

COUNTY SURVEYOR  
DOUGLAS COUNTY, ORE.

County Douglas Date 8-07-85

Corner Designation

East 1/16 Corner  
North Line  
Section 12

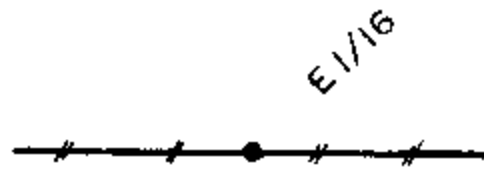


- Condition Report Only
- Not Found
- Renewed
- Unrecorded
- Surveyed In
- Referenced Out

Previous Renewals/Surveys, etc. None

Monument(s) & Accessories Found: (Condition and Source)

Monument Detail

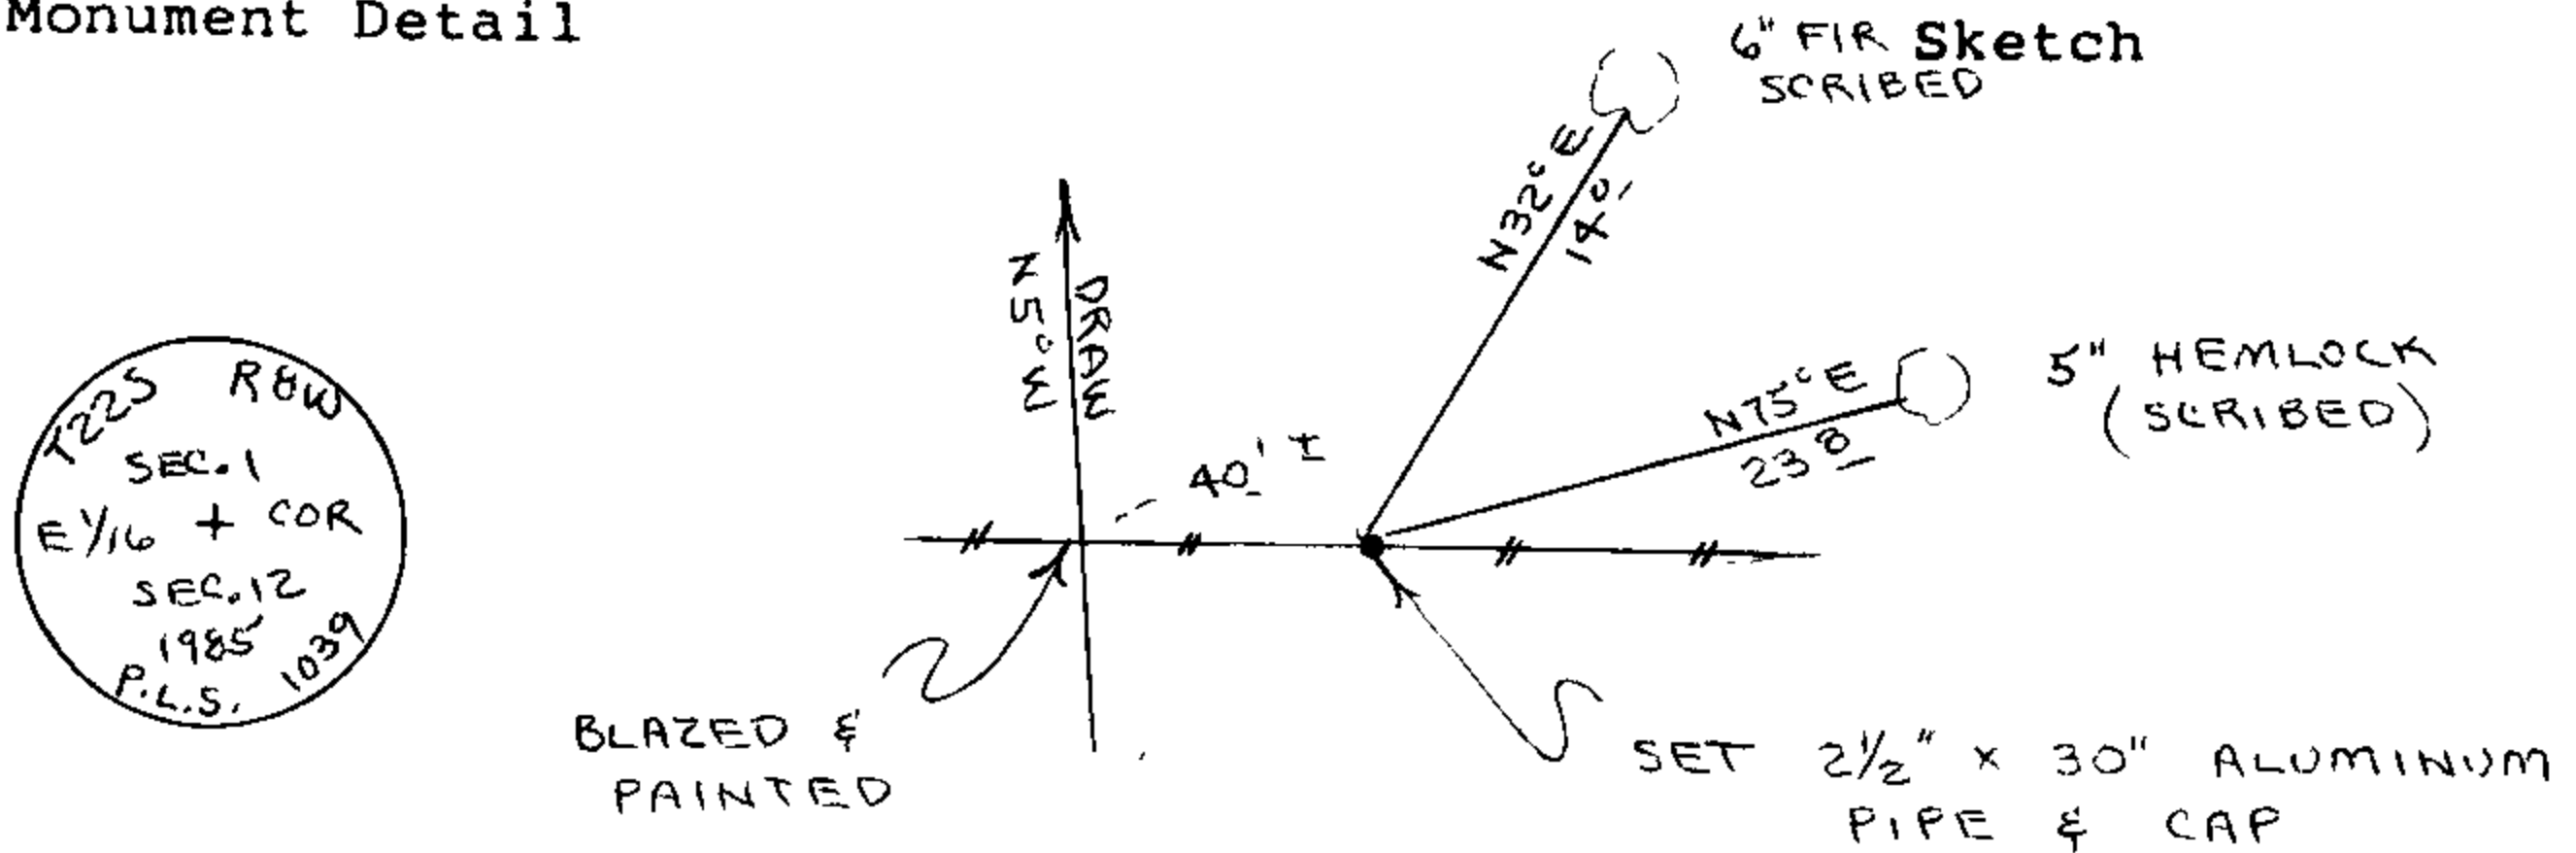

Monument Set (Procedures and Description)

Set 2 1/2" x 30" Aluminum Pipe and Cap. Purple Magnetic Marker  
Buried Under Aluminum Pipe. Set metal fence post, with land  
survey monument sign wired to, beside aluminum pipe. See filed  
survey for procedures.


New Accessories

- 5" Hemlock, N75E, 23.8' (Scribed/Painted Red)
- 6" Fir, N32E, 14.0' (Scribed/Painted Red)

Location & Comments

Corner lies on steep North slope about 40' East of small draw. Compass Declination 20 1/2  
Firm/Agency Roberts Surveying Inc.  
Address 29 West 29th St. Eugene, Oregon 97405  
Party Chief Ted Baker  
Notes  
Witness Stu Duce

Surveyor's Seal

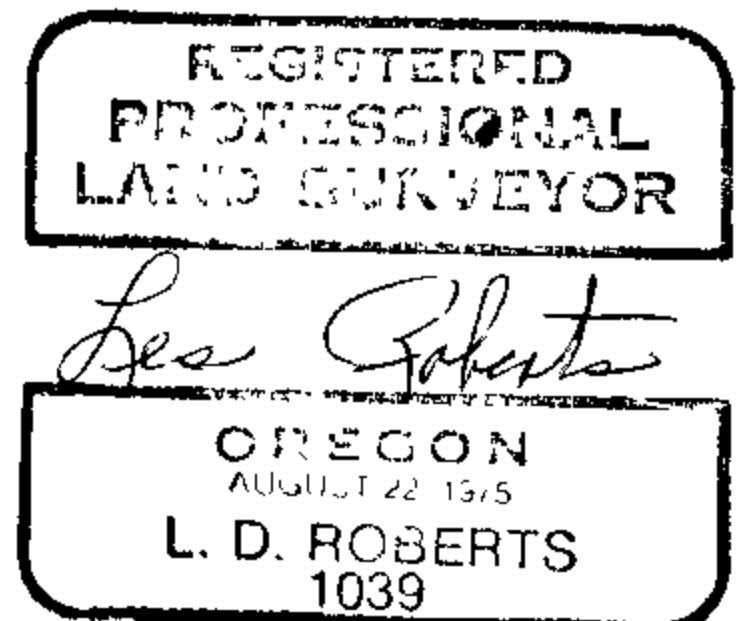

C.S. File No. 63/18-46

1790-74

FILED  
RECEIVED *rk*

NOV 5 1985


OREGON CORNER RESTORATION FORM

Section 12 Township 22S Range 8W  
County Douglas Date 8-07-85

COUNTY SURVEYOR  
DOUGLAS COUNTY, ORE.

Corner Designation

C.N. 1/16 Corner  
Section 12

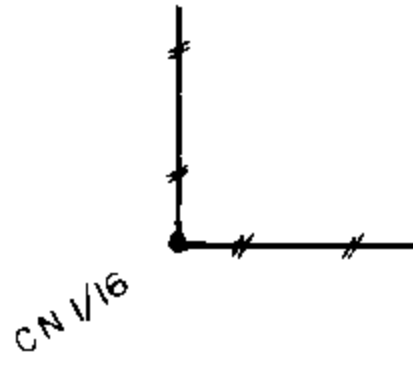


- Condition Report Only
- Not Found
- Renewed
- Unrecorded
- Surveyed In
- Referenced Out

Previous Renewals/Surveys, etc. None

Monument(s) & Accessories Found: (Condition and Source)

Monument Detail

Sketch

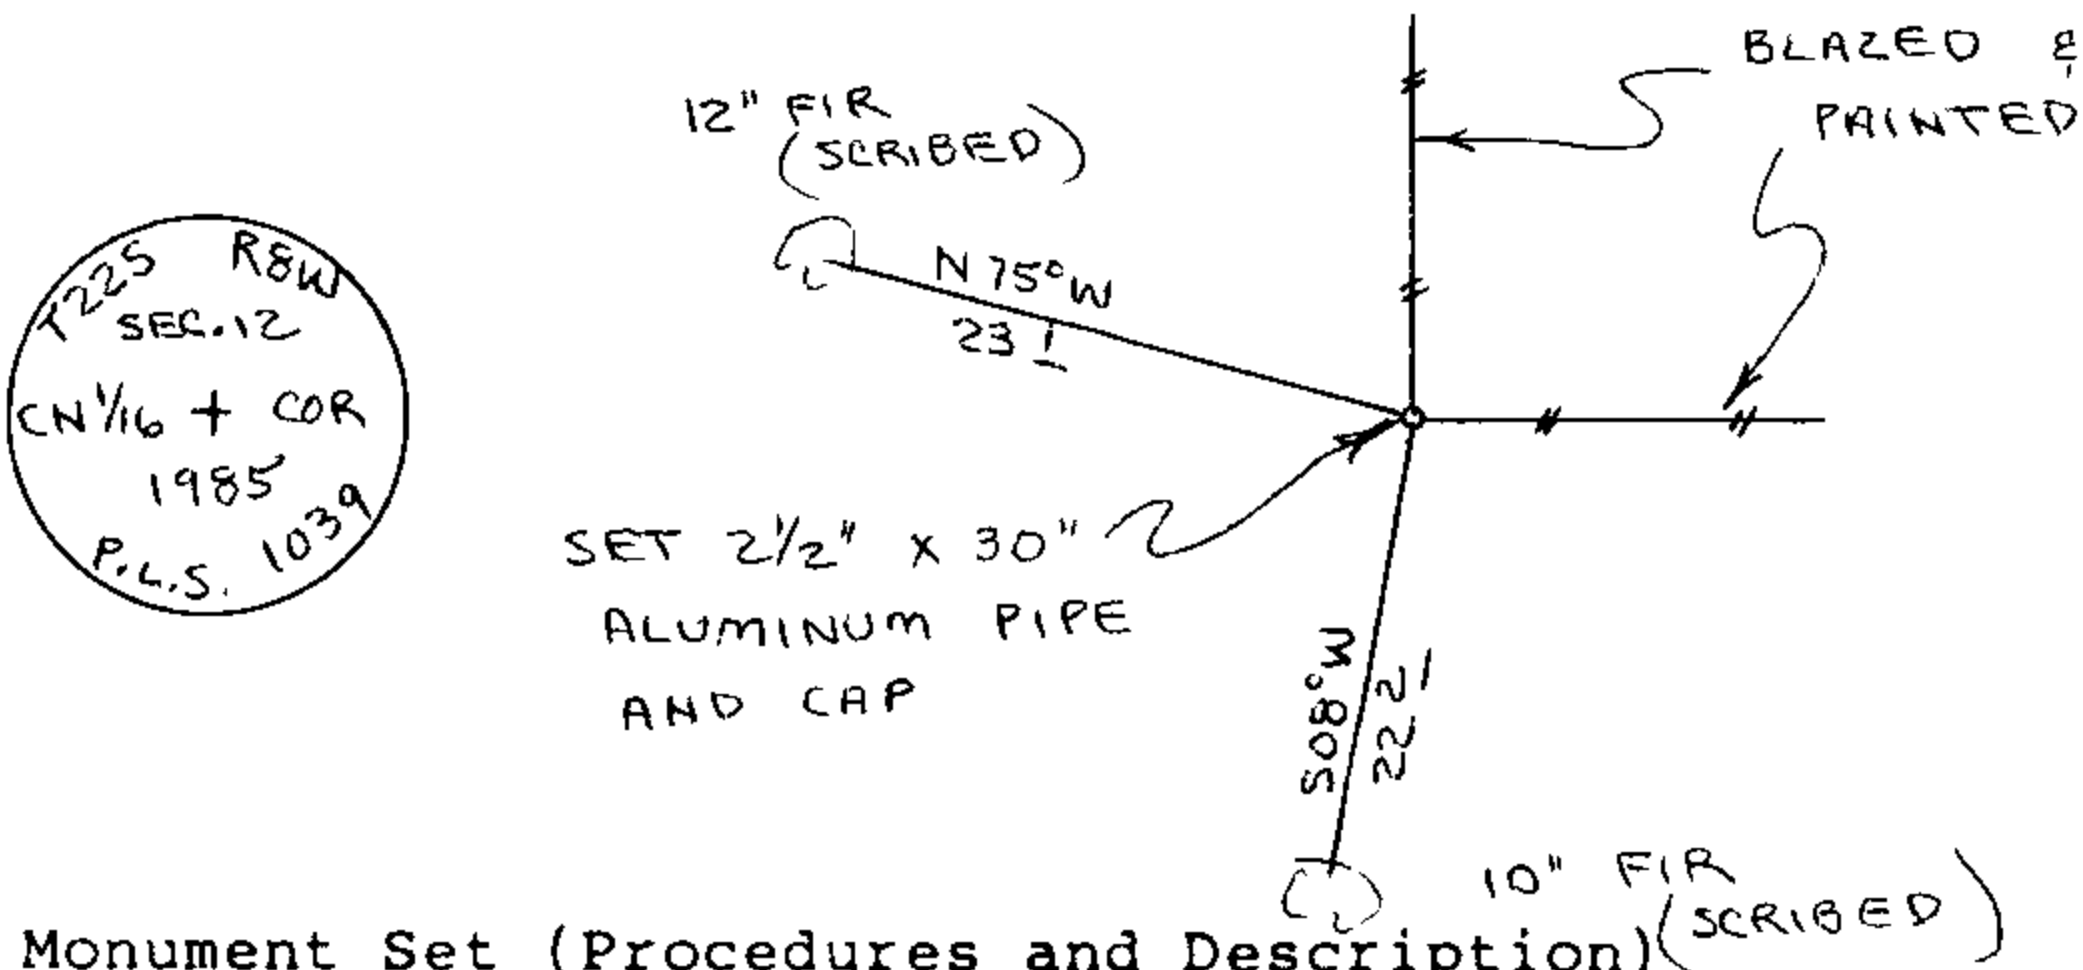

Monument Set (Procedures and Description)

Set  $2\frac{1}{2}$ " x 30" Aluminum Pipe and Cap. Purple Magnetic Marker Buried under Aluminum Pipe. Set metal fence post, with land survey monument sign wired to, beside aluminum pipe. See filed survey for procedures.


New Accessories

- 10" Fir, S08W, 22.2' (Scribed/Painted Red)
- 12" Fir, N75W, 23.1' (Scribed/Painted Red)

Location & Comments

Corner lies on gentle S.W. slope Compass Declination 20 $\frac{1}{2}$   
 Firm/Agency Roberts Surveying Inc.  
 Address 29 West 29th St.  
Eugene, Oregon 97405  
 Party Chief Ted Baker  
 Notes \_\_\_\_\_  
 Witness Stu Duce

Surveyor's Seal

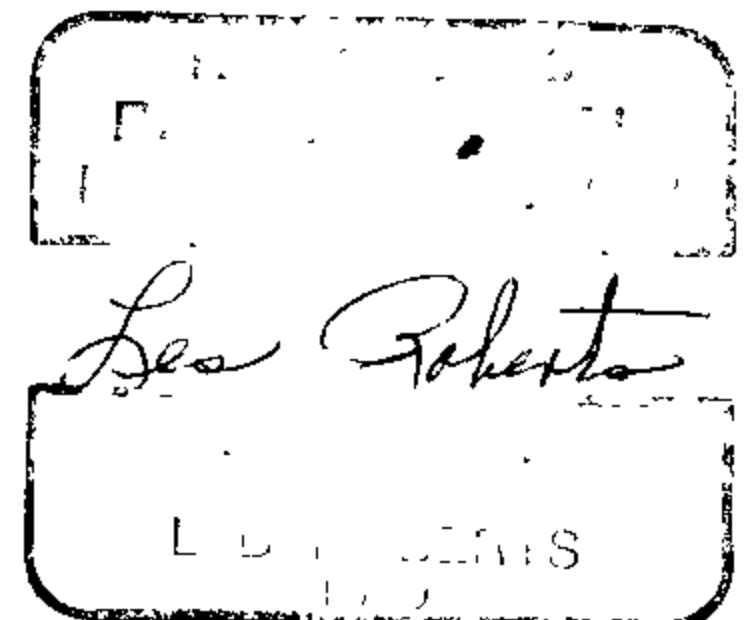

M 90-74

FILED  
RECEIVED *JK*


NOV 5 1985

OREGON CORNER RESTORATION FORM  
Section 12 Township 22S Range 8W  
County Douglas Date 8-08-85

COUNTY SURVEYOR  
DOUGLAS COUNTY, ORE.

Corner Designation

N.E. 1/16 Corner  
Section 12

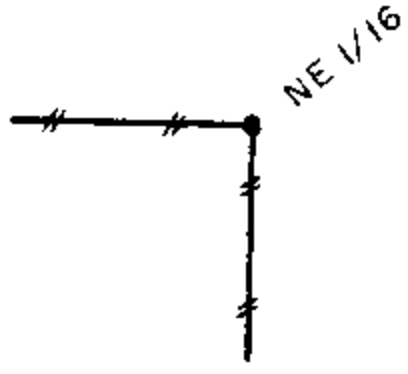


- Condition Report Only
- Not Found
- Renewed
- Unrecorded
- Surveyed In
- Referenced Out

Previous Renewals/Surveys, etc. None

Monument(s) & Accessories Found: (Condition and Source)

\_\_\_\_\_  
\_\_\_\_\_  
Monument Detail

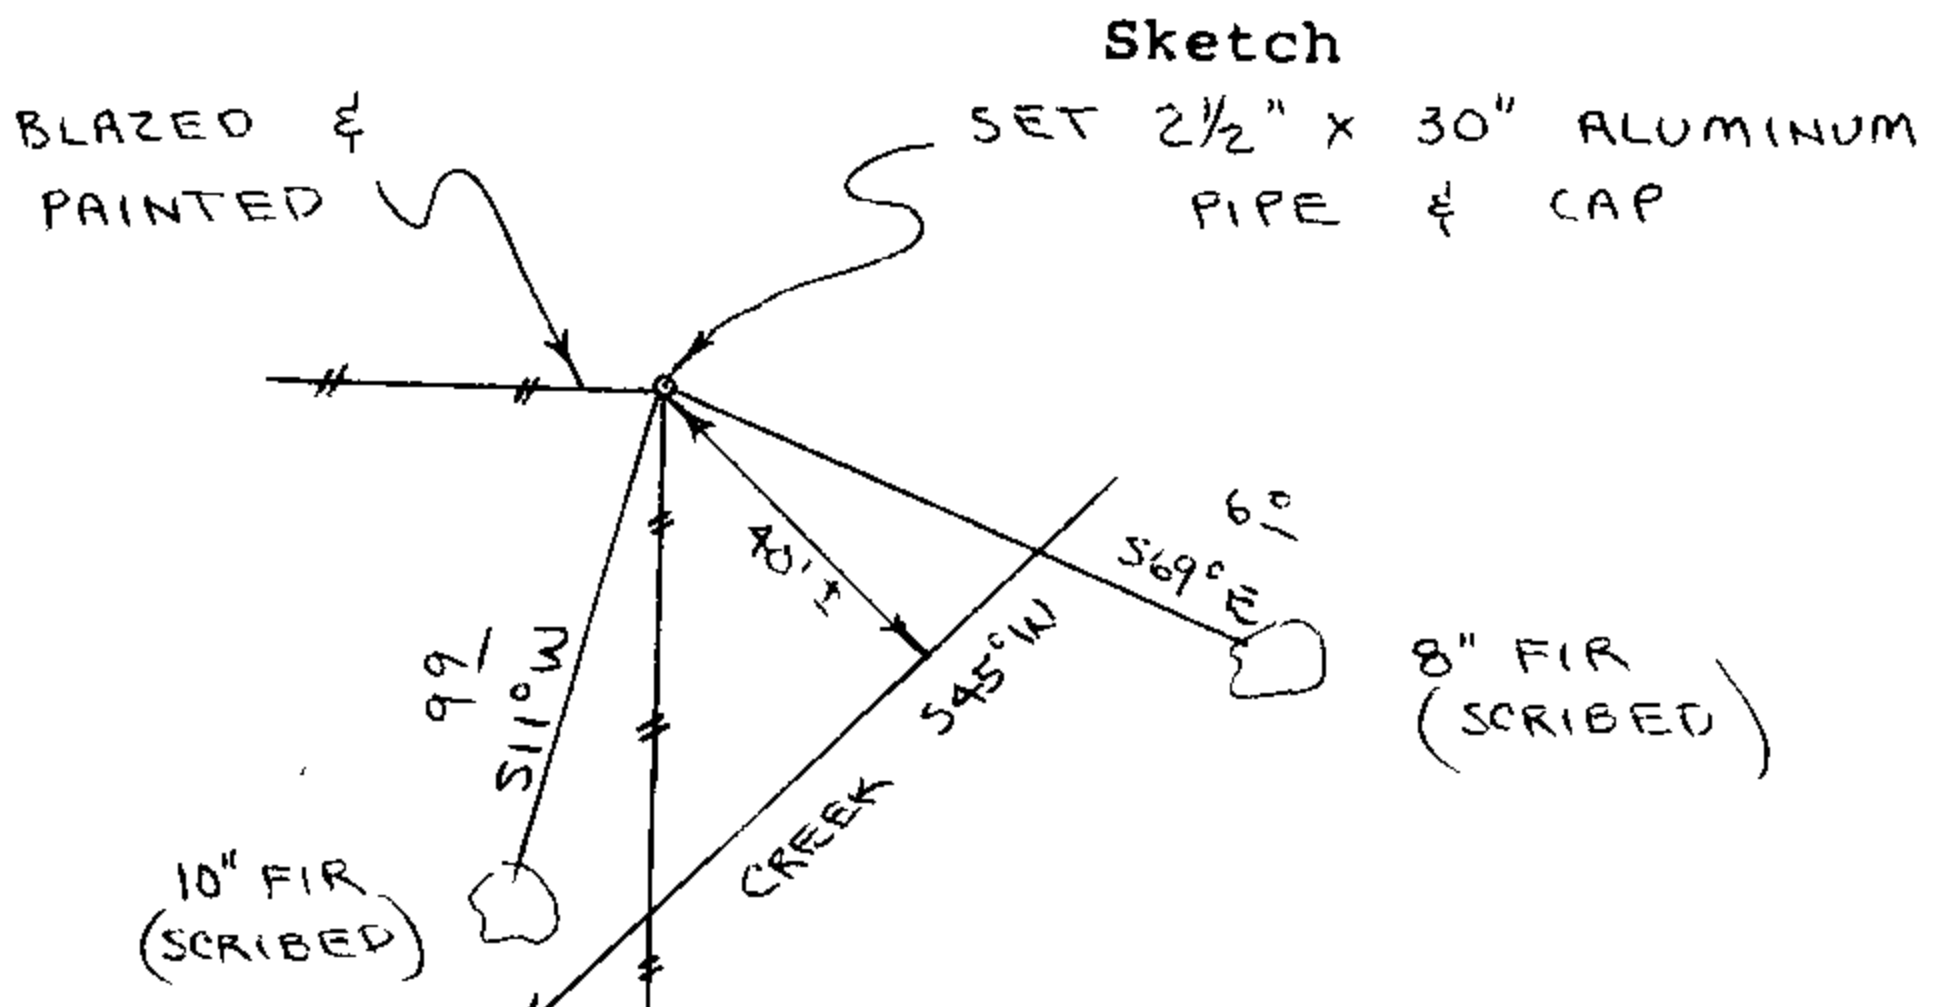

Monument Set (Procedures and Description)  
Set 2 1/2" x 30" Aluminum Pipe and Cap. Purple magnetic marker buried under aluminum pipe. Set metal fence post, with land survey monument sign wired to, beside aluminum pipe. See filed survey for procedures.

New Accessories

- 8" Fir, S69E, 6.0' (Scribed/Painted Red)
- 10" Fir, S11W, 9.9' (Scribed/Painted Red)

Location & Comments

Corner lies on gentle S.W. slope about 40' N.W. of small creek

Compass Declination 20 1/2

Firm/Agency Roberts Surveying Inc.


Address 29 West 29th St. Eugene, Oregon 97405

Party Chief Ted Baker

Notes \_\_\_\_\_

Witness Stu Duce

Surveyor's Seal

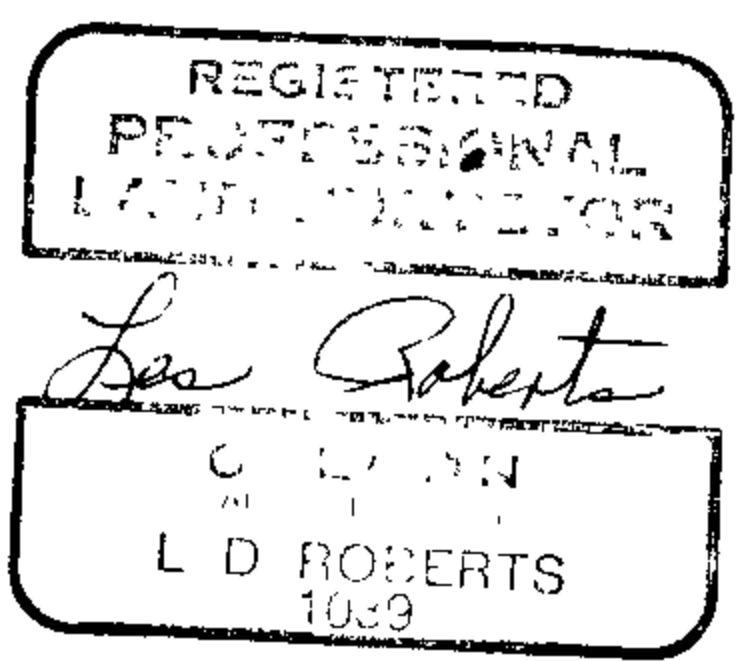

C.S. File No. 63/18-41

M 90-74

FILED  
RECEIVED *sh*

OREGON CORNER RESTORATION FORM

NOV 5 1985


Section 12 Township 22S Range 8W

COUNTY SURVEYOR  
DOUGLAS COUNTY, ORE.

County Douglas Date 8-09-85

Corner Designation

C.E. 1/16 Corner  
Section 12

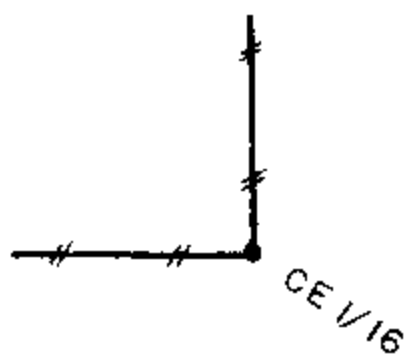



- Condition Report Only
- Not Found
- Renewed
- Unrecorded
- Surveyed In
- Referenced Out

Previous Renewals/Surveys, etc. None

Monument(s) & Accessories Found: (Condition and Source)

Monument Detail

Sketch

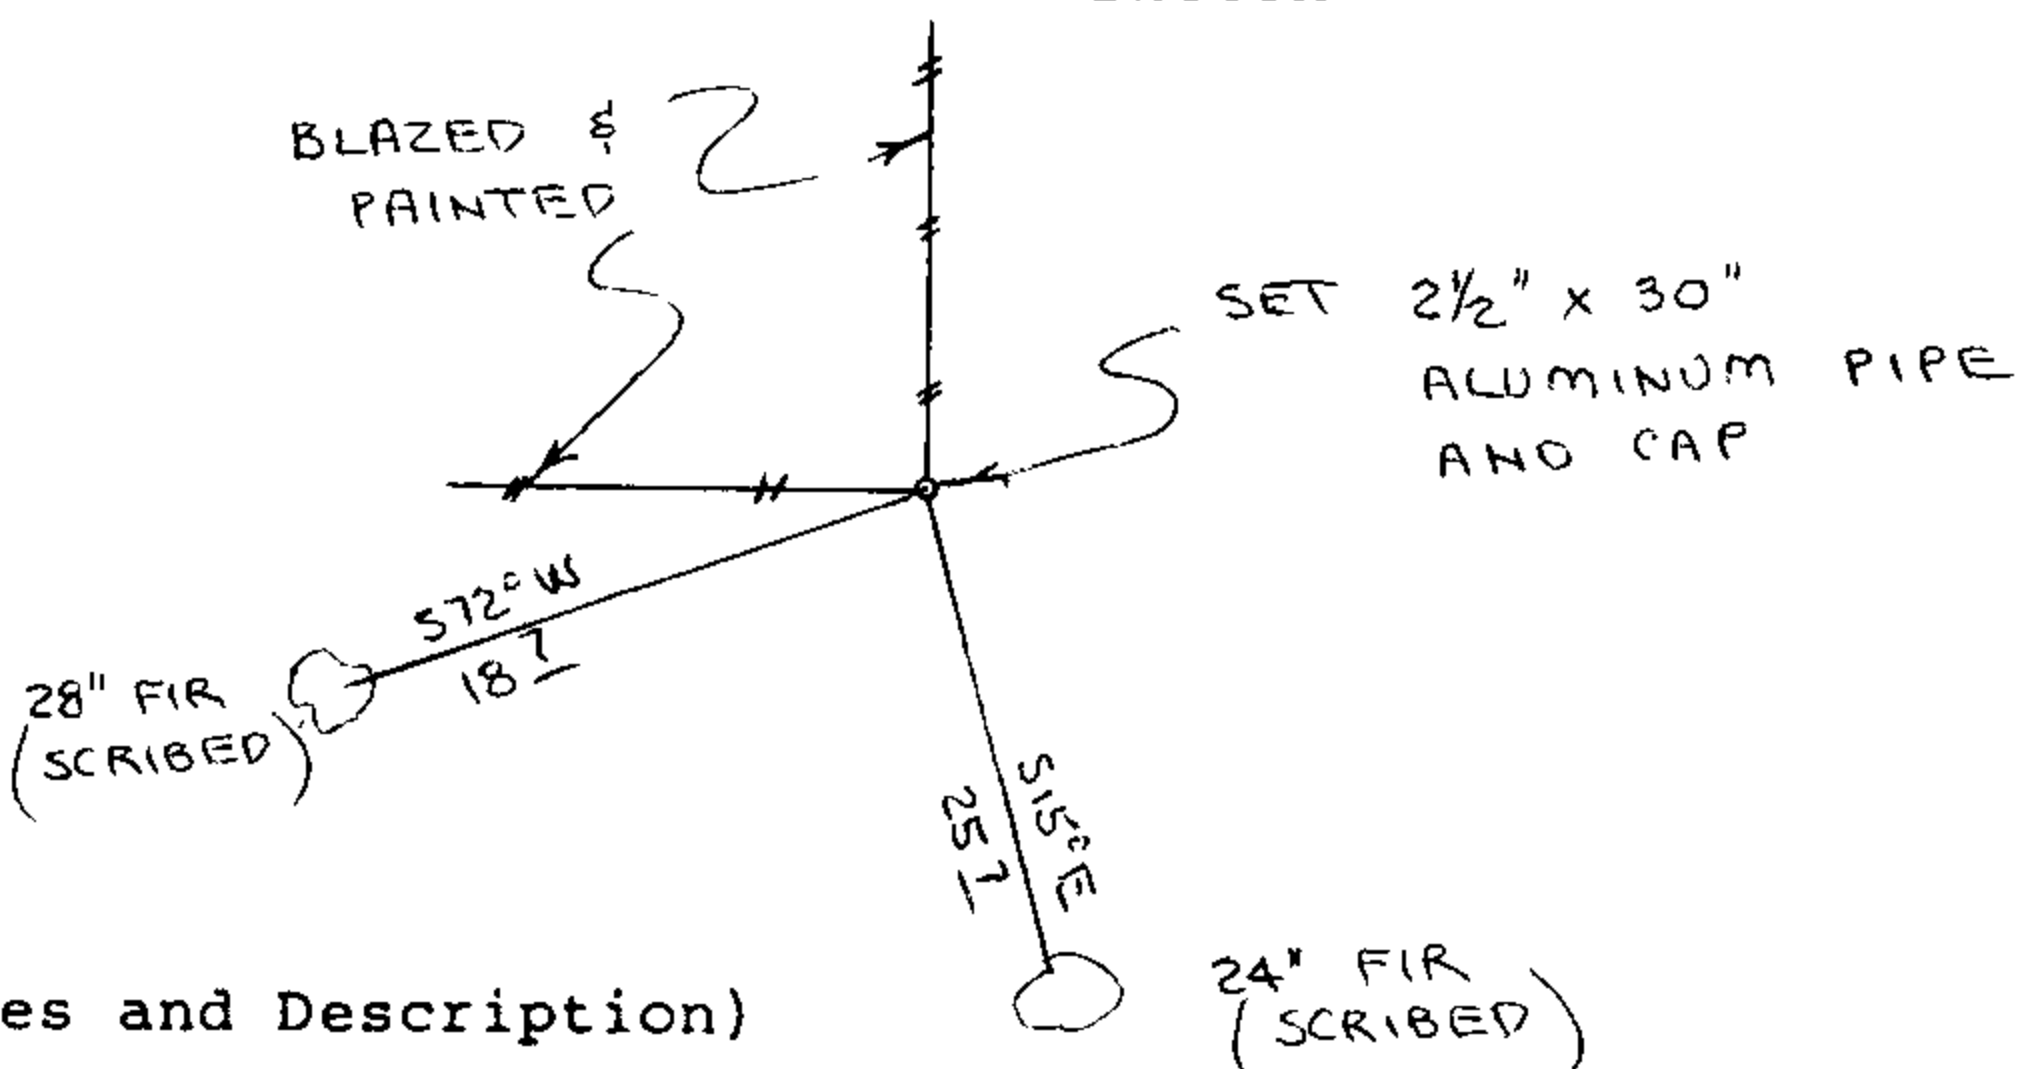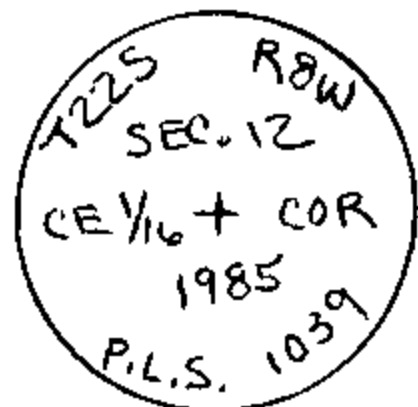

Monument Set (Procedures and Description)

Set 2 1/2" x 30" Aluminum Pipe and Cap. Purple magnetic marker buried under aluminum pipe. Set metal fence post, with land survey monument sign wired to, beside aluminum pipe. See filed survey for procedures.


New Accessories

- 24" Fir, S15E, 25.7' (Scribed/Painted red)
- 28" Fir, S72W, 18.7' (Scribed/Painted red)

Location & Comments

Surveyor's Seal

Compass Declination 20 1/2  
 Firm/Agency Roberts Surveying Inc.  
 Address 29 West 29th St.  
Eugene, Oregon 97405  
 Party Chief Ted Baker  
 Notes \_\_\_\_\_  
 Witness Stu Duce

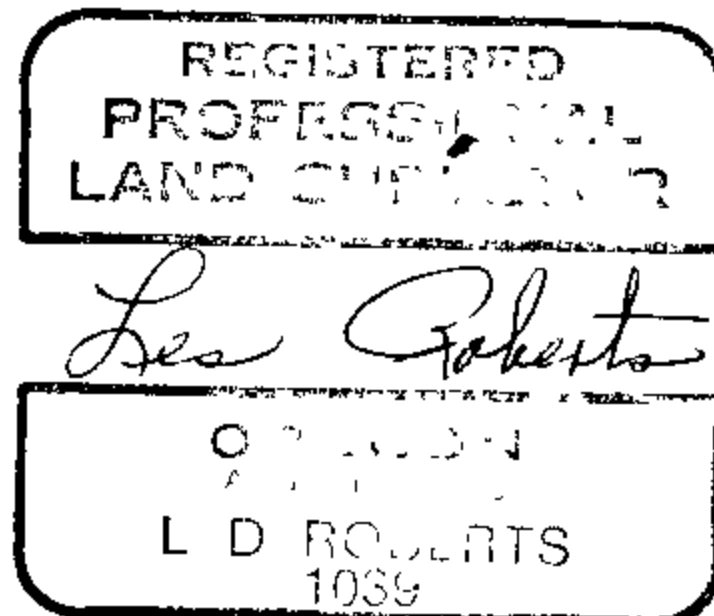

C.S. File No. 63/18-4J

18790-78

FILED  
RECEIVED *SL*

NOV 5 1985


OREGON CORNER RESTORATION FORM

Section 12 Township 22S Range 8W  
County Douglas Date 8-13-85

COUNTY SURVEYOR  
DOUGLAS COUNTY, ORE.

Corner Designation

C 1/4 Corner  
Section 12

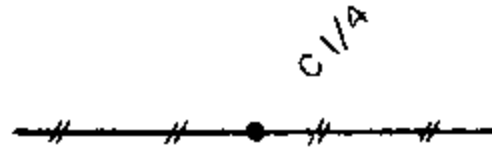


- Condition Report Only
- Not Found
- Renewed
- Unrecorded
- Surveyed In
- Referenced Out

Previous Renewals/Surveys, etc. None

Monument(s) & Accessories Found: (Condition and Source)

Monument Detail

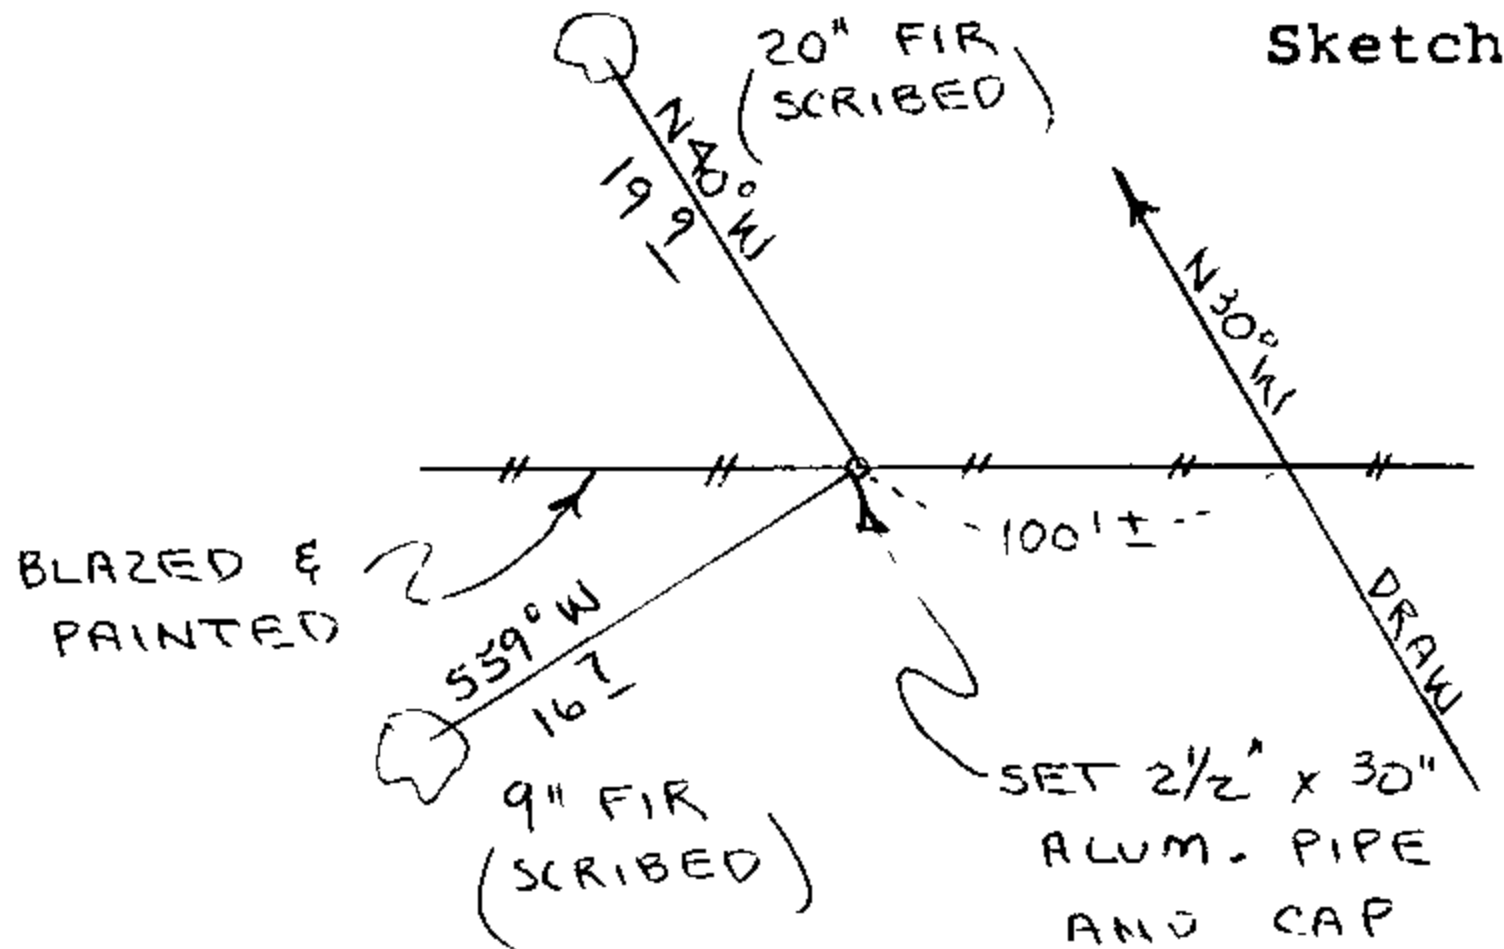

Monument Set (Procedures and Description)

Set 2 1/2" x 30" Aluminum Pipe and Cap. Purple magnetic marker buried under aluminum pipe. Set metal fence post, with land survey monument sign wired to, beside aluminum pipe. See filed survey for procedures.


New Accessories

9" Fir, S59W, 16.7' (Scribed/Painted Red)  
20" Fir, N40W, 19.9' (Scribed/Painted Red)

Location & Comments

Corner lies on N.W. slope about 100' West of small draw. Compass Declination 20 1/2  
Firm/Agency Roberts Surveying Inc.  
Address 29 West 29th St. Eugene, Oregon 97405  
Party Chief Ted Baker  
Notes  
Witness Stu Duce

Surveyor's Seal

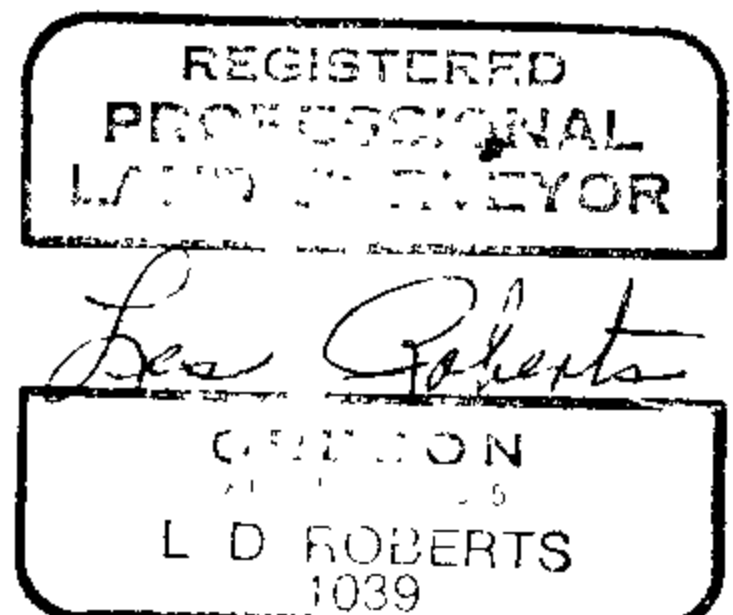

#157

C.S. File No. 63/18-4K

17790-74

FILED  
RECEIVED *SL*

OREGON CORNER RESTORATION FORM


NOV 5 1985

Section 12 Township 22S Range 8W  
County Douglas Date 8-14-85

COUNTY SURVEYOR  
DOUGLAS COUNTY, ORE

Corner Designation

C.W. 1/16 Corner  
Section 12

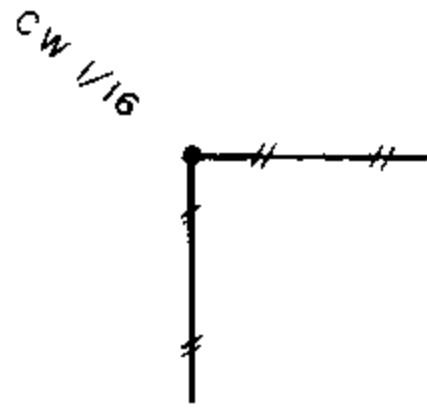

- Condition Report Only
- Not Found
- Renewed
- Unrecorded
- Surveyed In
- Referenced Out

Previous Renewals/Surveys, etc. None

Monument(s) & Accessories Found: (Condition and Source)


Monument Detail

9" FIR  
(SCRIBED)

Sketch



SET 2 1/2" X 30"  
ALUM. PIPE  
AND CAP

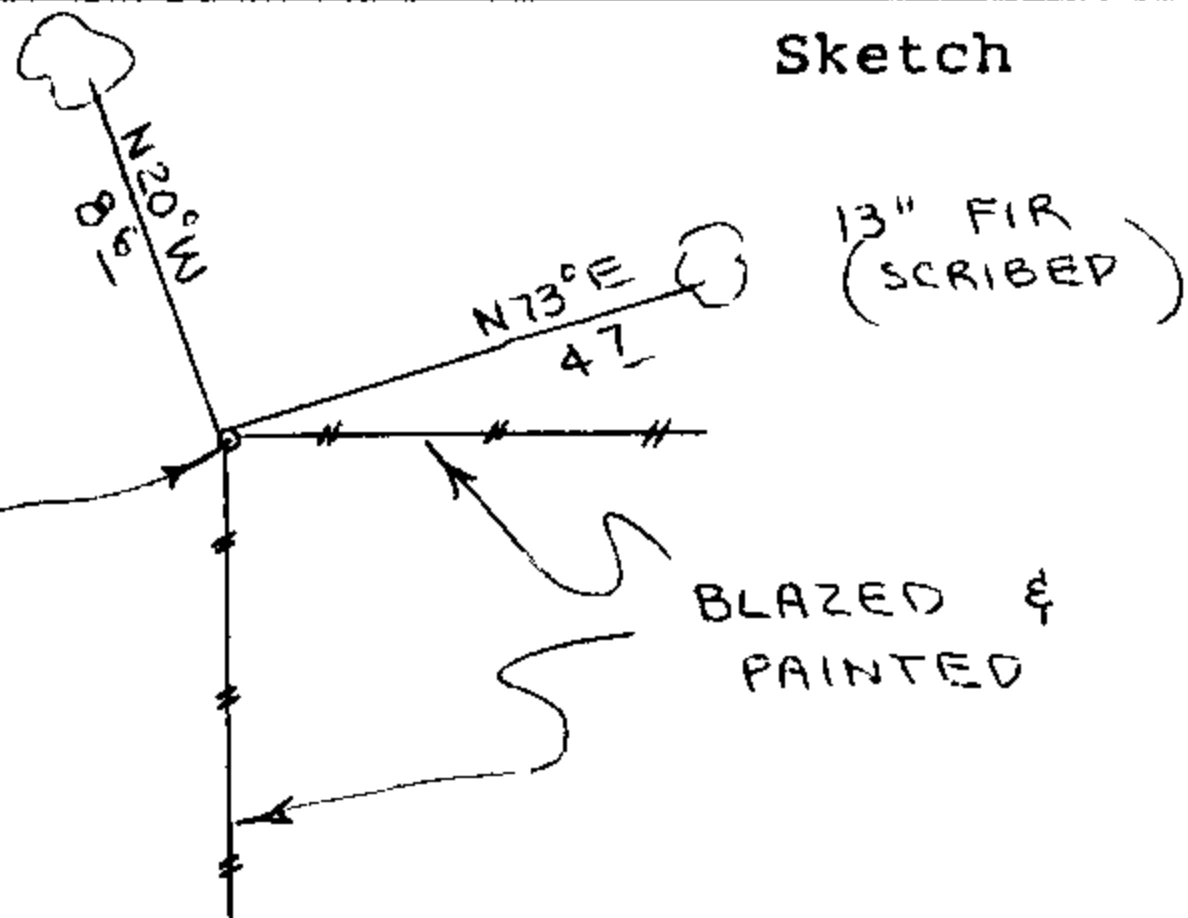

Monument Set (Procedures and Description)

Set 2 1/2" x 30" Aluminum Pipe and Cap. Purple magnetic marker buried under aluminum pipe. Set metal fence post, with land survey monument sign wired to, beside aluminum pipe. See filed survey for procedures.


New Accessories

9" Fir, N20W, 8.6' (Scribed/Painted Red)  
13" Fir, N73E, 4.7' (Scribed/Painted Red)

Location & Comments

Surveyor's Seal

Compass Declination 20 1/2  
Firm/Agency Roberts  
Surveying Inc.  
Address 29 West 29th St.  
Eugene, Oregon 97405  
Party Chief Ted Baker  
Notes \_\_\_\_\_  
Witness Stu Duce

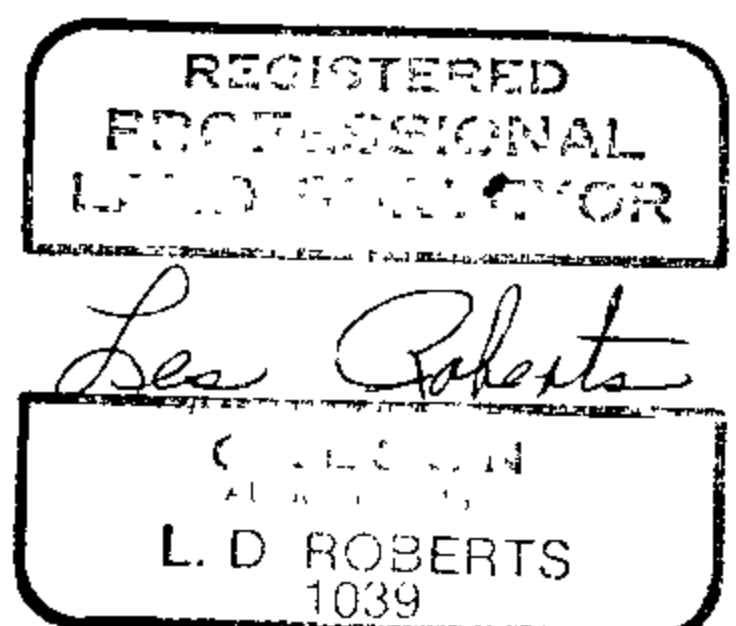

C.S. File No. 63/18-42

1790-74

FILED  
RECEIVED *RL*

OREGON CORNER RESTORATION FORM

NOV 5 1985


Section 12 Township 22S Range 8W

COUNTY SURVEYOR  
DOUGLAS COUNTY, ORE.

County Douglas Date 8-22-85

Corner Designation

S.W. 1/16 Corner  
Section 12

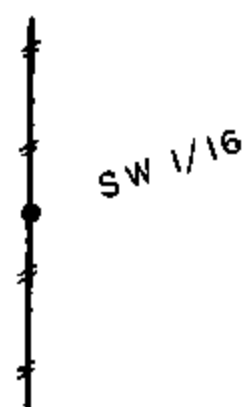

- Condition Report Only
- Not Found
- Renewed
- Unrecorded
- Surveyed In
- Referenced Out

Previous Renewals/Surveys, etc. None


Monument(s) & Accessories Found: (Condition and Source)

Monument Detail



BLAZED & PAINTED

SET 2 1/2" x 30" ALUM. PIPE AND CAP

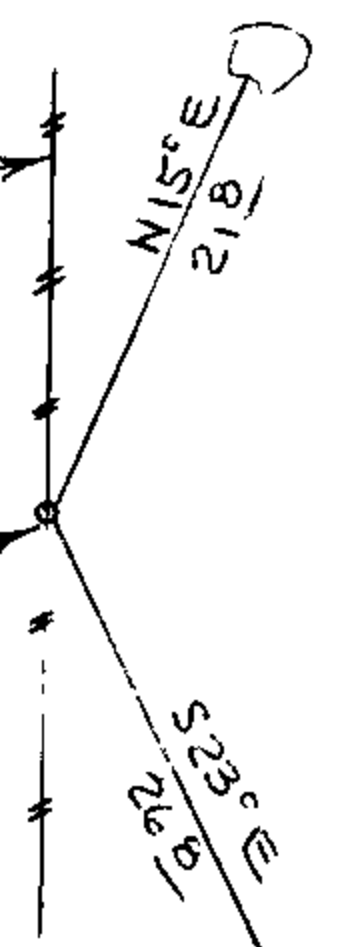

7" FIR (SCRIBED)

13" FIR (SCRIBED)

Monument Set (Procedures and Description)

Set 2 1/2" x 30" Aluminum Pipe and Cap. Purple magnetic marker buried under aluminum pipe. Set metal fence post, with land survey monument sign wired to, beside aluminum pipe. See filed survey for procedures.


New Accessories

- 7" Fir, N15E, 21.8' (Scribed/Painted Red)
- 13" Fir, S23E, 26.8' (Scribed/Painted Red)

Location & Comments

Compass Declination 20 1/2  
 Firm/Agency Roberts Surveying Inc.  
 Address 29 West 29th St. Eugene, Oregon 97405  
 Party Chief Ted Baker  
 Notes \_\_\_\_\_  
 Witness Stu Duce

Surveyor's Seal

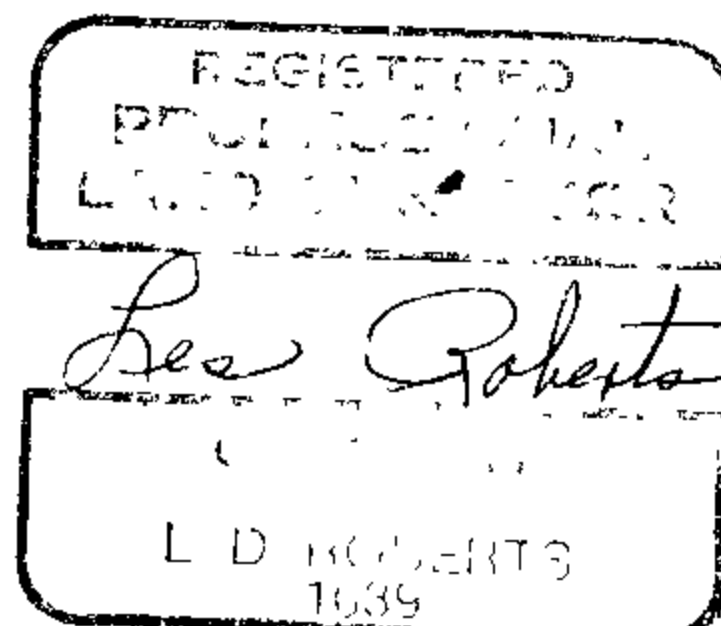

C.S. File No. 63/18-4M

M96-74

FILED  
RECEIVED *z h*

OREGON CORNER RESTORATION FORM

NOV 5 1985


Section 12 Township 22S Range 8W

COUNTY SURVEYOR  
DOUGLAS COUNTY, ORE.

County Douglas Date 8-22-85

Corner Designation

West 1/16 Corner  
South Line  
Section 12

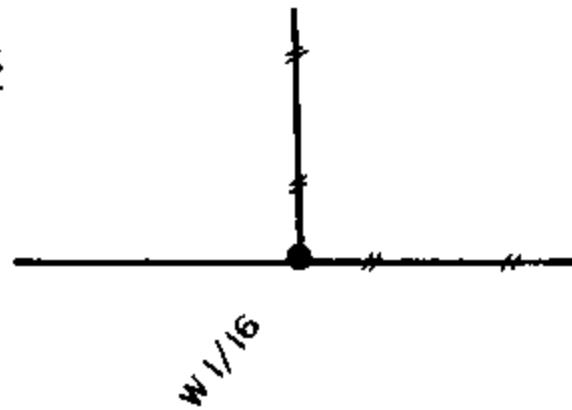


- Condition Report Only
- Not Found
- Renewed
- Unrecorded
- Surveyed In
- Referenced Out

Previous Renewals/Surveys, etc. None

Monument(s) & Accessories Found: (Condition and Source)

Monument Detail

Sketch

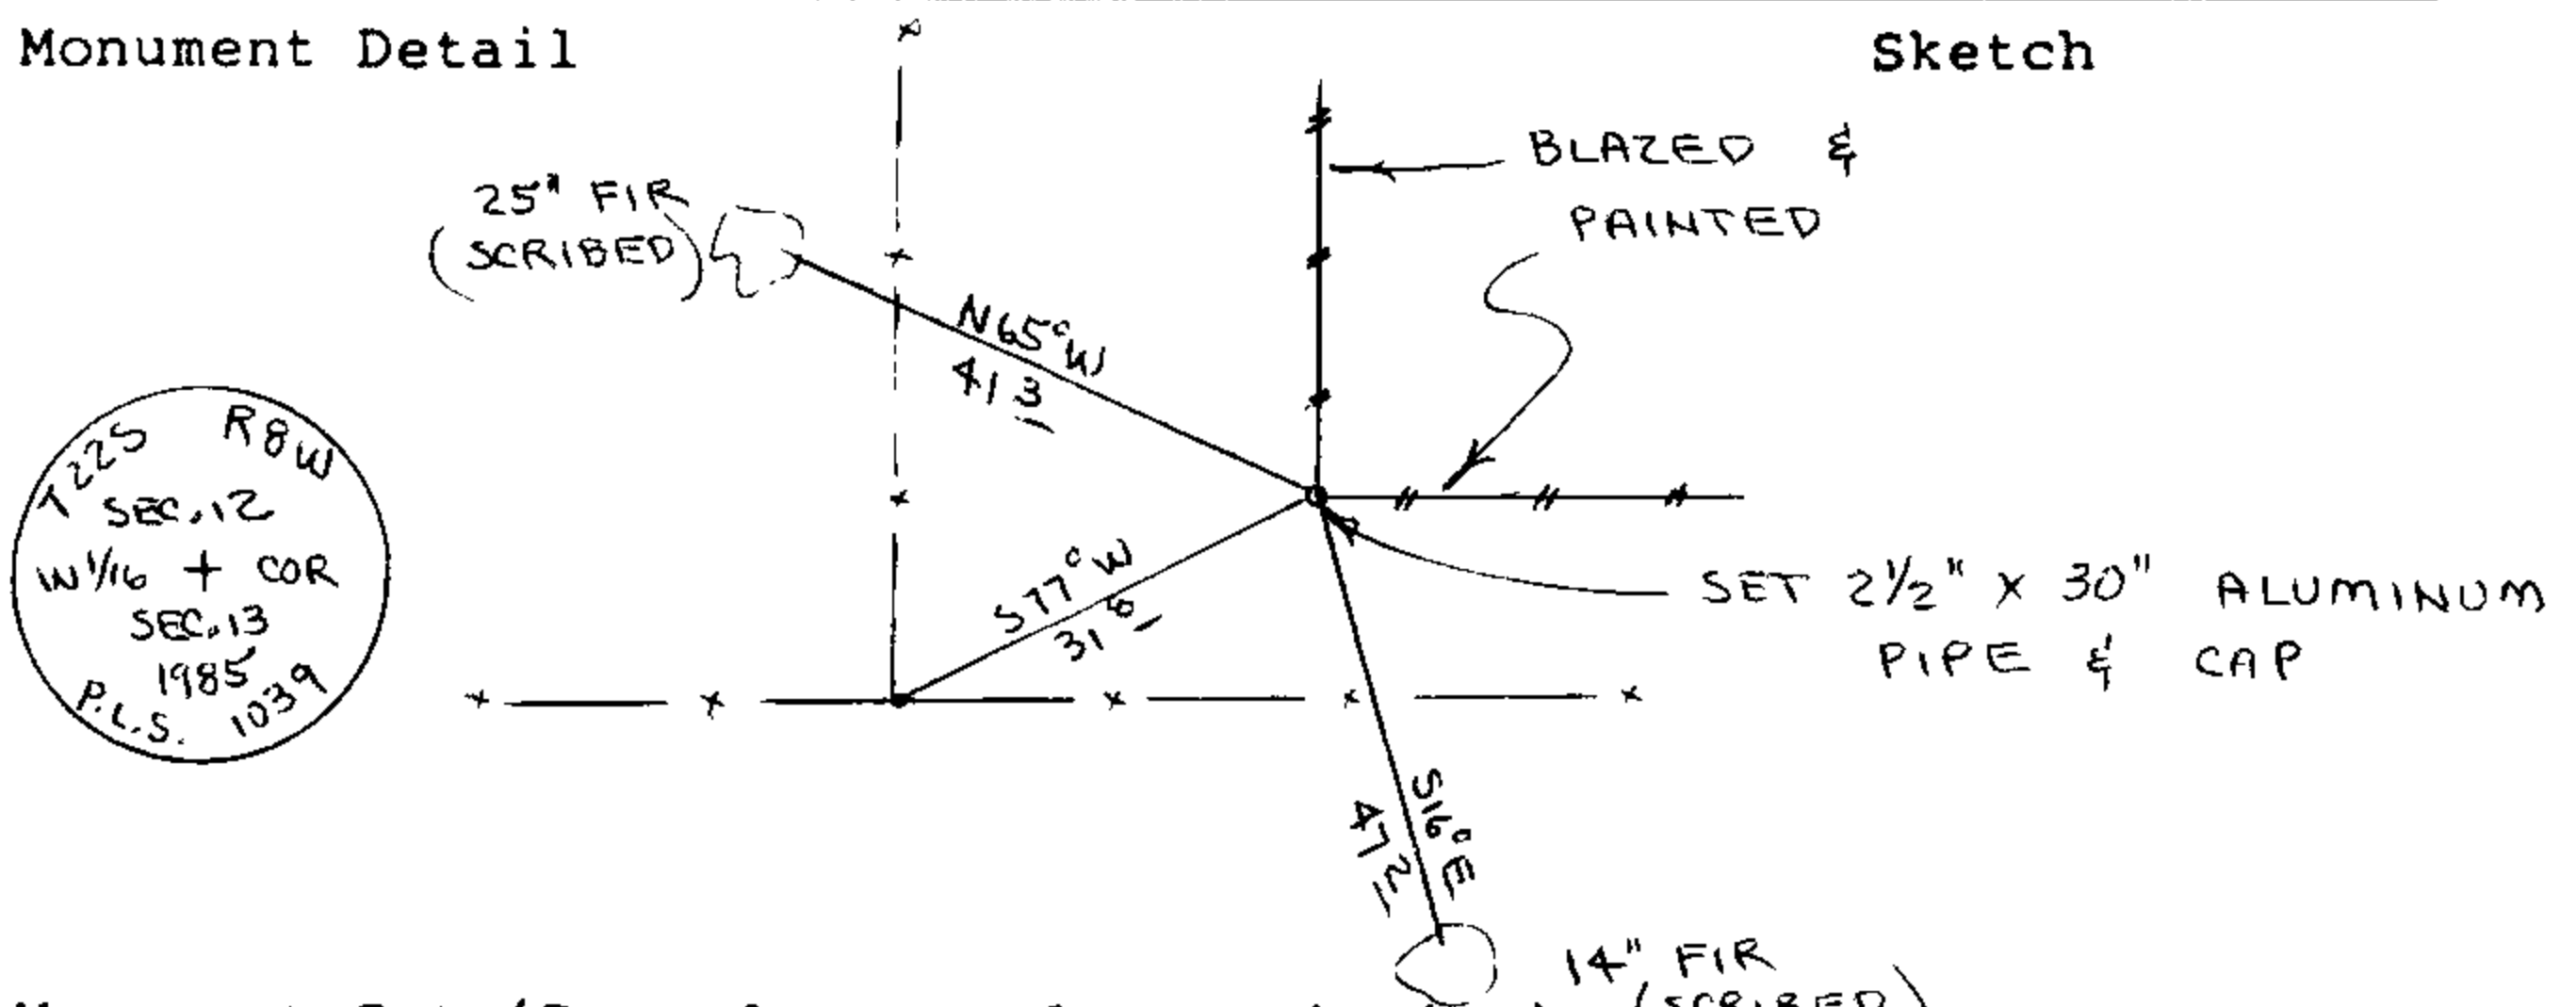

Monument Set (Procedures and Description) (SCRIBED)

Set 2 1/2" x 30" Aluminum Pipe and Cap. Purple magnetic marker buried under aluminum pipe. Set metal fence post, with land survey monument sign wired to, beside aluminum pipe. See filed survey for procedures. East-West-North fence bears S77W, 31.8'


New Accessories

- 14" Fir, S16E, 47.2' (Scribed/Painted Red)
- 25" Fir, N65W, 41.3' (Scribed/Painted Red)

Location & Comments

Surveyor's Seal

Compass Declination 20 1/2  
 Firm/Agency Roberts Surveying Inc.  
 Address 29 West 29th St.  
Eugene, Oregon 97405  
 Party Chief Ted Baker  
 Notes \_\_\_\_\_  
 Witness Stu Duce

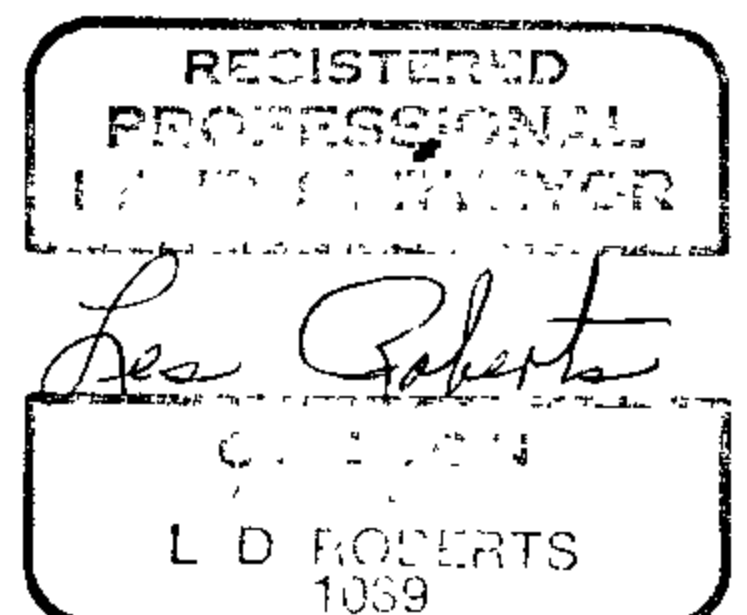

J.S. File No. 63/18-4W  
C