

117102-18

FILED

JUL 23 1986

OREGON CORNER RESTORATION FORM


Section 3 Township 22S Range 8W

County Douglas Date 5-30-86

COUNTY SURVEYOR
DOUGLAS COUNTY, ORE.

Corner Designation

N.W. Corner
Section 3
(Closing Cor.)

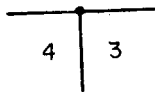

- Condition Report Only
- Not Found
- Renewed
- Unrecorded
- Surveyed In
- Referenced Out


Previous Renewals/Surveys, etc. 1945 and 1952 G.L.O. Surveys

Monument(s) & Accessories Found: (Condition and Source)

Found 1945 G.L.O. Brass Cap set firmly in ground.
24" Fir Stub, S07E, 18.1' (Scribe Vis.), 1881 BT. Rec. S11 1/4 E, 17.2'
40" Fir, S64W, 24.5' (Scar Vis.), 1881 BT. Rec. S62W, 25.1'
6" Fir, N08W, 29.5' (Scar Vis.), ? BT.

Monument Detail

Sketch

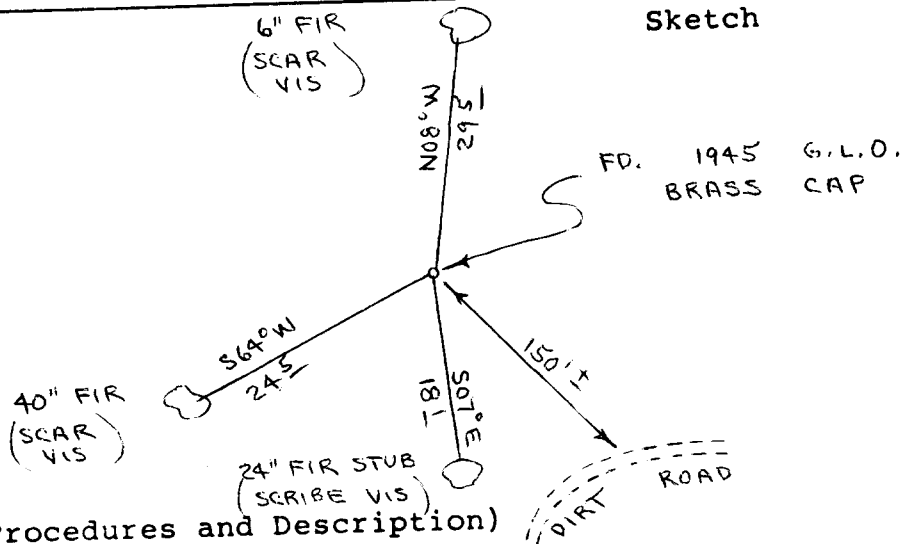

Monument Set (Procedures and Description)

New Accessories

Set metal fence post, with survey attention sign wired to, beside Brass Cap. Painted all BT's red.

Location & Comments

Corner lies on NW slope about 150' from dirt road.

Compass Declination 20 1/2
 Firm/Agency Roberts Surveying Inc.
 Address 29 West 29th St. Eugene, Oregon 97405
 Party Chief Les Roberts
 Notes Les Roberts
 Witness Ted Baker

Surveyor's Seal



#167 T22-8 ✓
#38 T21-8 ✓

C.S. File No. 123/18

M102-18

FILED

JUL 23 1986

OREGON CORNER RESTORATION FORM


Section 3 Township 22S Range 8W

County Douglas Date 05-29-86

COUNTY SURVEYOR
DOUGLAS COUNTY, ORE.

Corner Designation

N.E. Corner
Section 3
(Closing Cor.)

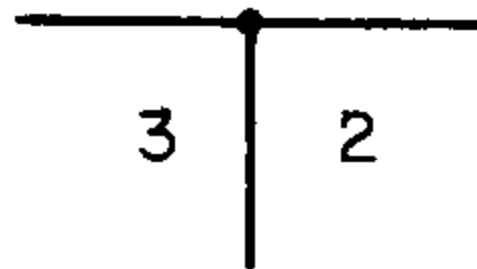

- Condition Report Only
- Not Found
- Renewed
- Unrecorded
- Surveyed In
- Referenced Out

Previous Renewals/Surveys, etc. 1952 G.L.O. Survey

Monument(s) & Accessories Found: (Condition and Source)

Found 1952 G.L.O. Brass Cap set firmly in ground.


15" Fir Up-root, S78W, 54.0' (Scribe Vis.), 1952 BT.

Record S78W, 54.1'

28" Cedar Stump, S07E, 25.0' (No Marks), 1952 BT.

Record S08 1/4 E, 25.1'

Monument Detail

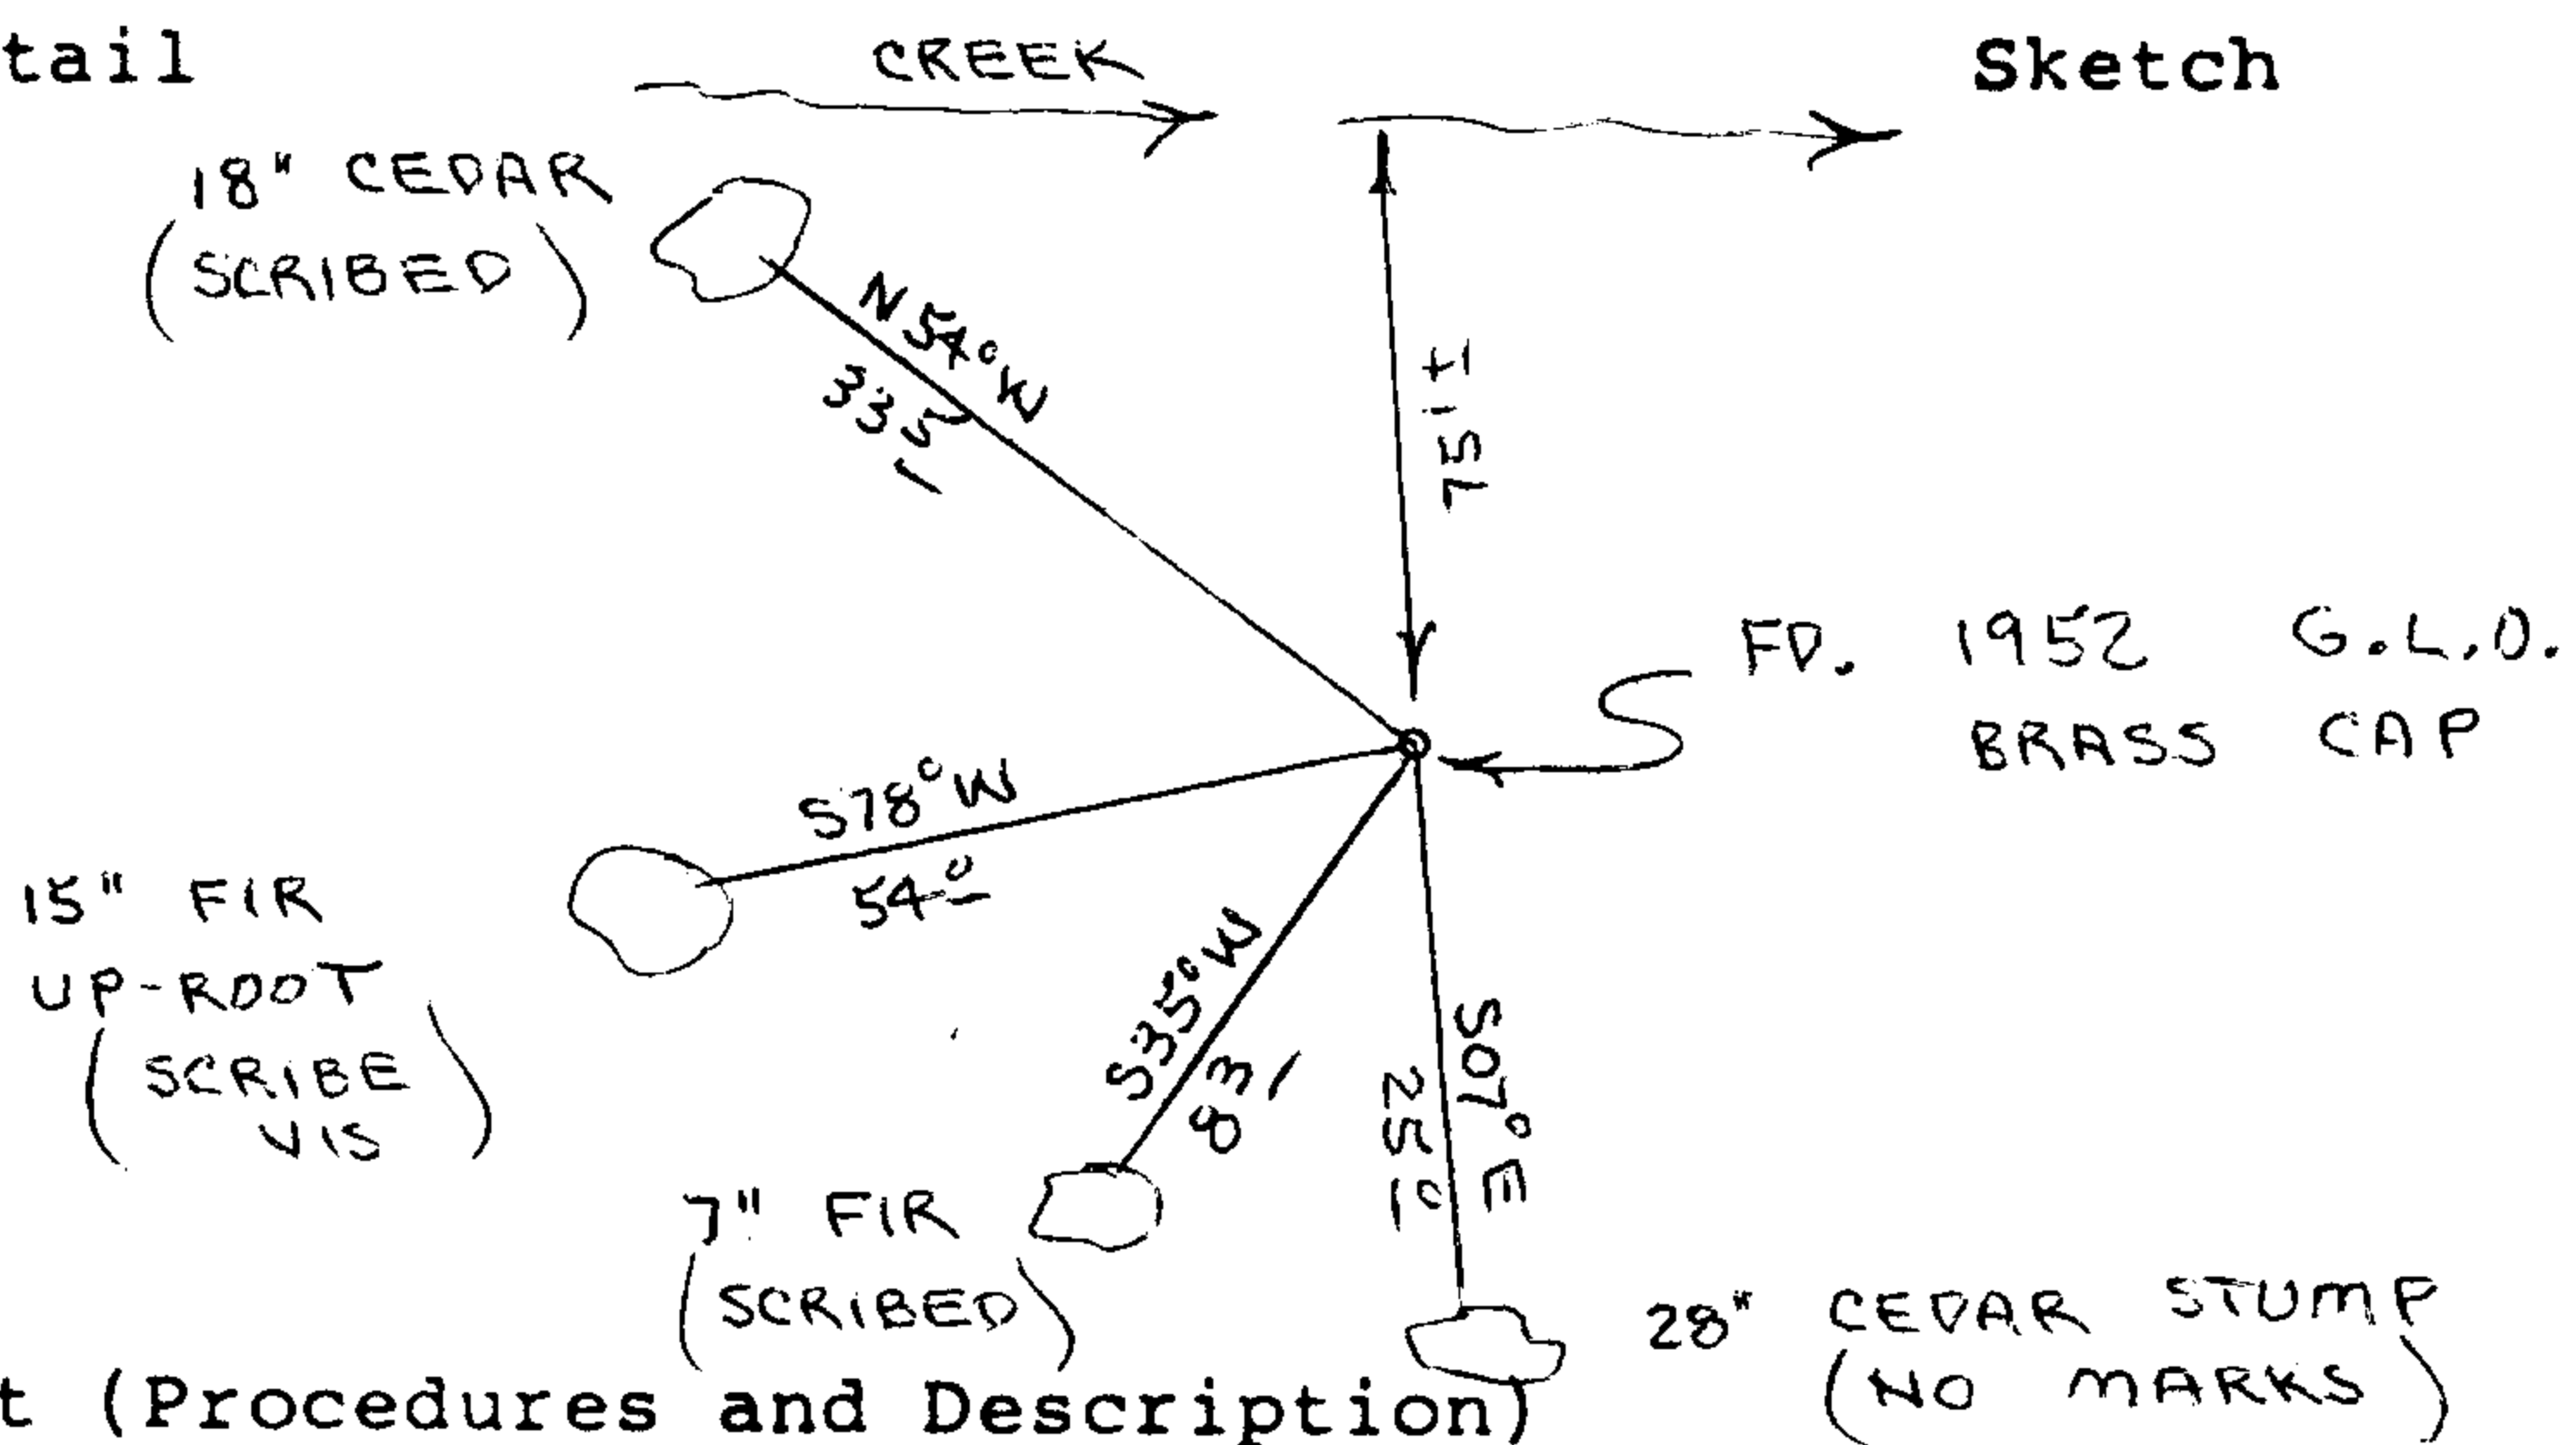

Monument Set (Procedures and Description)

New Accessories

7" Fir . S35W. 8.3' (Scribed/Painted Red)

18" Cedar, N54W, 33.5' (Scribed/Painted Red)

Drove R.R. Spike in side of 28" Cedar Stump, 1952 BT.

Set metal fence post, with survey attention sign wired to, beside brass cap. Painted all BT's red.

Location & Comments

Corner lies on North Compass Declination 20 1/2

slope about 75' Firm/Agency Roberts

South of small creek. Surveying Inc.

Address 29 West 29th St.


Eugene, Oregon 97405

Party Chief Les Roberts

Notes Ted Baker

Witness

Surveyor's Seal

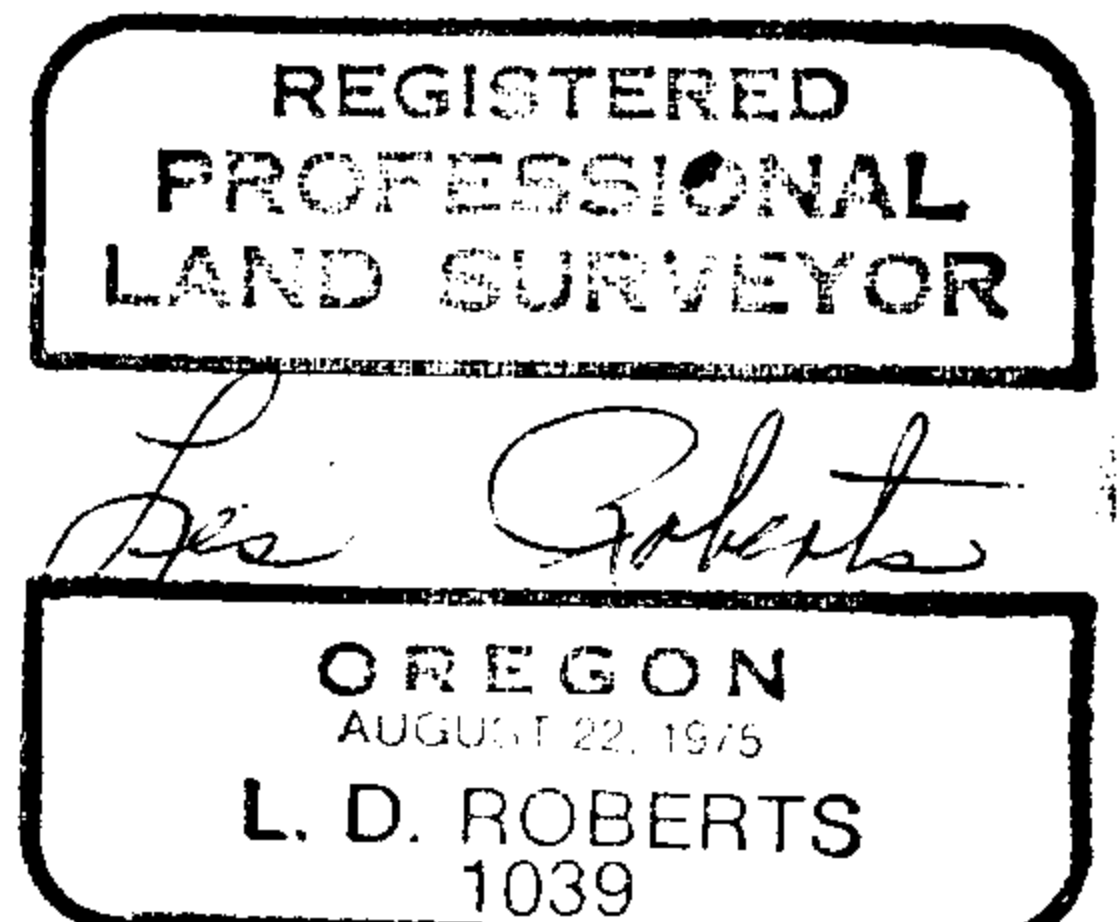

C.S. File No. 63/18-5Bc

#166 T-22-8
#37 T-21-8

117102-18

FILED

LR

OREGON CORNER RESTORATION FORM

JUL 23 1986


Section 3 Township 22S Range 8W

COUNTY SURVEYOR
DOUGLAS COUNTY, ORE.

County Douglas Date 06-04-86

Corner Designation

North 1/16 Corner
Section 3

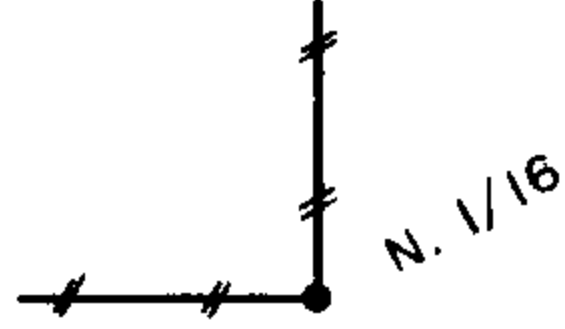

- Condition Report Only
- Not Found
- Renewed
- Unrecorded
- Surveyed In
- Referenced Out



Previous Renewals/Surveys, etc. None

Monument(s) & Accessories Found: (Condition and Source)

None

Monument Detail

Sketch

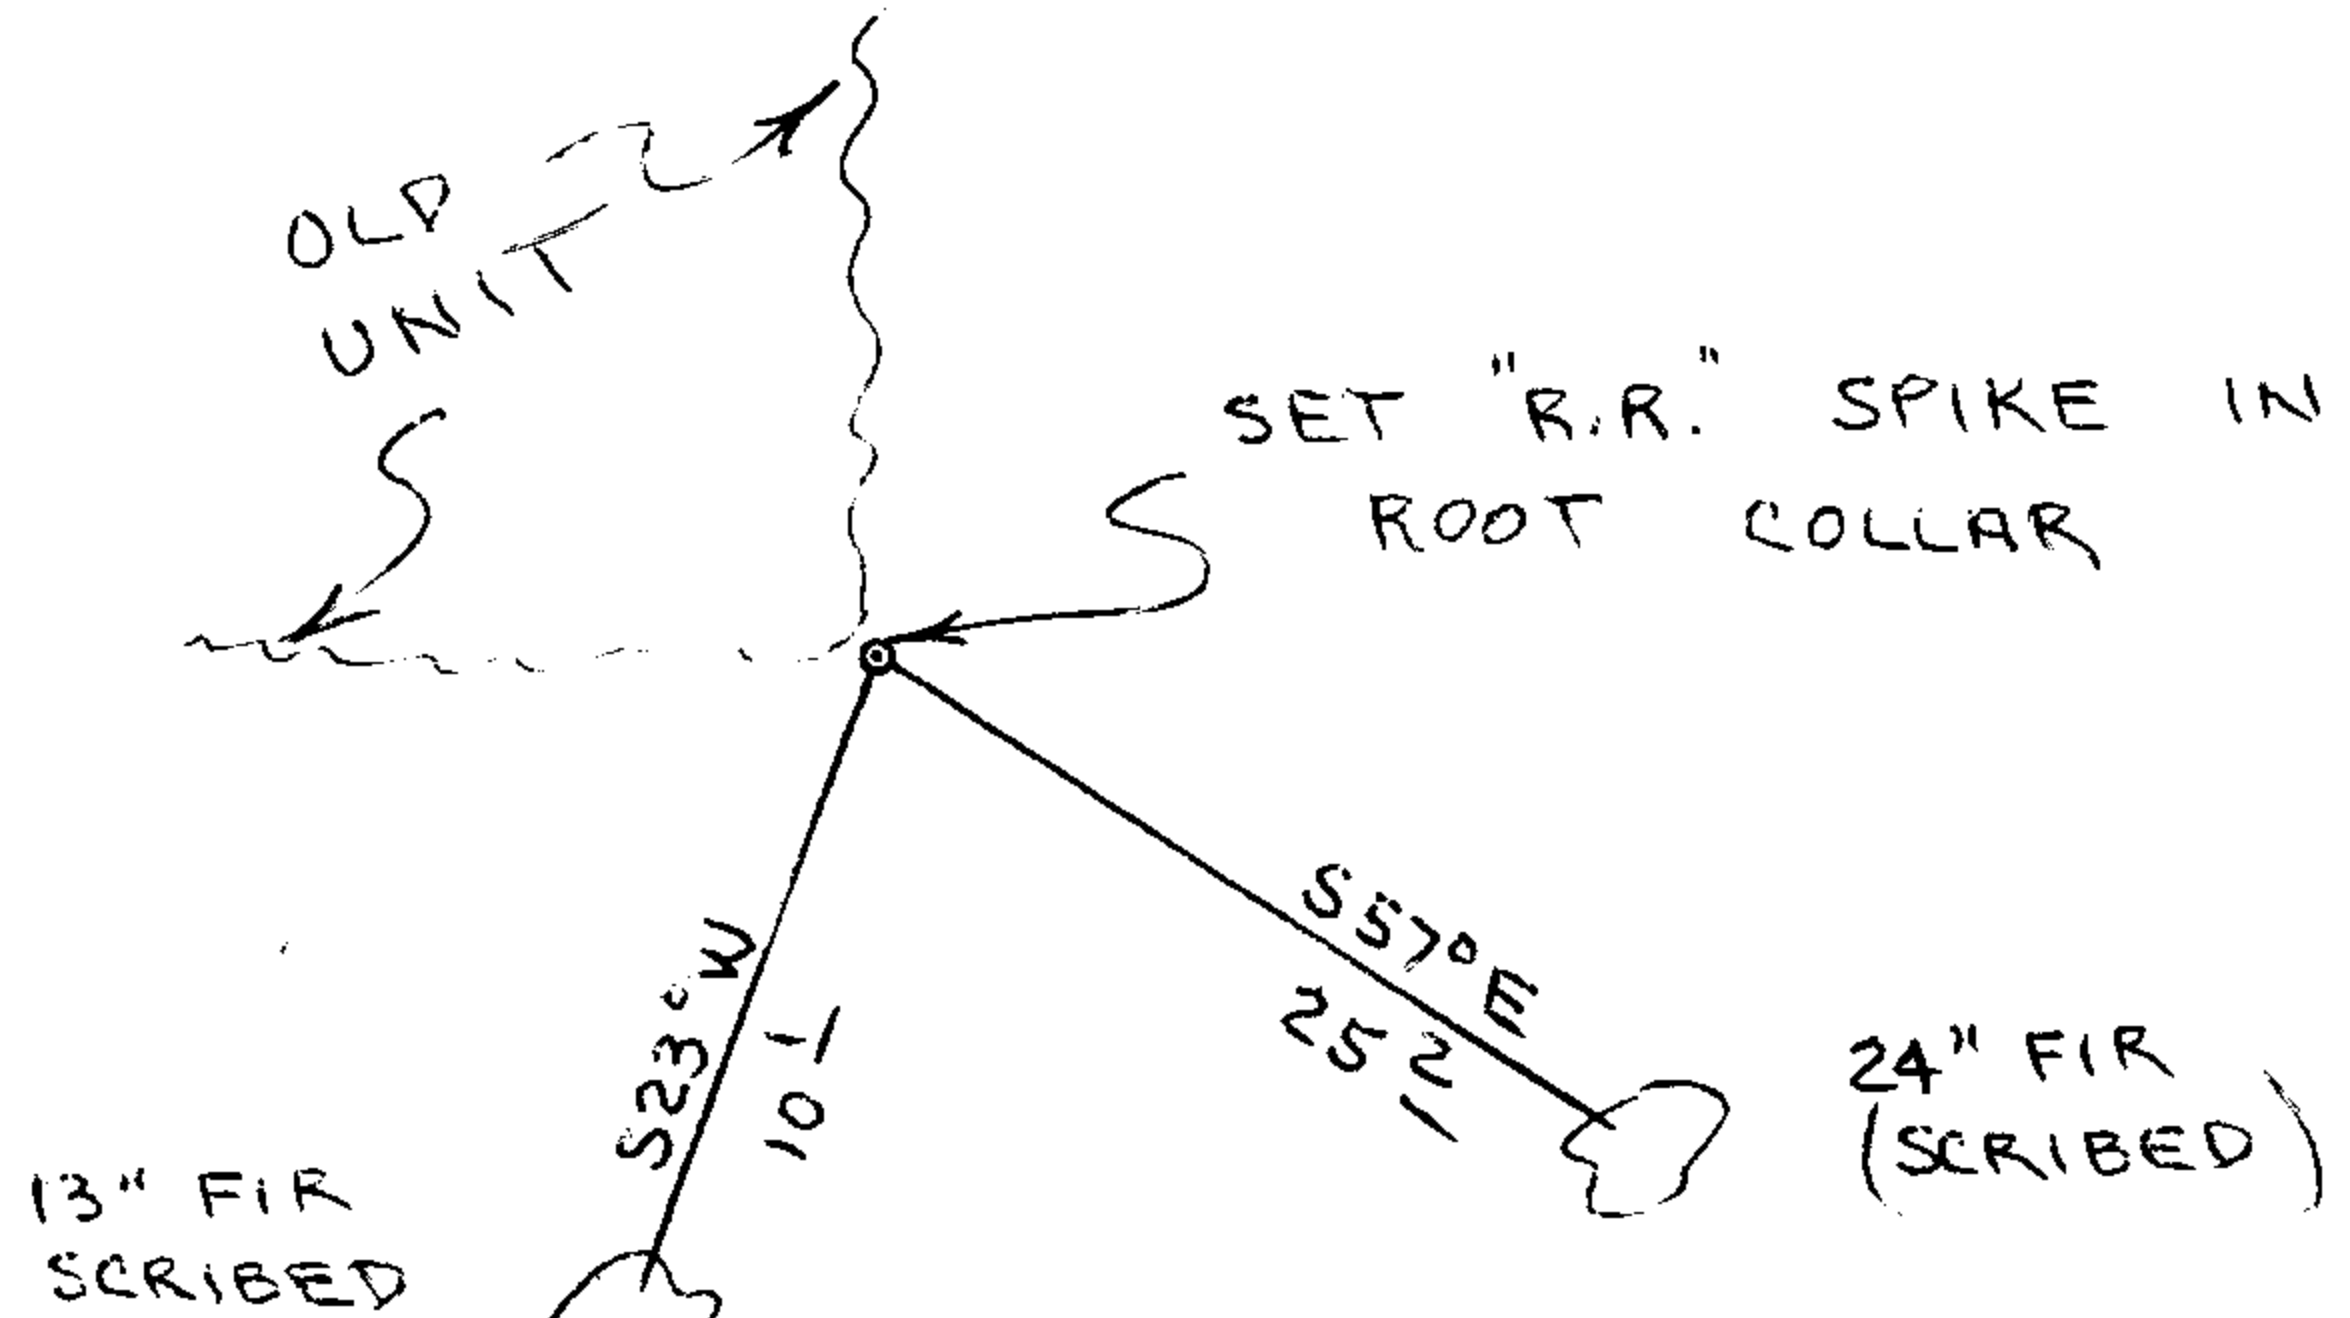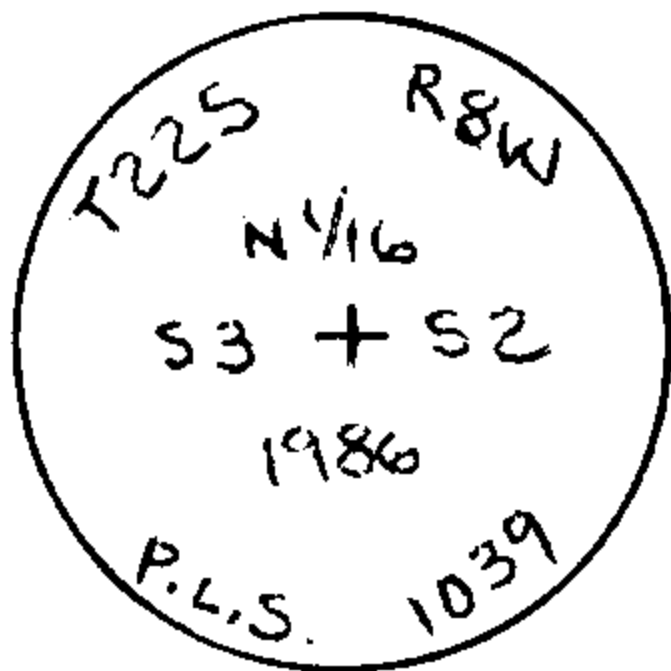

Monument Set (Procedures and Description)

Set "R.R" Spike in root collar of 28" White Fir for true 1/16
Corner. See filed survey for procedures.

New Accessories

13" Fir, S23W, 10.1' (Scribed/Painted Red)


24" Fir, S57E, 25.2' (Scribed/Painted Red)

Set metal fence post, with land survey monument sign wired to,
beside brass cap. Painted all BT's red.


Location & Comments

Corner lies at S.E. Compass Declination 20 1/2
 Corner of 20 to 25 Firm/Agency Roberts
year old logging unit. Surveying Inc.
Address 29 West 29th St.
Eugene, Oregon 97405
Party Chief Les Roberts
Notes Les Roberts
Witness Ted Baker

Surveyor's Seal

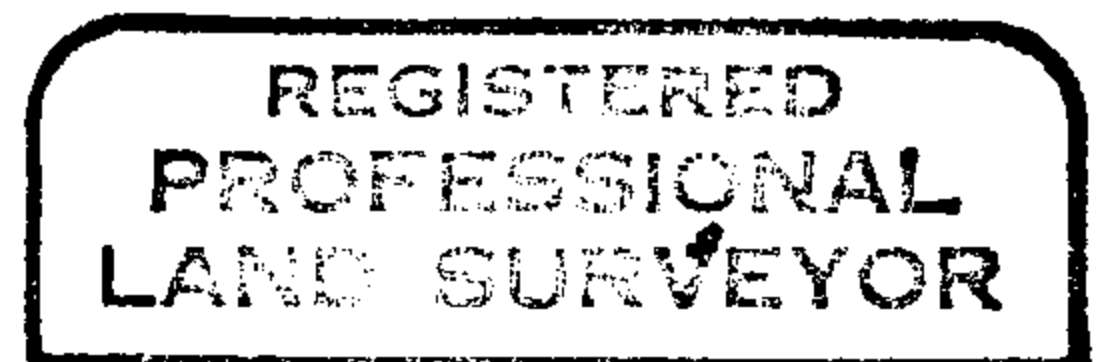

Les Roberts

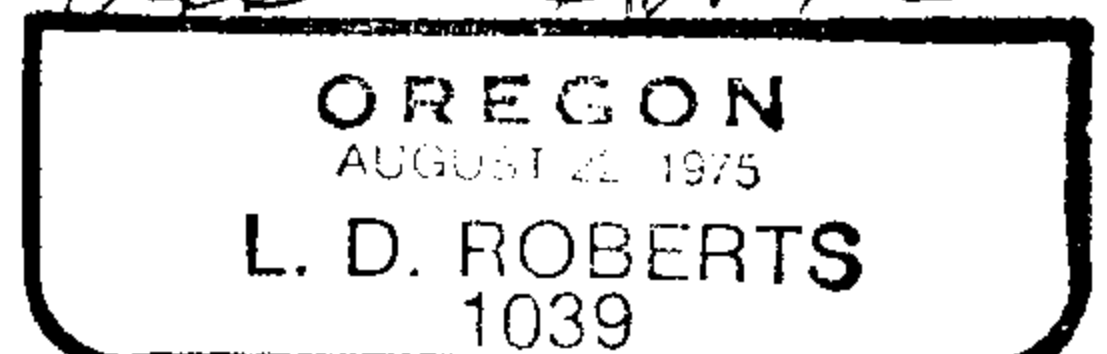

M102-18

FILED

OREGON CORNER RESTORATION FORM

JUL 23 1986

Section 3 Township 22S Range 8W

COUNTY SURVEYOR
DOUGLAS COUNTY, ORE.

County Douglas Date 06-03-86

Corner Designation

N.E. 1/16 Corner
Section 3





- Condition Report Only
- Not Found
- Renewed
- Unrecorded
- Surveyed In
- Referenced Out

Previous Renewals/Surveys, etc. None

Monument(s) & Accessories Found: (Condition and Source)

None

Monument Detail

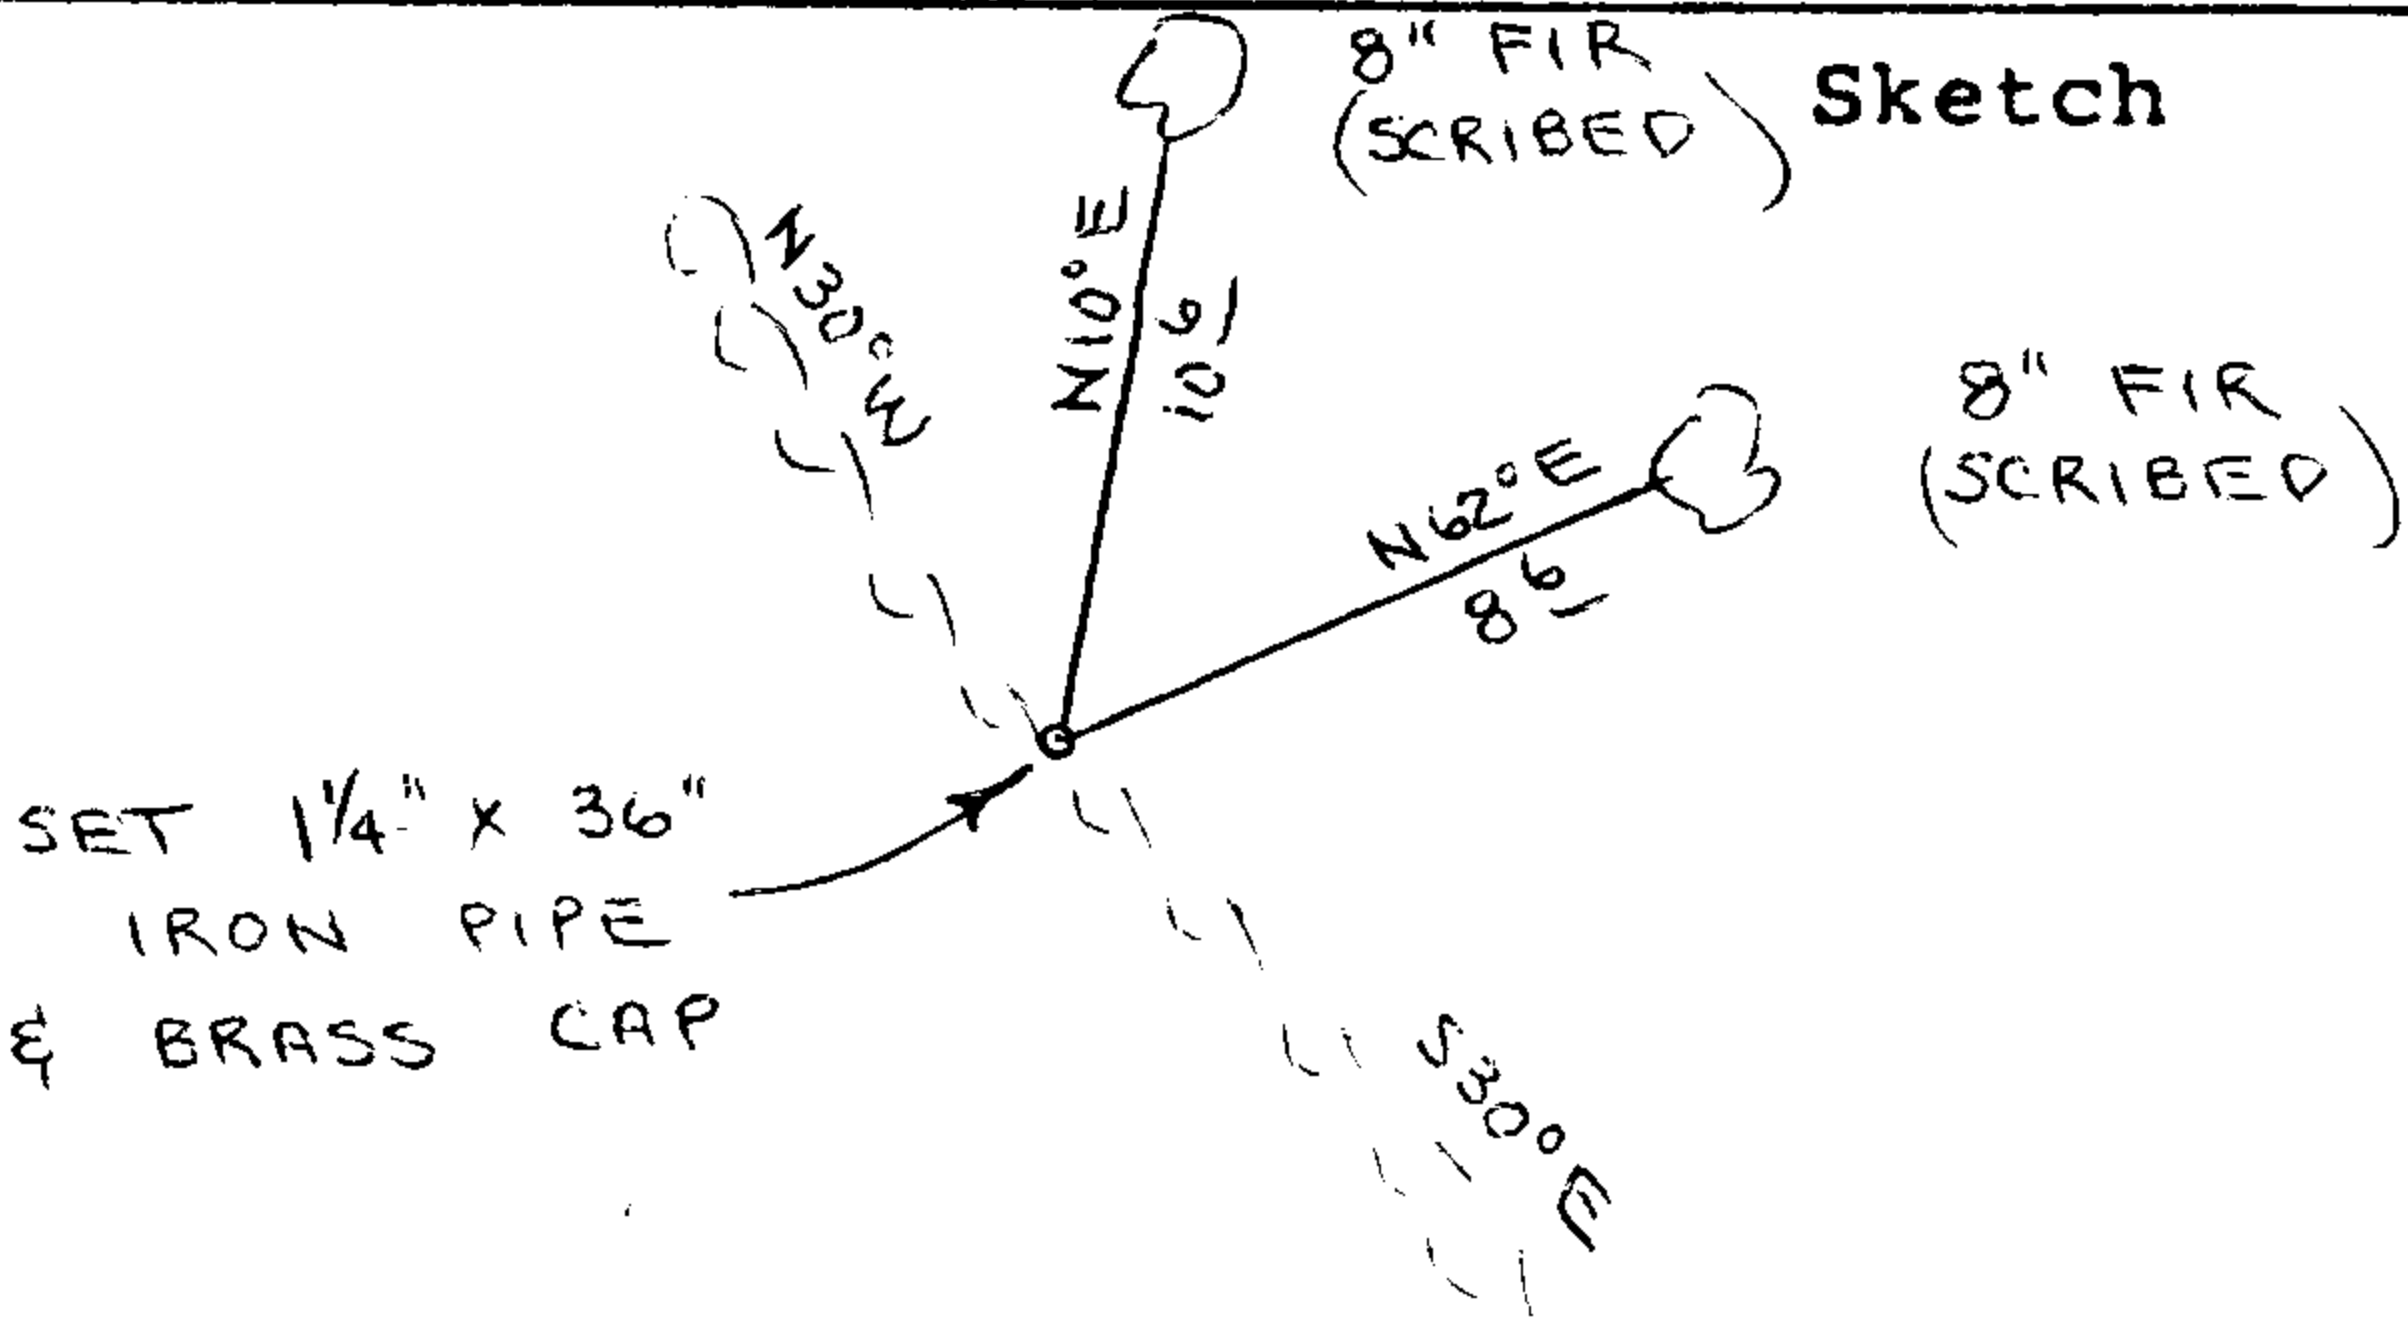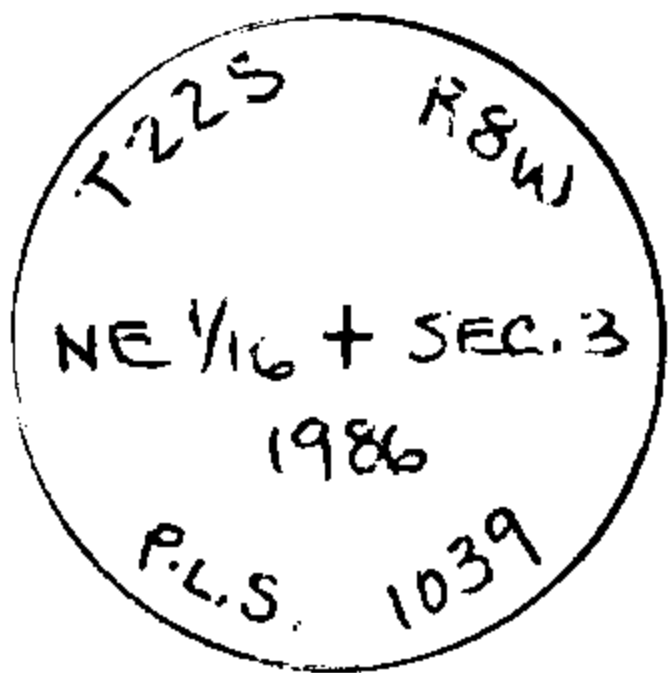

Monument Set (Procedures and Description)

Set 1 1/4" x 36" Iron Pipe and Brass Cap. Buried purple magnetic marker under 36" pipe. See filed survey for procedures.

New Accessories

8" Fir, N10E, 10.6' (Scribed/Painted Red)

8" Fir, N62E, 8.6' (Scribed/Painted Red)

Set metal fence post, with land survey monument sign wired to, beside brass cap. Painted all BT's red.

Location & Comments

Corner lies on top of flat ridge. Ridge runs N30W and S30E Compass Declination 20 1/2

Firm/Agency Roberts Surveying Inc.

Address 29 West 29th St.


Eugene, Oregon 97405

Party Chief Les Roberts


Notes Les Roberts

Witness Ted Baker

Surveyor's Seal

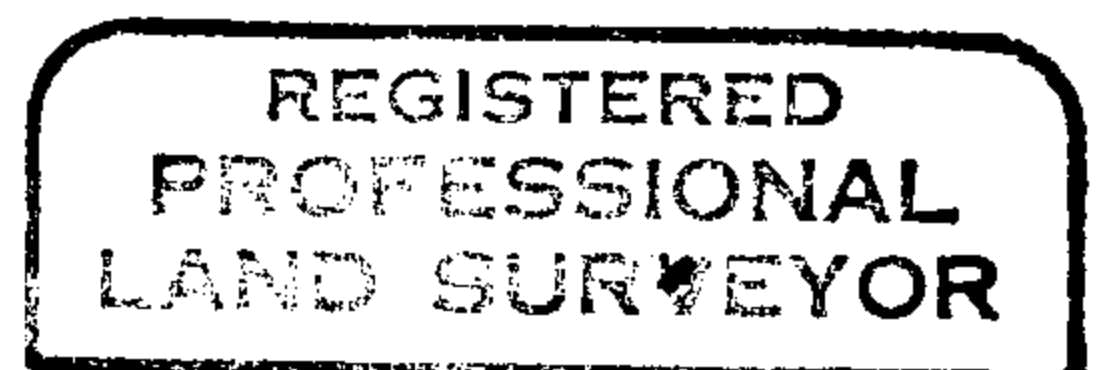

Les Roberts

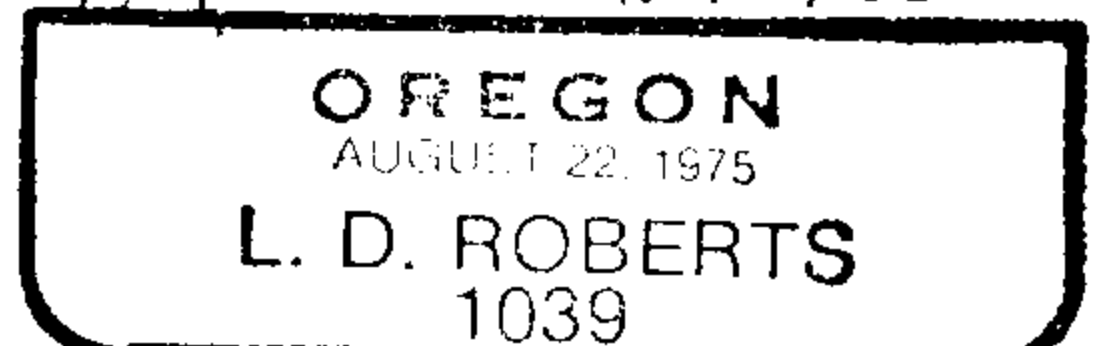

M 102-18

FILED

OREGON CORNER RESTORATION FORM

JUL 23 1986


Section 3 Township 22S Range 8W

COUNTY SURVEYOR
DOUGLAS COUNTY, ORE.

County Douglas Date 06-03-86

Corner Designation

C.E. 1/16 Corner
Section 3

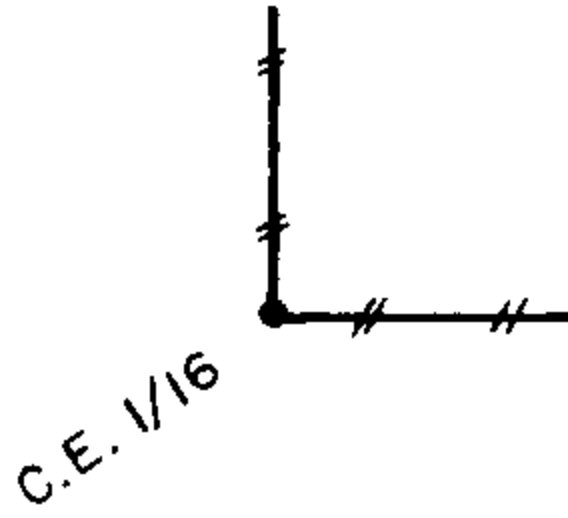


- Condition Report Only
- Not Found
- Renewed
- Unrecorded
- Surveyed In
- Referenced Out

Previous Renewals/Surveys, etc. None

Monument(s) & Accessories Found: (Condition and Source)

None

Monument Detail

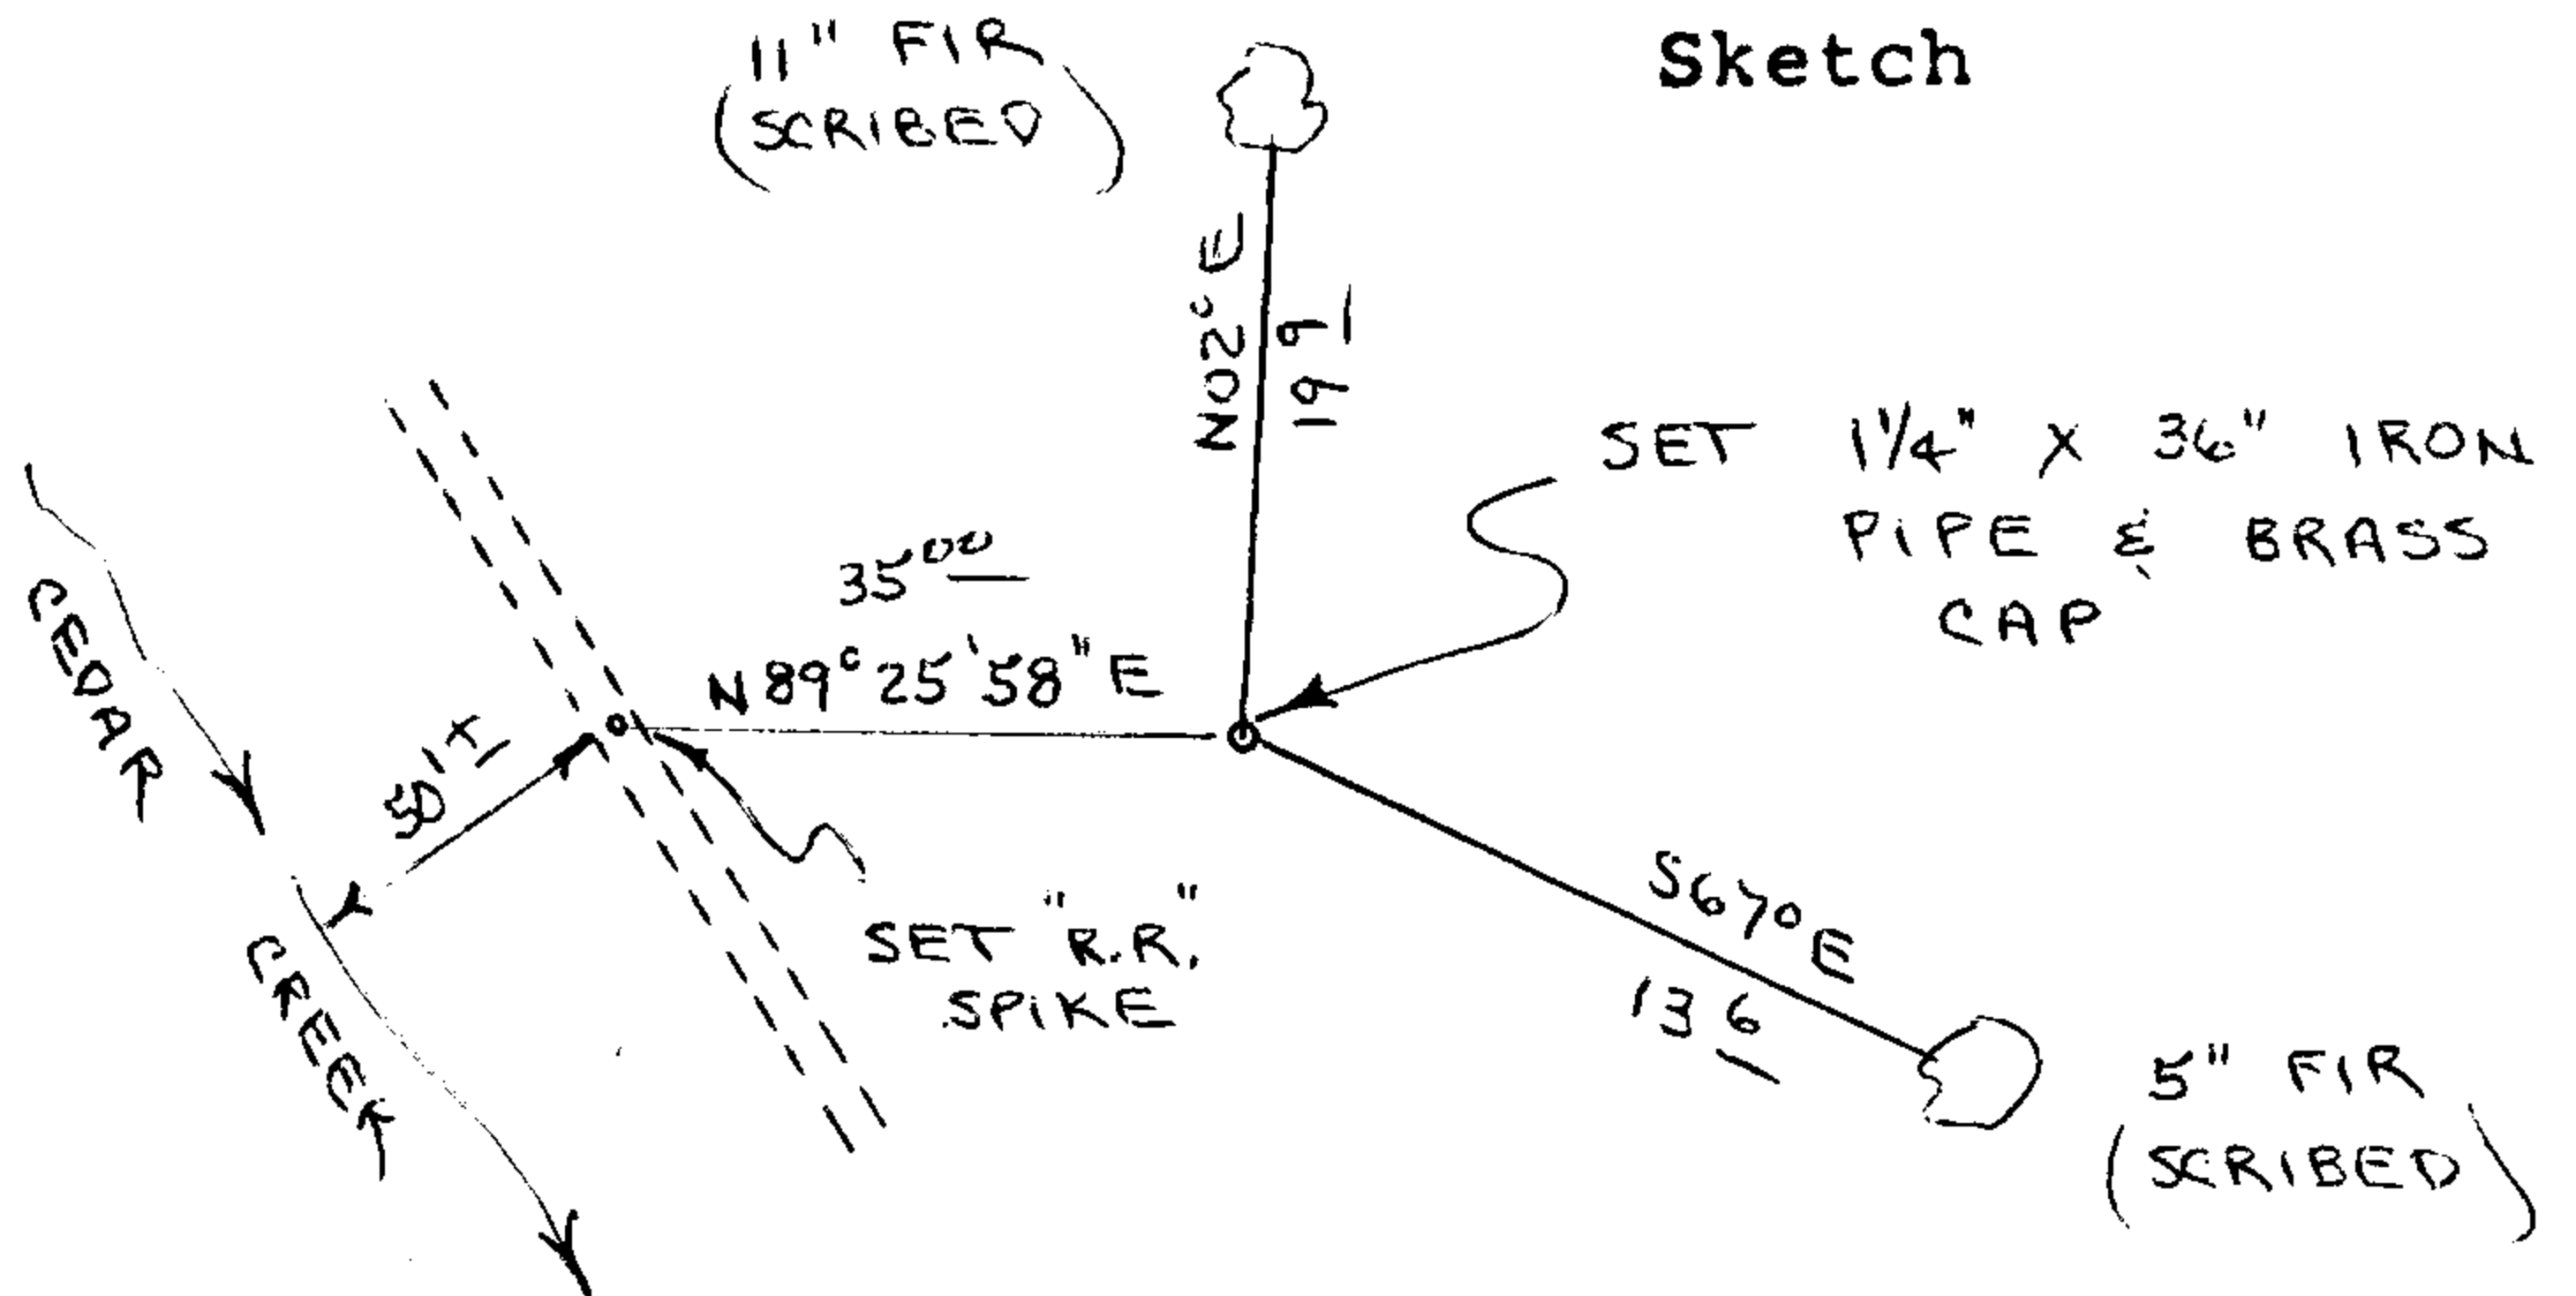

Sketch

Monument Set (Procedures and Description)

Set "R.R." Spike in Sandstone, 8" below ground, for true 1/16 corner. Set 1 1/4" x 36" Iron Pipe and Brass Cap for Witness Corner. Buried purple magnetic marker under 36" pipe. Witness Corner bears N 89° 25' 58" E, 35.00' from buried "R.R." Spike. See filed survey for procedures.

New Accessories

Accessories were set for Witness Corner only.

5" Fir, S67E, 13.6' (Scribed/Painted Red)

11" Fir, N02E, 19.9' (Scribed/Painted Red)


Set metal fence post, with land survey monument sign wired to, beside brass cap. Painted all BT's red.

Location & Comments

Corner falls in old dirt road about 50' East of Cedar Creek

Compass Declination 20 1/2
Firm/Agency Roberts Surveying Inc.
Address 29 West 29th St. Eugene, Oregon 97405
Party Chief Les Roberts
Notes Ted Baker
Witness _____

Surveyor's Seal

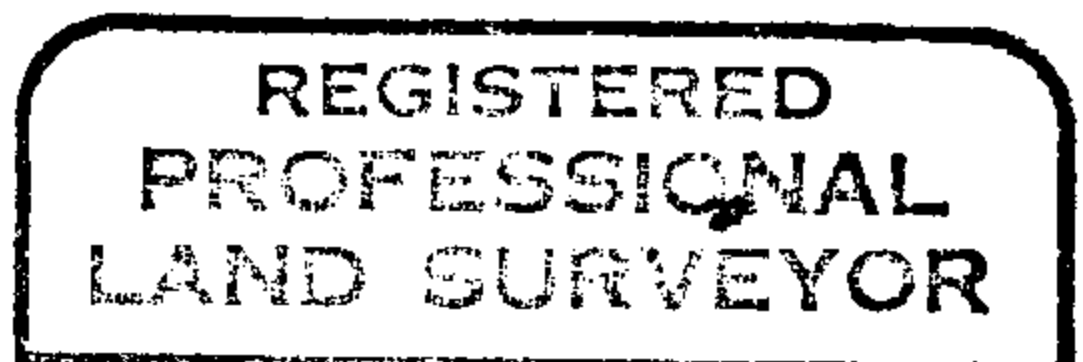

Les Roberts
OREGON
AUGUST 22, 1975
L. D. ROBERTS
1039

M7102-18

FILED

JLR

JUL 23 1986

OREGON CORNER RESTORATION FORM


Section 3 Township 22S Range 8W

County Douglas Date 05-19-86

COUNTY SURVEYOR
DOUGLAS COUNTY, ORE.

Corner Designation

S.E. Corner
Section 3

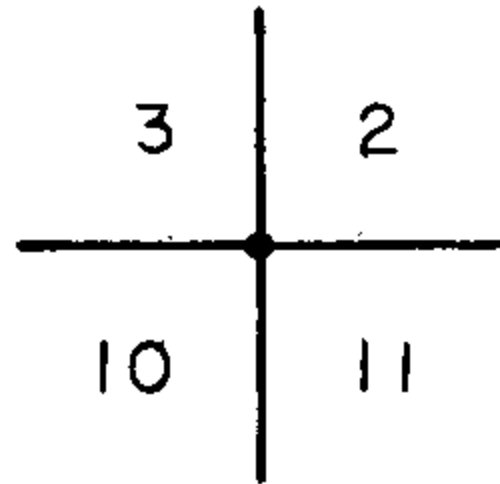

- Condition Report Only
- Not Found
- Renewed
- Unrecorded
- Surveyed In
- Referenced Out

Previous Renewals/Surveys, etc. 1962 Douglas County Renewal and 1965 B.L.M. Survey

Monument(s) & Accessories Found: (Condition and Source)


Found 1962 Douglas County Brass Cap set firmly in ground on East-West fence line.

23" Fir, N41E, 34.5' (Scar Vis.), 1962 BT. Rec. N41E, 34.0'

23" Fir, N60W, 76.6' (Scar Vis.), 1962 BT. Rec. N59W, 77.3'

25" Fir, S33W, 57.4' (Scar Vis.), 1962 BT. Rec. S33½W, 57.2'

Monument Detail

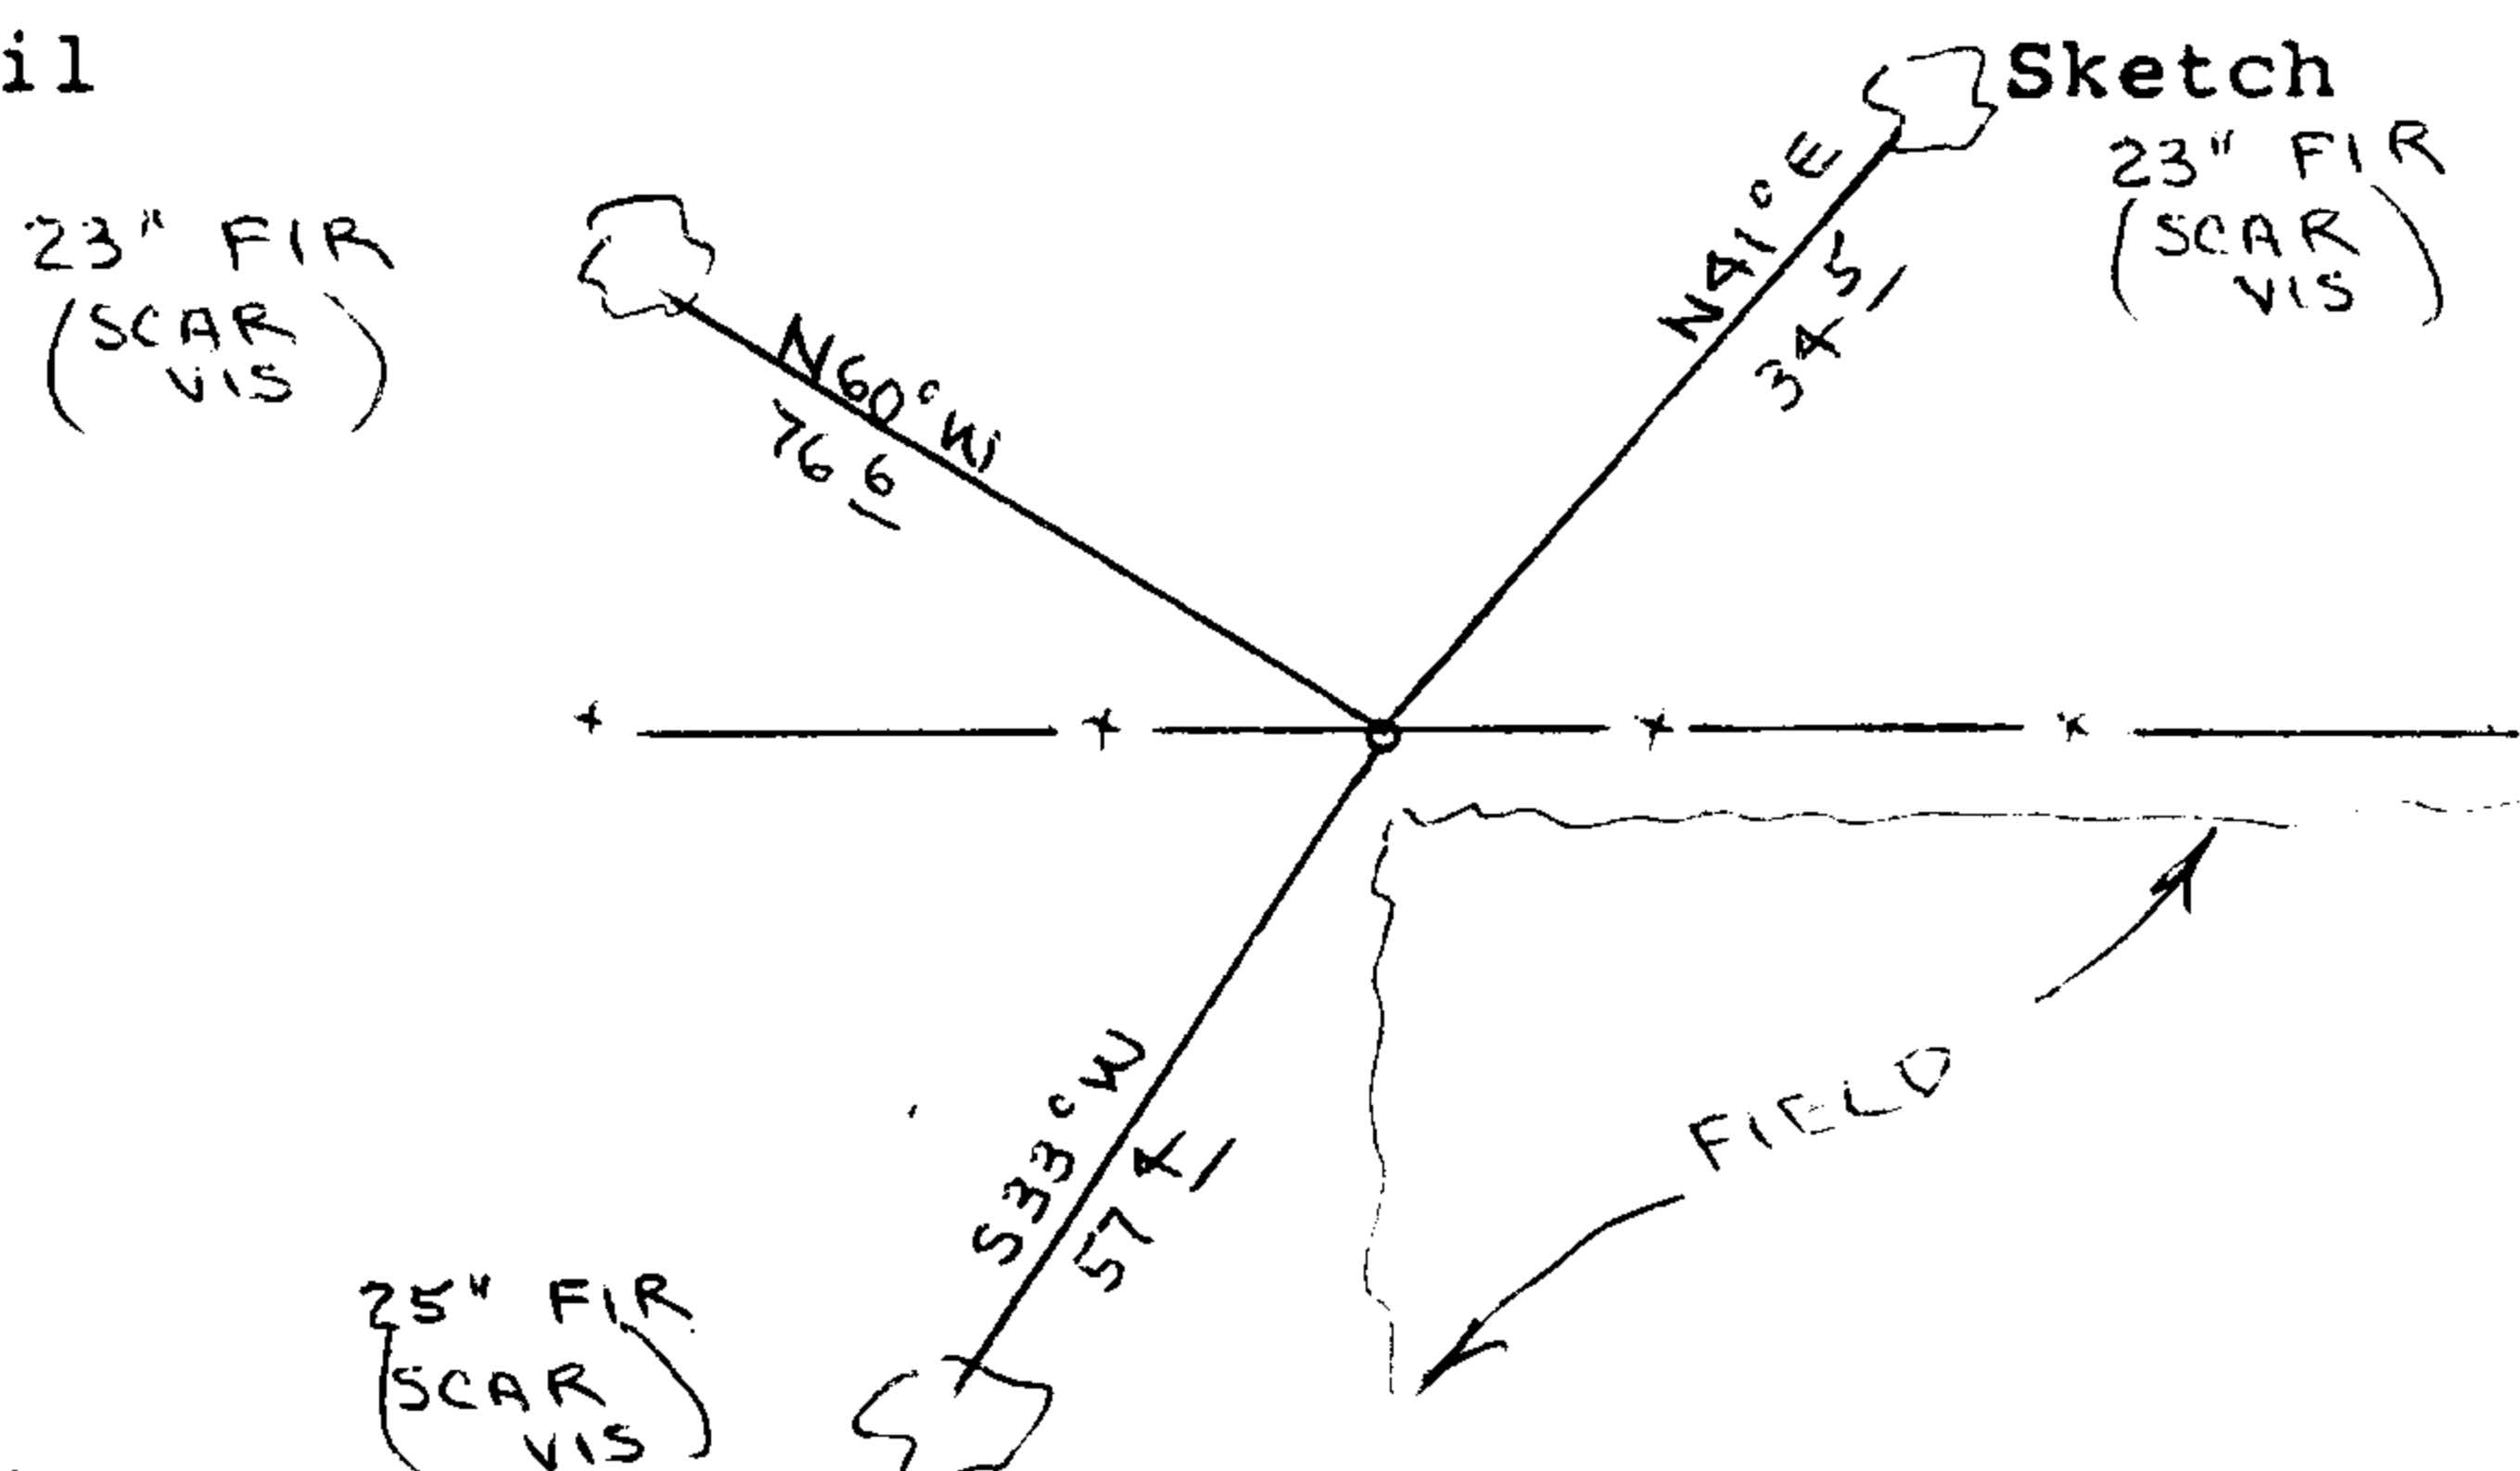

Monument Set (Procedures and Description)

New Accessories

Set metal fence post, with survey attention sign wired to, beside brass cap. Painted all BT's red.

Location & Comments

Corner lies on West slope at the N.W. corner of a large field.

Compass Declination 20½

Firm/Agency Roberts Surveying Inc.

Address 29 West 29th St.

Eugene, Oregon 97405

Party Chief Les Roberts

Notes Ted Baker

Witness _____

Surveyor's Seal

REGISTERED
PROFESSIONAL
LAND SURVEYOR

Les Roberts

OREGON
AUGUST 22, 1975
L. D. ROBERTS
1039

M102-18

FILED

JS

OREGON CORNER RESTORATION FORM

JUL 23 1986


Section 3 Township 22S Range 8W

County Douglas Date 5-30-86

COUNTY SURVEYOR
DOUGLAS COUNTY, ORE.

Corner Designation

S.W. Corner
Section 3

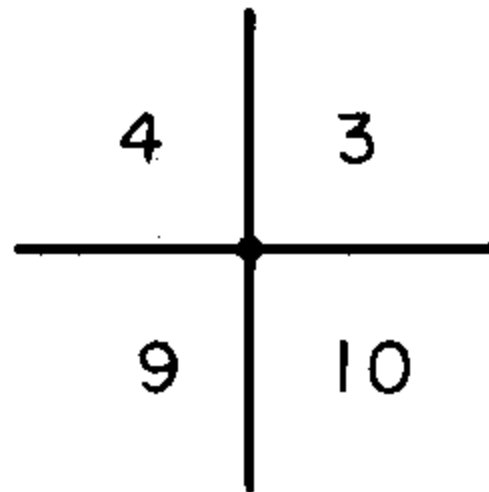

- Condition Report Only
- Not Found
- Renewed
- Unrecorded
- Surveyed In
- Referenced Out

Previous Renewals/Surveys, etc. 1962 Douglas County Renewal and 1965 B.L.M. Survey.

Monument(s) & Accessories Found: (Condition and Source)

- Found 1962 Douglas County Brass Cap Set firmly in ground.
- 18" Fir Stub, N63E, 31.3' (Scribe Vis.), 1881 BT. Rec. N62E, 31.0'
- 24" Fir Stump, N45W, 56.8' (No Marks), 1962 BT. Rec. N45W, 56.8'
- 26" W. Fir, S73E, 68.6' (Scar Vis.), 1962 BT. Rec. S73E, 68.0'
- 30" W. Fir, S38W, 28.8' (Scar Vis.), 1962 BT. Rec. S38 1/2 W, 28.6'
- 30" W. Fir, N76E, 89.7' (Scar Vis.), 1962 BT. Rec. N76 1/2 E, 88.6'

Monument Detail

24" FIR STUMP
(NO MARKS)

N45W
56.8

FD. 1962 DOUGLAS COUNTY BRASS CAP

30" W. FIR
(SCAR VIS.)

S38W
28.8

Sketch

18" FIR STUB
(SCRIBE VIS)

N63E
31.3

N76E
89.7

30" W. FIR
(SCAR VIS)

S73E
68.6

26" W. FIR
(SCAR VIS)

Monument Set (Procedures and Description)

Set metal fence post, with survey attention sign wired to, beside Brass Cap. Painted all BT's red.

New Accessories

None

Location & Comments

Corner lies on SE slope about 12' above small flat.

Compass Declination 20 1/2

Firm/Agency Roberts Surveying Inc.

Address 29 West 29th St. Eugene, Oregon 97405

Party Chief Les Roberts

Notes Les Roberts

Witness Ted Baker

Surveyor's Seal

REGISTERED PROFESSIONAL LAND SURVEYOR

Les Roberts

OREGON
AUGUST 22 1975
L. D. ROBERTS
1039

C.S. File No. 63/18-59

W7102-18

FILED *JR*

OREGON CORNER RESTORATION FORM

JUL 23 1986


Section 3 Township 22S Range 8W

COUNTY SURVEYOR
DOUGLAS COUNTY, ORE.

County Douglas Date 05-19-86

Corner Designation

South $\frac{1}{4}$ Corner
Section 3

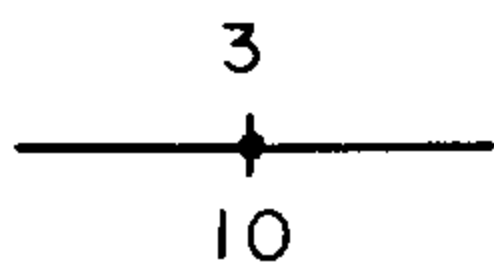

- Condition Report Only
- Not Found
- Renewed
- Unrecorded
- Surveyed In
- Referenced Out

Previous Renewals/Surveys, etc. 1965 B.L.M. Survey


Monument(s) & Accessories Found: (Condition and Source)

Found 1965 B.L.M. Brass Cap set firmly in ground.

18" W. Fir, S71E, 94.8' (Scar Vis.), 1965 BT. Rec. S73E, 94.4'

20" Fir, N46E, 51.3' (Scar Vis.), 1965 BT. Rec. N43 1/2 E, 51.5'

Monument Detail

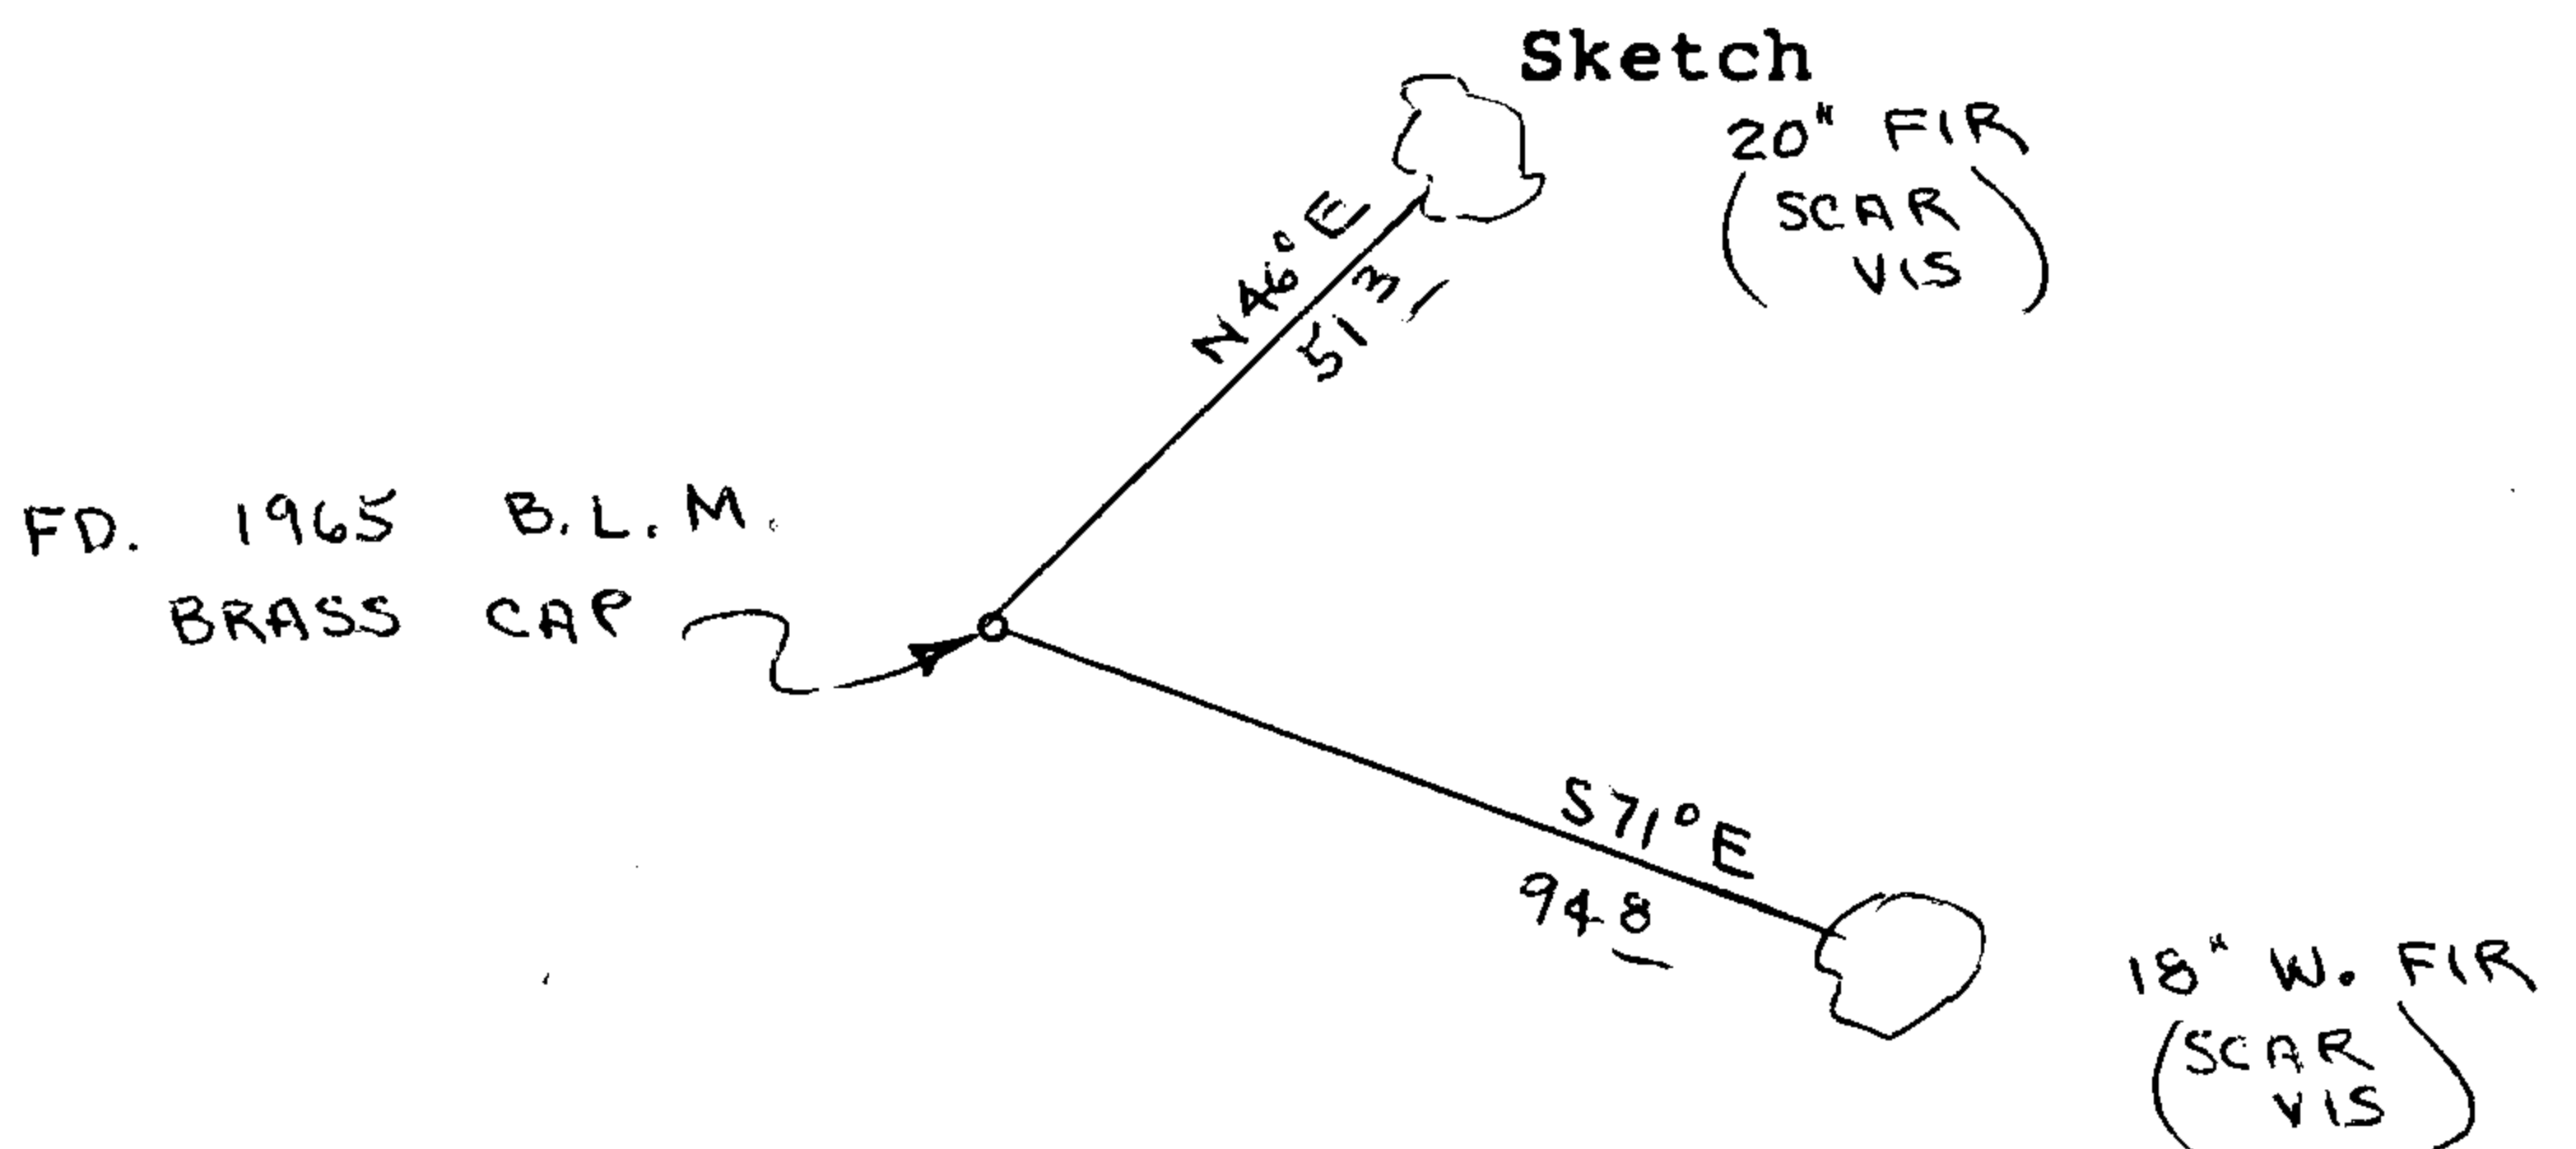

Monument Set (Procedures and Description)

New Accessories

Set metal fence post, with survey attention sign wired to, beside brass cap. Painted all BT's red.

Location & Comments

Corner lies on SE slope about 770' East of N-S ridge.

Compass Declination 20 1/2

Firm/Agency Roberts Surveying Inc.

Address 29 West 29th St. Eugene, Oregon 97405

Party Chief Les Roberts

Notes Ted Baker

Witness Ted Baker

Surveyor's Seal

REGISTERED
PROFESSIONAL
LAND SURVEYOR

Les Roberts

OREGON
AUGUST 22, 1975
L. D. ROBERTS
1039

C.S. File No. 63/18-54

V

117102-18

FILED

JS

OREGON CORNER RESTORATION FORM

JUL 23 1986


Section 3 Township 22S Range 8W

County Douglas Date 05-21-86

COUNTY SURVEYOR
DOUGLAS COUNTY, ORE.

Corner Designation

North $\frac{1}{4}$ Corner
Section 3 Only

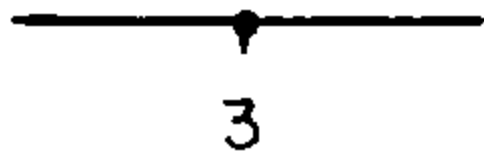

- Condition Report Only
- Not Found
- Renewed
- Unrecorded
- Surveyed In
- Referenced Out

Previous Renewals/Surveys, etc. 1945 and 1952 G.L.O. Surveys

Monument(s) & Accessories Found: (Condition and Source)


Found 1952 G.L.O. Brass Cap set firmly in ground.

36" Fir, S08W, 80.8' (Scar Vis), 1952 BT. Rec. S7°3/4W, 81.8'

42" Fir, S62E, 33.5' (Scar Vis), 1952 BT. Rec. S63E, 34.3'

Monument Detail

Sketch

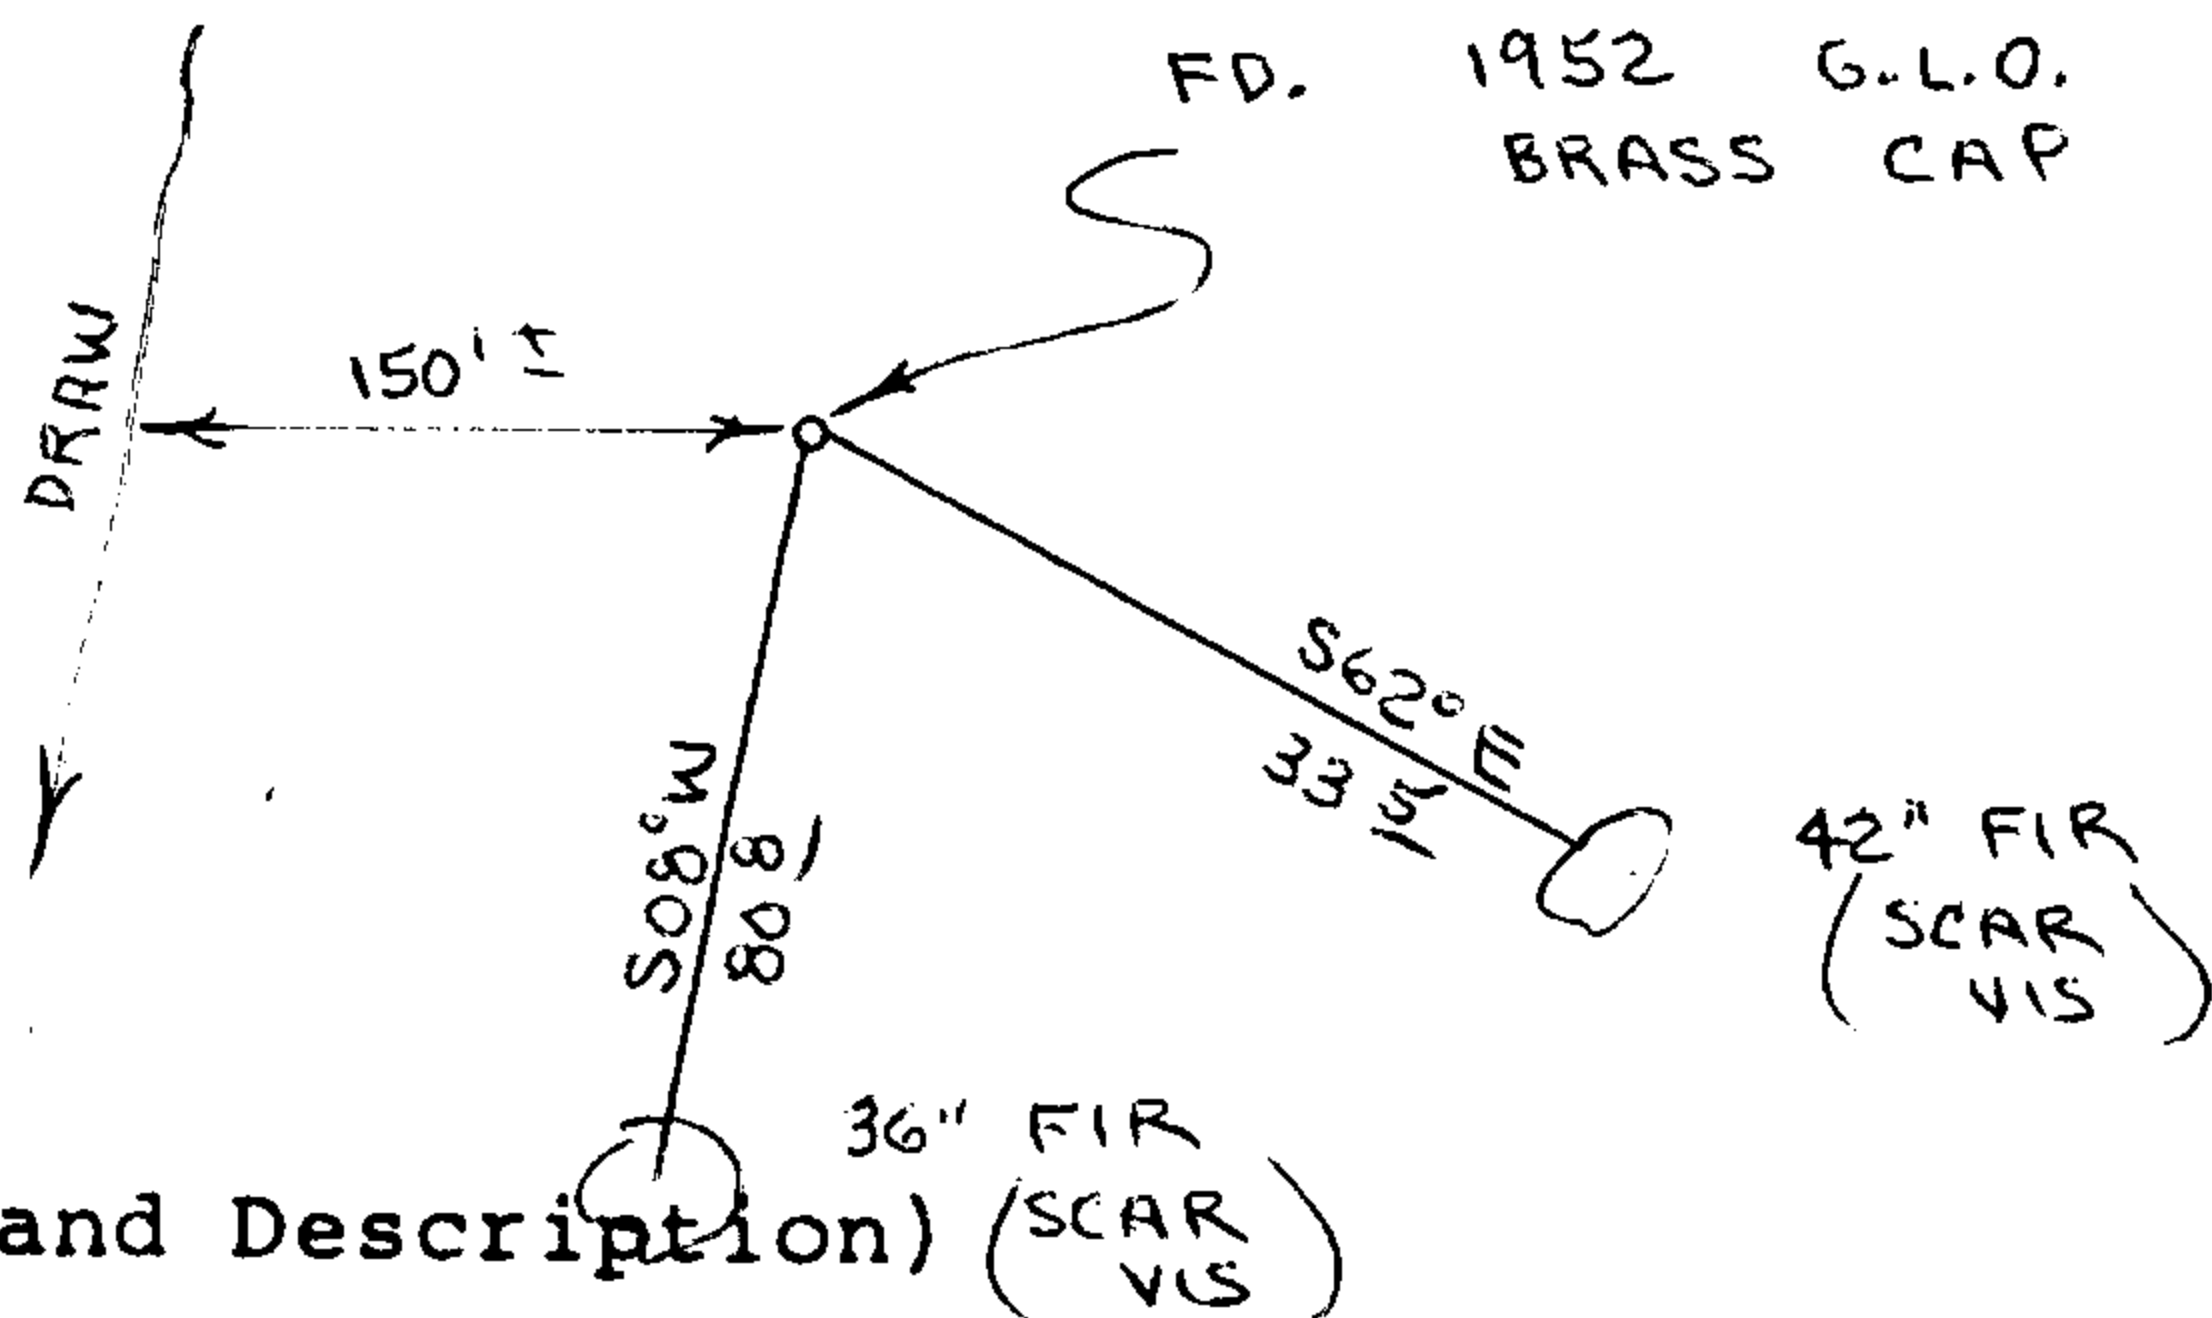

Monument Set (Procedures and Description) (SCAR VIS)

New Accessories

Set metal fence post, with survey attention sign wired to, beside brass cap. Painted all BT's red.

Location & Comments

Corner lies on steep south slope about 150' East of small draw

Compass Declination 20 $\frac{1}{2}$

Firm/Agency Roberts Surveying Inc.


Address 29 West 29th St. Eugene, Oregon 97405

Party Chief Les Roberts

Notes Ted Baker

Witness _____

Surveyor's Seal

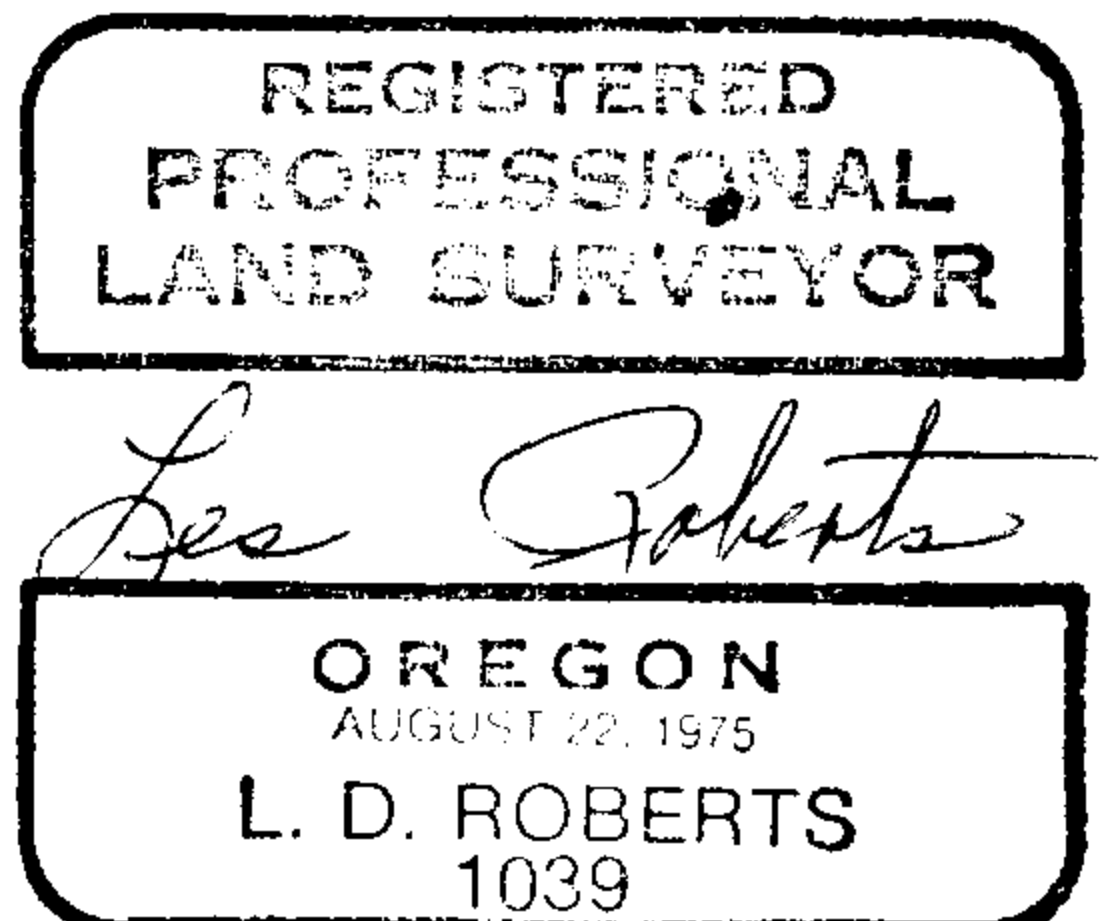

C.S. File No. 63/18-51

M102-18

FILED

LR

JUL 23 1986

OREGON CORNER RESTORATION FORM


Section 3 Township 22S Range 8W

COUNTY SURVEYOR
DOUGLAS COUNTY, ORE.

County Douglas Date 05-20-86

Corner Designation

West $\frac{1}{4}$ Corner
Section 3

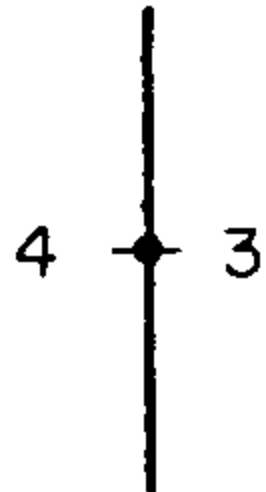

- Condition Report Only
- Not Found
- Renewed
- Unrecorded
- Surveyed In
- Referenced Out

Previous Renewals/Surveys, etc. None

Monument(s) & Accessories Found: (Condition and Source)

No Corner Monument Found.

Fd. 48" Fir Stump, N68E, 109.5' (Scribe Vis.), 1881 BT.


Record N68E, 109.5'

Fd. 68" Fir, N62W, 141.2' (Scar Vis.), 1881 BT.

Record N62W, 120.1'

Monument Detail

Sketch

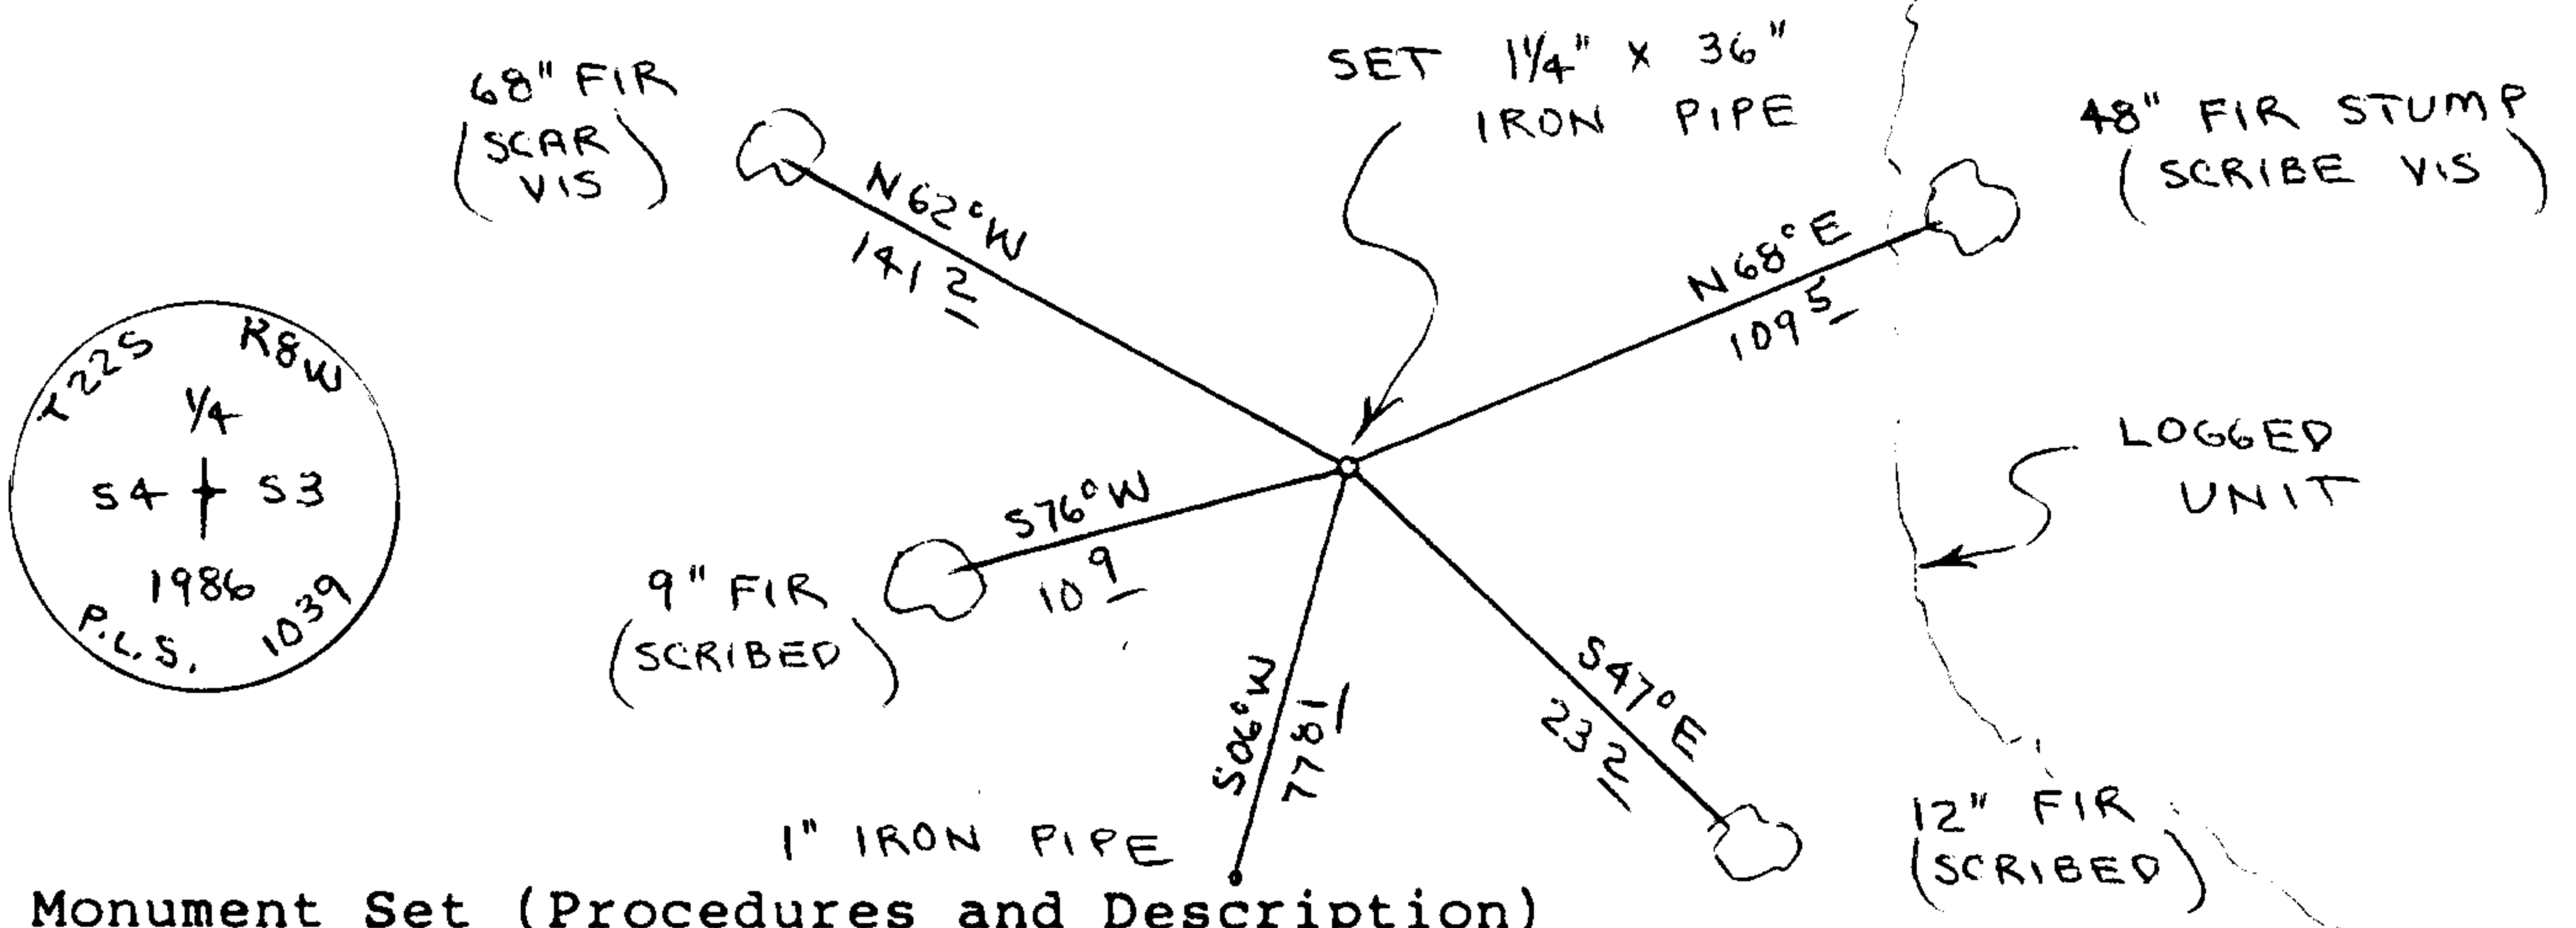

Monument Set (Procedures and Description)

Set $1\frac{1}{4}$ " x 36" Iron Pipe and Brass Cap. Buried Purple Magnetic Marker under 36" Pipe. Corner set by using record data from original NE BT. NW BT. fits for bearing but not for distance as noted. Old 1" Iron Pipe bears S $6^{\circ}20'15''$ W, 77.81'.

New Accessories

9" Fir, S76W, 10.9' (Scribed/Painted Red)

12" Fir, S47E, 23.2' (Scribed/Painted Red)

Set metal fence post, with survey monument sign wired to, beside Brass Cap. Painted all BT's red.

Location & Comments

Corner lies on West slope about 50' West of 10 year old logged unit.

Compass Declination $20\frac{1}{2}$
Firm/Agency Roberts Surveying Inc.
Address 29 West 29th St. Eugene, Oregon 97405
Party Chief Les Roberts
Notes Les Roberts
Witness Ted Baker

Surveyor's Seal



#164 x

C.S. File No. 63/18-55

M1102-18

FILED

LR

OREGON CORNER RESTORATION FORM

JUL 23 1986

Section 34 Township 21S Range 8W

COUNTY SURVEYOR
DOUGLAS COUNTY, ORE.

County Douglas Date 05-19-86

Corner Designation

South $\frac{1}{4}$ Corner
Section 34 Only

34
—+—

- Condition Report Only
- Not Found
- Renewed
- Unrecorded
- Surveyed In
- Referenced Out

Previous Renewals/Surveys, etc. 1945 and 1952 G.L.O. Surveys


Monument(s) & Accessories Found: (Condition and Source)

Found 1952 G.L.O. Brass Cap set firmly in ground, marked W.C.
30" Corner tree bears West 1.98'

24" Fir Stump, N54E, 25.2' (Scribe Vis.), 1952 BT.

Record N54 $\frac{1}{2}$ E, 25.7'

Monument Detail

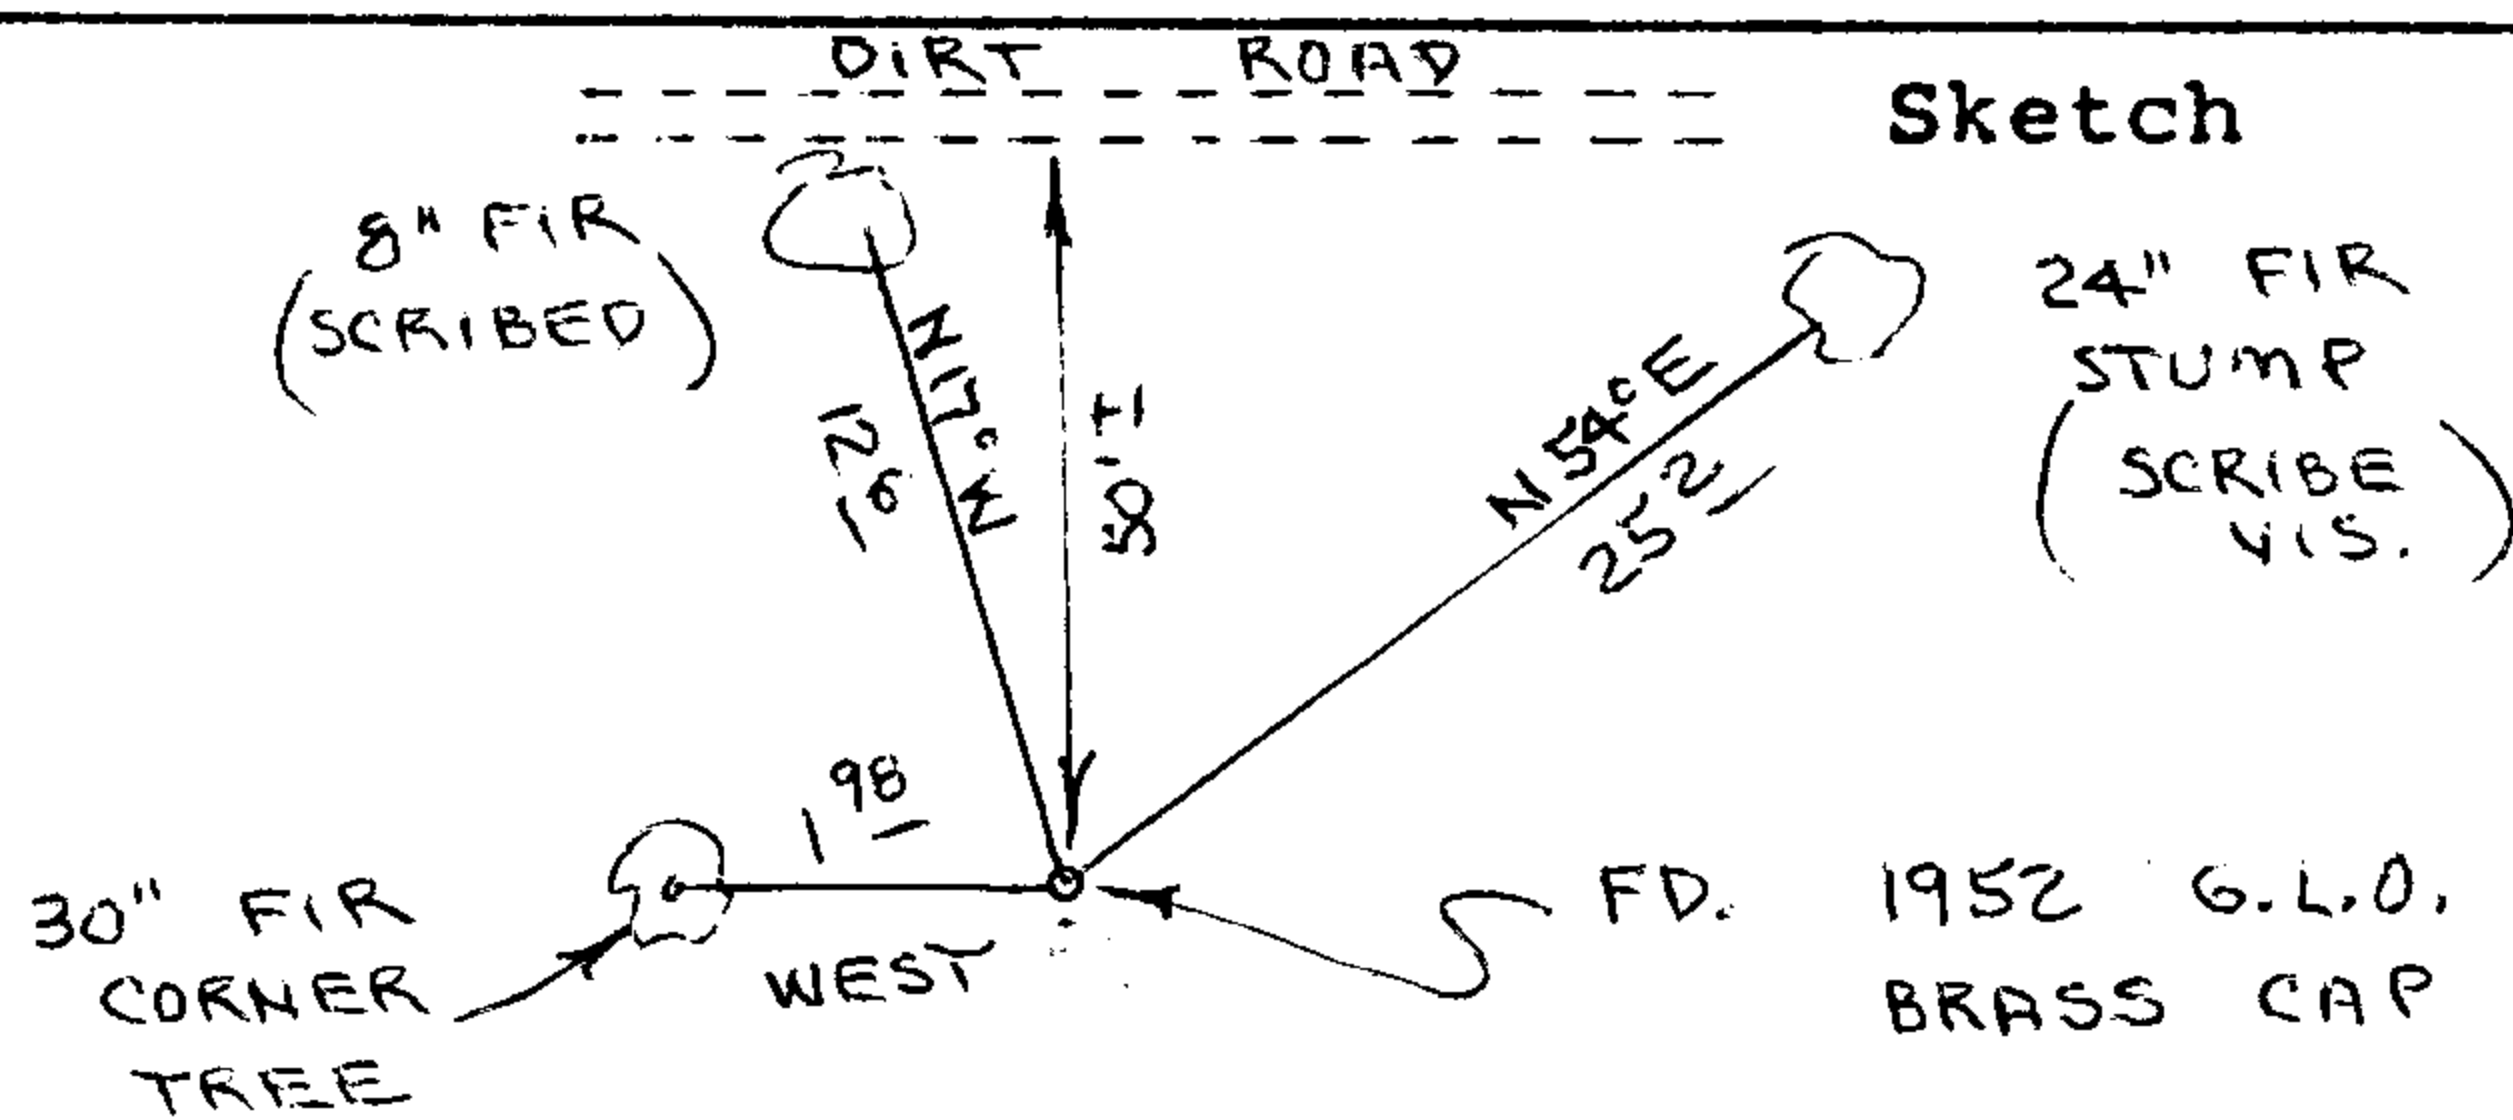

Monument Set (Procedures and Description)

New Accessories

Set 8" Fir, N17W, 12.6' (Scribed/Painted Red)

Set metal fence post, with survey attention sign wired to, beside brass cap. Painted all BT's red.

Location & Comments

Corner lies on South slope about 50' South of old dirt logging road.

Compass Declination 20 $\frac{1}{2}$

Firm/Agency Roberts Surveying Inc.


Address 29 West 29th St. Eugene, Oregon 97405

Party Chief Les Roberts

Notes Ted Baker

Witness _____

Surveyor's Seal

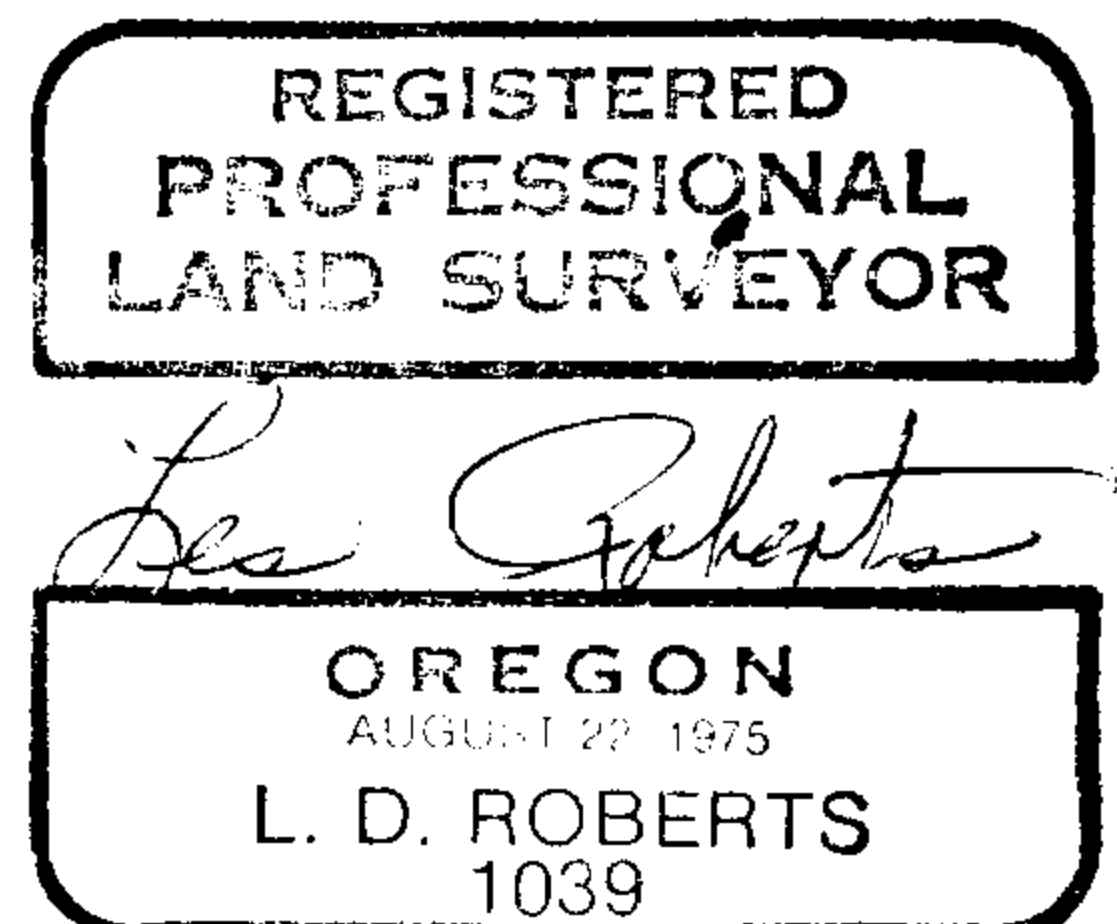

#165 T22-8 X
#32 4

C.S. File No. 63/18-5K

M 162-18

FILED

JUL 23 1986

OREGON CORNER RESTORATION FORM


Section 3 Township 22S Range 8W

COUNTY SURVEYOR
DOUGLAS COUNTY, ORE.

County Douglas Date 06-03-86

Corner Designation

East $\frac{1}{4}$ Corner
Section 3

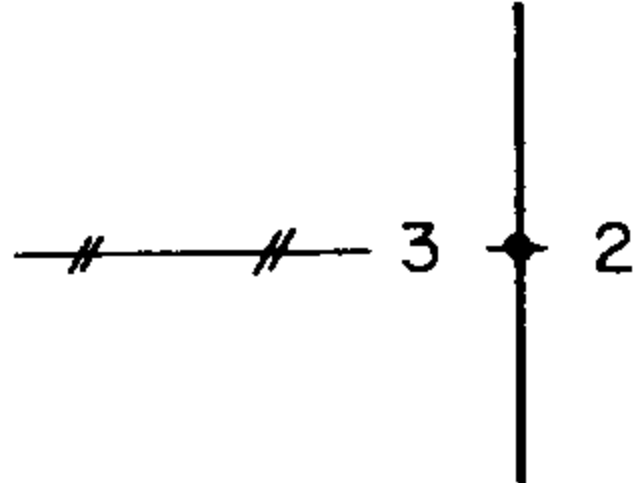


- Condition Report Only
- Not Found
- Renewed
- Unrecorded
- Surveyed In
- Referenced Out

Previous Renewals/Surveys, etc. None

Monument(s) & Accessories Found: (Condition and Source)

None

Monument Detail

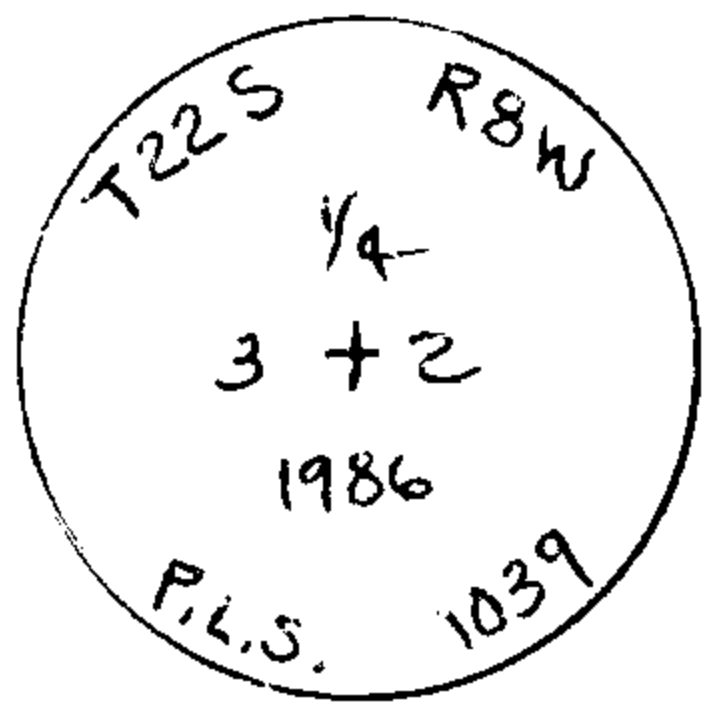


SET $1\frac{1}{4}$ " x 36"
IRON PIPE &
BRASS CAP

30" FIR
(SCRIBED)

10" FIR
(SCRIBED)

Sketch

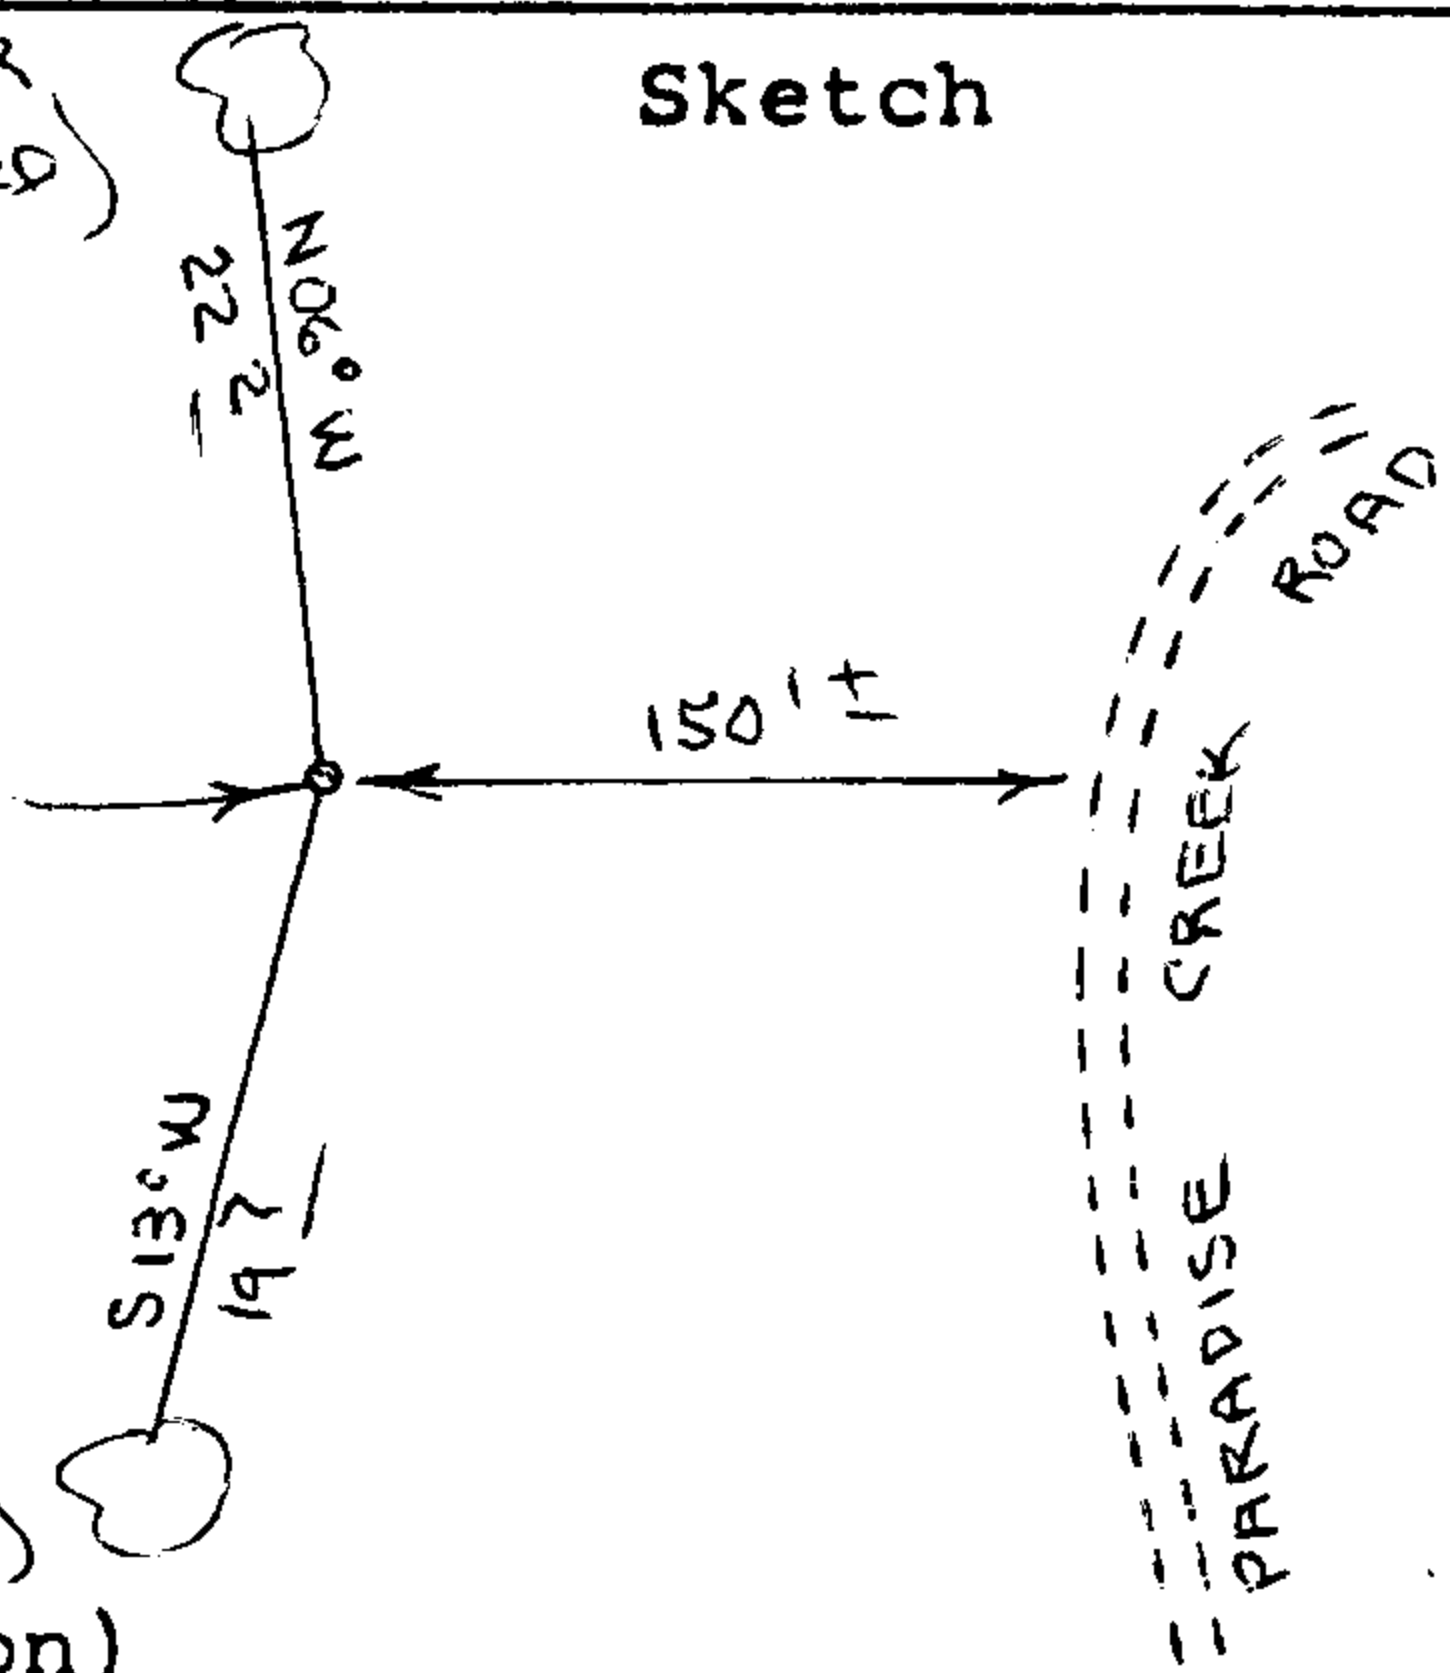

Monument Set (Procedures and Description)

Set $1\frac{1}{4}$ " x 36" Iron Pipe and Brass Cap. Purple magnetic marker buried under 36" pipe. See filed survey for procedures.

New Accessories

10" Fir, S13W, 19.7' (Scribed/Painted Red)

30" Fir, N06W, 22.2' (Scribed/Painted Red)

Set metal fence post, with land survey monument sign wired to beside brass cap. Painted all BT's red.

Location & Comments

Corner lies on steep Compass Declination 20 $\frac{1}{2}$
East slope about 150' Firm/Agency Roberts
West of Paradise Surveying Inc.
Creek Road Address 29 West 29th St.
Eugene, Oregon 97405
Party Chief Les Roberts
Notes Ted Baker
Witness

Surveyor's Seal

REGISTERED
PROFESSIONAL
LAND SURVEYOR

Les Roberts
OREGON
AUGUST 22 1975
L. D. ROBERTS
1039

#163

J.S. File No. 63/18 -5L
C