

FILED
RECEIVED *JL*

AUG 12 1985

OREGON CORNER RESTORATION FORM

Section 20 Township 28S Range 8W

County DOUGLAS Date 7/16/85

COUNTY SURVEYOR
DOUGLAS COUNTY, ORE.

Corner Designation

W 1/4

- Condition Report Only
- Not Found
- Renewed
- Unrecorded
- Surveyed In
- Referenced Out

Previous Renewals/Surveys, etc.

PROPORTIONED IN BY 1972 B.L.M. SURVEY

Monument(s) & Accessories Found: (Condition and Source)

3 1/2" BRASS CAP ON A 2 1/2" IRON PIPE, EXTENDING 5" ABOVE GROUND,
ALSO FOUND 2 BT's:

34" CEDAR BEARS N61°E, 34⁶⁷ FT. (REC. = 36²⁶)
SCRIBING VISIBLE

12" HEMLOCK BEARS S67°W, 35⁸⁰ FT. (REC. = 34⁹⁸ FT.)
(CLOSED) FACE

Monument Detail

Sketch

T28S R8W

1/4

S19 | S20

1972

Monument Set (Procedures and Description)

New Accessories

Location & Comments

Compass Declination 20°E

Firm/Agency _____

CHAMPION INTL. CORP.

Address P.O. Box 132B


ROSEBURG, OR. 97470

Party Chief RON GEISLER

Notes LYNN SIBLEY

Witness DEAN TURNER

Surveyor's Seal

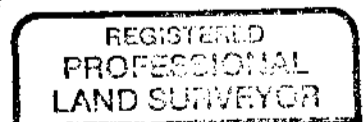

Ronald G. Geisler

