

OREGON CORNER RESTORATION FORM

Section 18 Township 24S Range 3W

County DOUGLAS Date 10-25-85

Revised 11/11/85

Corner Designation

N.W. SEC. COR.

- Condition Report Only
- Not Found
- Renewed
- Unrecorded
- Surveyed In
- Referenced Out

Previous Renewals/Surveys, etc.

SET IN 1950 BY B.L.M.

Monument(s) & Accessories Found: (Condition and Source)

2 1/2" BRASS CAP ON A 2" I.P., EXTENDING 14" ABOVE GROUND.

22" CEDAR SNAG BEARS S82°E, 62²² FT. (REL. = S85°E, 61³⁸ FT.) SCRIBING PARTIALLY VISIBLE 1950

#28 24-3
#12 24-4

Monument Detail

Sketch

T24S	T24S
R4W	S7
S13	S18
	R3W

1950

Monument Set (Procedures and Description)

New Accessories

16" FIR BEARS S38°E, 69² FT.

SCRIBED: T24S R3W S18 BT


14" FIR BEARS N59°E, 77² FT.

SCRIBED: T24S R3W S7 BT

Location & Comments

 _____ Compass Declination 19°45'E
 _____ Firm/Agency CHAMPION INTL. CORP.
 _____ Address P.O. Box 132R
 _____ ROSEBURG, OR. 97470
 _____ Party Chief L. SIBLEY
 _____ Notes D. TURNER
 _____ Witness _____

Surveyor's Seal

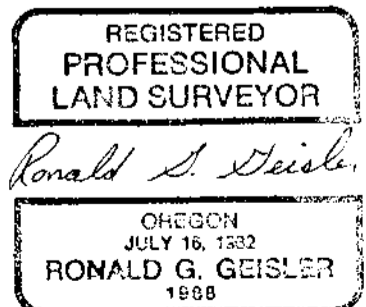

#116 T24-3
#171 T24-4