

OREGON CORNER RESTORATION FORM

Section 18 Township 24S Range 3W

County Douglas Date Oct., 85

Corner Designation

N.E. Sec. Cor.

- Condition Report Only
- Not Found
- Renewed ACCESSORIES
- Unrecorded
- Surveyed In
- Referenced Out

Previous Renewals/Surveys, etc.

SET IN 1950 BY B.L.M.

Monument(s) & Accessories Found: (Condition and Source)

U.S. General Land office survey; 2 1/2" Brass cap on a 2" I.P. extends 14" above ground.

- 19" Fir "BT" bears S02°W; 76⁵⁷ Ft. "closed face" (1950) (Rec. = 27⁷²)
- Root Hole bears S87 1/2° E; 6⁶ Ft. - "BT" down & uprooted. (1950)
- 3/4" Fir stump "BT" bears N85 1/2° W; 35⁶⁴ Ft. - No scribing visible (1950)
- (1950)
- ROOT HOLE BEARS N26° E, 9⁹ FT. (1950)

Monument Detail

Sketch

T24S R3W

57	58
518	517

1950

Monument Set (Procedures and Description)

New Accessories

"BT" 22" Cedar bears N65°W; 19⁹⁰ Ft. and scribed "T24S R3W 57 B.T."

"BT" 22" Cedar bears S75°E; 38²⁵ Ft. and scribed "T24S R3W 517 BT"

"BT" 4" Fir bears N51°E; 29²⁶ Ft. scribed "X BT"

Location & Comments

Surveyor's Seal

Compass Declination 19°45'E

Firm/Agency CHAMPION

INTL. CORP.

Address P.O. Box 132B

ROSEBURG, OR. 97470


Party Chief R. GEISLER

Notes C. SIBLEY

Witness D. TURNER



Ronald G. Geisler

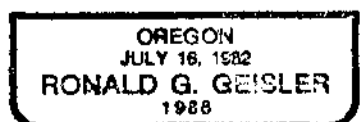

#113 ✕

U.S. File No. 63/22-9 c