

OREGON CORNER RESTORATION FORM

Section 18 Township 24S Range 3W

County Douglas Date 10-9-85

Corner Designation

SE. Cor. S. 18

- Condition Report Only
- Not Found
- Renewed - ACCESSORY
- Unrecorded
- Surveyed In
- Referenced Out

Previous Renewals/Surveys, etc.

SET IN 1950 BY B.L.M.

Monument(s) & Accessories Found: (Condition and Source)

2 1/2" B.C. ON 2" I.P. extends 6" above grd.

R.M. TO THE S.E. NOT FOUND.

R.M. - 2 1/2" B.C. ON 2" I.P. extends 6" above grd and marked with arrow pointing to true corner - N45°W - 1980 FT from corner. (1950)

No Record of the following BT's:


13" Chink bears S25°E - 11<sup>18</sup> FT (metal disc in face of tree)

32" STUMP bears S43°W - 11<sup>14</sup> FT (metal disc in face of tree)

36" SNAG bears N77°W - 43° FT (metal disc in face of tree)

Monument Detail

Sketch

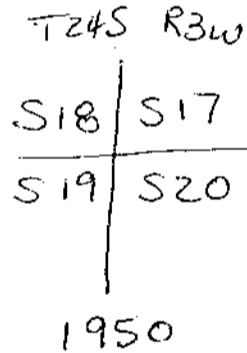

Monument Set (Procedures and Description)

\_\_\_\_\_  
\_\_\_\_\_  
\_\_\_\_\_  
\_\_\_\_\_

New Accessories

R.M. - 2 1/2" Alum CAP ON 1" x 36" I.P. extends 5" above grd. and marked PHS-1988, 1985, R.M. - with ARROW pointing to true corner - bears S45°E - 19<sup>80</sup> FT. FROM true corner.

Location & Comments

Surveyor's Seal

Compass Declination 19°45'E

Firm/Agency CHAMPION

INTE. CORP.

Address P.O. Box 1328

ROSEBURG, OR. 97470

Party Chief R. GEISLER

Notes L. SIBLEY

Witness D. TURNER

