

16 17200
28 12500

FILED
RECEIVED
OCT 2 1985

OREGON CORNER RESTORATION FORM

Section 31 Township 24S Range 1W

County Douglas Date 9/24/85

COUNTY SURVEYOR
DOUGLAS COUNTY, ORE.

Corner Designation

SW Cor. Sec. 31 Township Cor.

- Condition Report Only
- Not Found
- Renewed
- Unrecorded
- Surveyed In
- Referenced Out

Previous Renewals/Surveys, etc. 1981 renewal + 1981 check by Jelley


Monument(s) & Accessories Found: (Condition and Source)

- 27" Fir N64 1/4 E 44' ± OBT
- 17" Fir N18 1/4 E 27' ± At White Cad. resurvey.
- 8" Chink S13 1/4 E 13' ± OBT.


landing construction eliminated these Bts after the corner was referenced out.

Monument Detail

Brass Cap.
36" I.P.

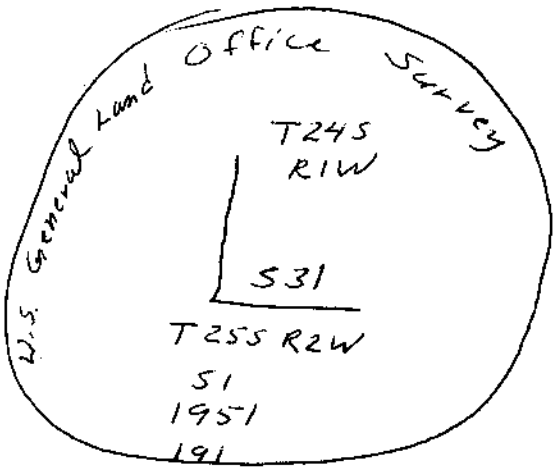

Sketch

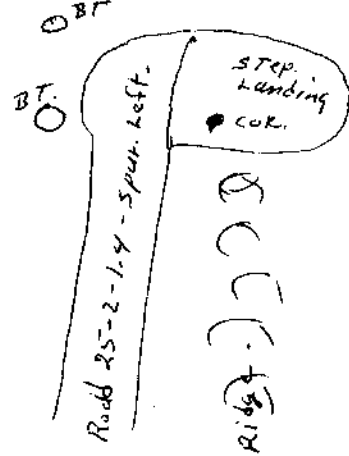

Monument Set (Procedures and Description)

Monument + Bts were in the middle of a proposed landing to be constructed in a logging Clear Cut Unit. I referenced out the B.C. and after the landing was built and the Unit logged I reset the B.C. from my references and scribed 2 Bts to the west which is the only area with remaining timber

New Accessories

- 9" D.F. S45W 102' ± scribed S1 L28 T25S R2W BT
- 26" S. Pine S00W 105' ± S1 L28 T25S R2W BT
- Reset BC. in late mound of rocks.

Location & Comments

corner sets on a step landing at end of spur road and at base of cut slope for landing.
Bts are at toe of road fill slope.

Compass Declination 21°
Firm/Agency Roseburg Lbr. Co.
Address P.O. Box 1088 Roseburg, OR
Party Chief HW Johnstone
Notes _____
Witness _____

Surveyor's Seal

REGISTERED
PROFESSIONAL
LAND SURVEYOR

OREGON
MAY 13, 1960
HOWARD W. JOHNSTONE
498

#117 T.24-1 ✓
#118 T25-2 ✓