

FILED

OREGON CORNER RESTORATION FORM

MAR 25 1987

Section 17 Township 28S Range 8W

County Douglas Date March 19, 1987

COUNTY SURVEYOR
DOUGLAS COUNTY, ORE.

Corner Designation

- Condition Report Only
- Not Found
- Renewed
- Unrecorded
- Surveyed In
- Referenced Out

Previous Renewals/Surveys, etc. 1972 CAD Resurvey, 1982
Roseburg Lbr Co subdivided Sec. 8, 1984 DCS Renewal # 181

Monument(s) & Accessories Found: (Condition and Source)

B.C. good condition


22" Fir N15E 48² Cad resurvey New a high stump face overgrown

10" Fir ~~S~~ 14W 9² Cad resurvey Low stump 1/2 face remains, overgrown

29" DF Fir N49W 33³ blaze open

Monument Detail

Sketch

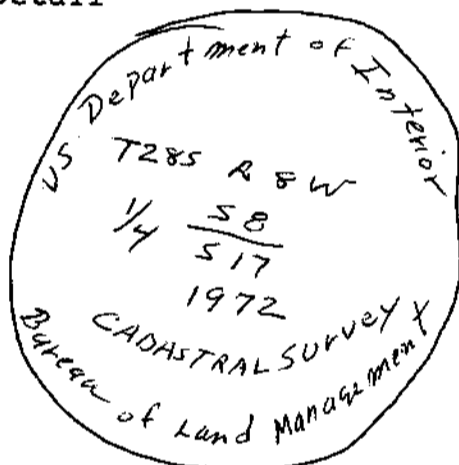

Monument Set (Procedures and Description)

~~7" Hemlock S21W 40²~~

New Accessories

7" Hemlock S21W 40² scribed "1/4 517 BT"

placed Brass tag on face "LS-498" in new clear cut

unit.

Location & Comments

Timber is now cut Compass Declination 20°

on south and Firm/Agency Roseburg

East sides of corner Lumber Co.

Address P.O. Box 1088

Roseburg, OR 97470

Party Chief Howard W. Johnstone

Notes _____

Witness _____

Surveyor's Seal

REGISTERED
PROFESSIONAL
LAND SURVEYOR

OREGON
MAY 13, 1960
HOWARD W. JOHNSTONE
498

#193X

C.S. File No. 63/26-2