

OREGON CORNER RESTORATION FORM

FILED

JL
20
OCT 17 1986

Section 33 Township 28S Range 6W

County DOUGLAS Date 10-15-86

COUNTY SURVEYOR
DOUGLAS COUNTY, ORE.

Corner Designation

28	27
33	34

Condition Report Only
 Not Found
 Renewed
 Unrecorded
 Surveyed In
 Referenced Out

Previous Renewals/Surveys, etc. #108

1961 Renewal

Monument(s) & Accessories Found: (Condition and Source)

Found Cap Bent Over AND ALL BTs DOWN AND ROTTED

BTs:

10" W OAK N15E 19⁰ DOWN! ROTTED

22" R FIR S24E 32⁰ DOWN! ROTTED


7" LAUREL S46 1/2 W 19⁰ DOWN! ROTTED

16" R FIR N73W 30⁰ DOWN! ROTTED

30" B. OAK N50W 110⁰ DOWN! ROTTED (ORIG.)

Monument Detail

Sketch

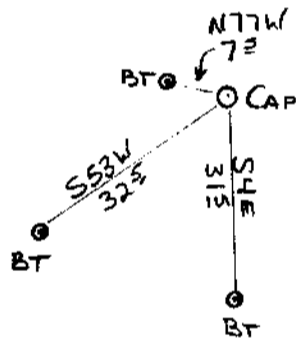

Monument Set (Procedures and Description)

Reset IPBC FROM BT ROOT HOLES AND ROTTED STUMPS. PAINTED EXPOSED PIPE AND BTs WITH YELLOW PAINT

New Accessories

5" MADRONE N77⁰W 7⁰

8" MADRONE S53⁰W 32⁰

6" MADRONE S4⁰E 31⁰

MARKED THESE TREES WITH A FACE, SCRIBED, AND TAGGED

Location & Comments

Surveyor's Seal

Compass Declination 19⁰
 Firm/Agency ROSEBURG FOREST PRODUCTS
 Address PO. Box 1088 ROSEBURG ORE 97470
 Party Chief Floyd White
 Notes Felix Raddatz
 Witness Bill Olson

REGISTERED PROFESSIONAL LAND SURVEYOR

Howard W. Johnstone
 OREGON
 MAY 13, 1960
 HOWARD W. JOHNSTONE
 498

#174X

U.S. File No. 63/26-3