

FILED

WJ
20
OCT 17 1986

OREGON CORNER RESTORATION FORM

Section 33 Township 28S Range 6W

County Douglas Date 10-15-86

COUNTY SURVEYOR
DOUGLAS COUNTY, ORE

Corner Designation

$\frac{1}{4}$ $\frac{28}{33}$

- Condition Report Only
- Not Found
- Renewed
- Unrecorded
- Surveyed In
- Referenced Out

Previous Renewals/Surveys, etc. #13-106

Monument(s) & Accessories Found: (Condition and Source)

Found BCIP


40 Laurel S89°W 37⁵ Down & Rotted. Ren #13

8" Oak N10¹/₂°E 21⁰ Healed Face #106

No sign of Oak S29°E 45⁰ - in meadow #13

Monument Detail

Sketch

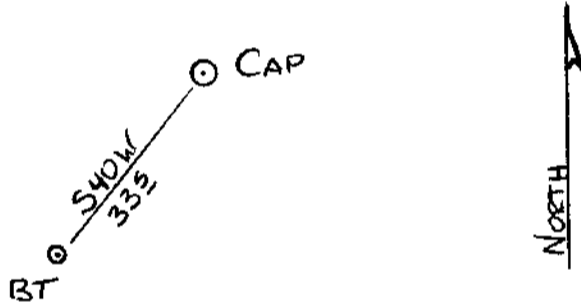

Monument Set (Procedures and Description)

New Accessories

9" Oak S40°W 33⁵

Faced, Scribed, AND TAGGED

Location & Comments

Surveyor's Seal

Compass Declination 19°

Firm/Agency ROSERURG

FOREST PRODUCTS

Address P.O. Box 1088

ROSERURG ORE 97470

Party Chief Floyd White

Notes Felix Raddatz

Witness Bill Olson

REGISTERED
PROFESSIONAL
LAND SURVEYOR

Howard W. Johnstone

OREGON
MAY 13, 1980
HOWARD W. JOHNSTONE
498

#173 *X*

C.S. File No. 63/26-4