

FILED

SL

AUG 18 1986

OREGON CORNER RESTORATION FORM

Section 35 Township 31S Range 7W

County Douglas Date 8/14/86

COUNTY SURVEYOR
DOUGLAS COUNTY, ORE.

Corner Designation

C 1/4

- Condition Report Only
- Not Found
- Renewed
- Unrecorded
- Surveyed In
- Referenced Out

Previous Renewals/Surveys, etc.


1964 Cadastre Subdivision

Monument(s) & Accessories Found: (Condition and Source)

1984 CAD BC
26" Fir N34E 42² Stump, drove 3/8" square x 12" boat spike in center of stump.
21" Fir S53W 16³ Stump, drove 3/8" square x 12" boat spike in center of stump. stump is covered with light sheet metal, painted white.

Monument Detail

Sketch

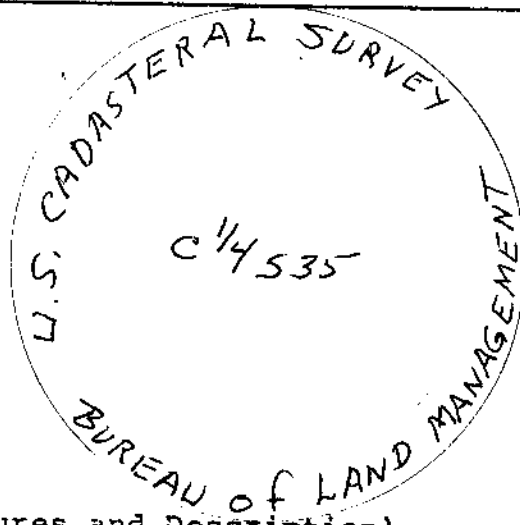

Monument Set (Procedures and Description)

New Accessories

28" D. Fir Stump, drove 3/8" Square X 12" boat spike in center N 21° W 28³ ft

Set a 4' lightweight fence post along side the Brass Cap.

Location & Comments

Surveyor's Seal

Corner falls in the Compass Declination 21°
Middle of Clear Cut Firm/Agency Roseburg
Unit - No Trees Resources
suitable for new Address P.O. Box 1088
Bts. Roseburg OR.
 Party Chief HW Johnstone
 Notes
 Witness

REGISTERED
PROFESSIONAL
LAND SURVEYOR

OREGON
MAY 19, 1980
HOWARD W. JOHNSTONE
498

Howard W. Johnstone

#1274

C.S. File No. 63/26-50