

FILED

jh

JUN 8 1987

OREGON CORNER RESTORATION FORM

Section 3 2 / 10 11 Township 32S Range 7W

County Douglas Date May 27, 1987

COUNTY SURVEYOR
DOUGLAS COUNTY, ORE.

Corner Designation

- Condition Report Only
- Not Found
- Renewed
- Unrecorded
- Surveyed In
- Referenced Out

Previous Renewals/Surveys, etc.

Cadastral resurveys 1964 and.



Monument(s) & Accessories Found: (Condition and Source)

- 40" Fir Stump N62E 59° O.B.T. Covered with metal
- 55" Fir S16E 33° O.B.T. New stump.
- 40" Fir N25W 46° O.B.T. Bark scribes visible
- 17" Fir S62E 48° 1964 CAD New stump.
- 10" Fir N24E 16° 1982 CAD scribe visible
- BC. RM N62E 12° 1964 CAD good shape.

14" Fir Corner Tree, original, Down broken off at ground.

Monument Detail

Sketch

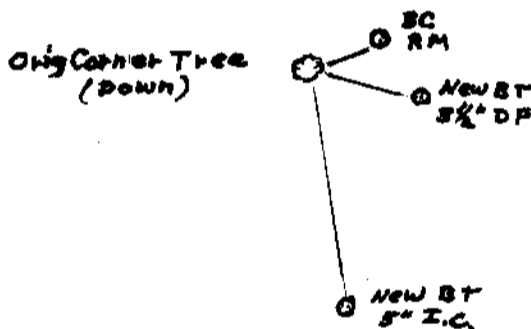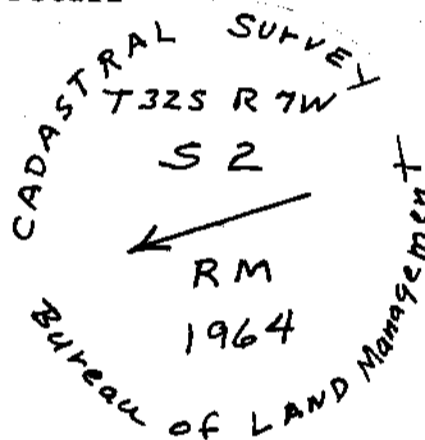

Monument Set (Procedures and Description)

New Accessories

- 5" Incense Cedar 59E 48° scribed: T32S R7W S 11 BT
- 3 1/2" D.F. 577E 24E scribed X BT

No trees available to the south west.

Location & Comments

Sections 2, 10, Compass Declination 20°
+ 11 have been clear Firm/Agency Roseburg
cut. Section 11 This Resources.
Past Spring Address P.O. Box 1088
Roseburg OR
 Party Chief Howard Johnston
 Notes _____
 Witness _____

Surveyor's Seal

REGISTERED
PROFESSIONAL
LAND SURVEYOR

Howard W. Johnston

OREGON
MAY 13, 1960
HOWARD W. JOHNSTONE
498

#117 ✓

C.S. File No. 63/26-7