

OREGON CORNER RESTORATION FORM

APR 29 1986

Section 26 Township 26S Range 3W

COUNTY SURVEYOR
DOUGLAS COUNTY, ORE.

County Douglas Date 4-14-86

Corner Designation

W $\frac{1}{4}$

- Condition Report Only
- Not Found
- Renewed
- Unrecorded
- Surveyed In
- Referenced Out

Previous Renewals/Surveys, etc. _____


Monument(s) & Accessories Found: (Condition and Source)

13" Cedar bears S61°W - 39 $\frac{1}{2}$ FT - Scribing visible (1972)
14" Cedar (now stump) bears N45°E - 24 $\frac{1}{2}$ FT - Scribing
partially visible (1972)

Monument Detail

B.L.M. 3 $\frac{1}{2}$ " B.C. on a 2 $\frac{1}{2}$ "
 I.P. - extends 5" above
 ground

Sketch

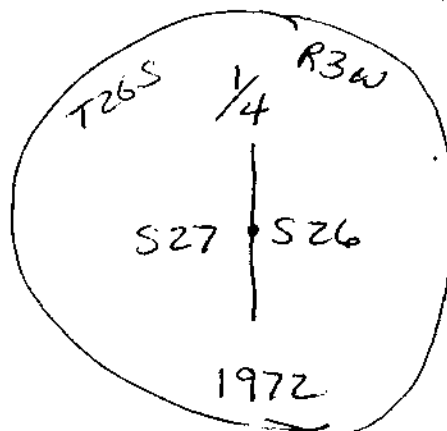

Monument Set (Procedures and Description)

New Accessories

Location & Comments

Compass Declination 19°E

Firm/Agency Champion International

Address P.O. Box 1328

Roseburg - Oregon

Party Chief Lynn Sibley

Notes Dean Turner

Witness _____

Surveyor's Seal

REGISTERED
 PROFESSIONAL
 LAND SURVEYOR

Ronald G. Geisler

CREATED
 JULY 13, 1972
 RONALD G. GEISLER
 1978

See Also June
 Notes Attached