

FILED

JUN 25 1986

OREGON CORNER RESTORATION FORM

Section 26 Township 26S Range 3W

County Douglas Date 6-19-86

COUNTY SURVEYOR
DOUGLAS COUNTY, ORE

Corner Designation

W 1/4

- Condition Report Only
- Not Found
- Renewed
- Unrecorded
- Surveyed In
- Referenced Out

Previous Renewals/Surveys, etc. _____


Monument(s) & Accessories Found: (Condition and Source)

13" Cedar bear's S61°W - 39 1/2 FT Scribing Visible (1972)
14" Cedar stump bears N45°E - 24 40 FT Scribing
Partially Visible (1972)

Monument Detail

3 1/2" B.C. on a 2 1/2" I.P.
extends 5" Above grd.

Sketch

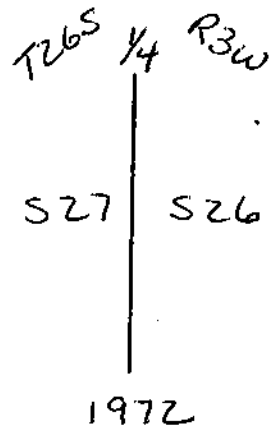

Monument Set (Procedures and Description)

New Accessories

Location & Comments

Surveyor's Seal

Compass Declination 19°E

Firm/Agency CHAMPION

INTERNATIONAL



Address P.O. Box 1328

Roseburg OR

Party Chief Dean Turner

Notes Lynn Sibley

Witness _____

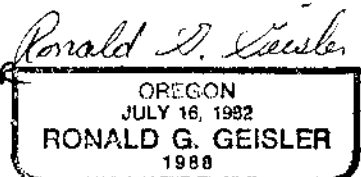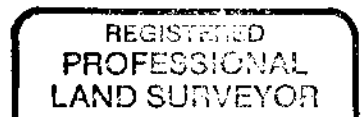

(Duplicate)