

FILED

OREGON CORNER RESTORATION FORM

Section 26 Township 26S Range 3W

JUN 25 1986

County Douglas Date 6-19-86

COUNTY SURVEYOR
DOUGLAS COUNTY, ORE.

Corner Designation

S 1/16

- Condition Report Only
- Not Found
- Renewed
- Unrecorded
- Surveyed In
- Referenced Out

Previous Renewals/Surveys, etc.

Set in 1972 by B.C.M.

Monument(s) & Accessories Found: (Condition and Source)


25" Cedar (STUMP) bears S87°E - 30⁹⁵ FT (Rec. 3168)
CLOSED FACE (1972)

17" Cedar bears S82°W - 13⁸² FT (Rec. 1452)
Healed FACE (1972)

Monument Detail

B.C.M. 3 1/2" B.C. on a 2 1/2" I.P.
extends 7" above grd.

Sketch

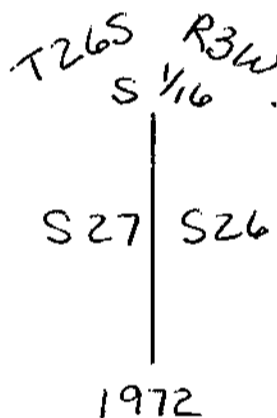

Monument Set (Procedures and Description)

New Accessories

Location & Comments

Compass Declination 19°E

Firm/Agency CHAMPION

International

Address P.O. Box 1328

Roseburg OR

Party Chief Dean Turner

Notes Hyun Sibley

Witness _____

Surveyor's Seal

REGISTERED
PROFESSIONAL
LAND SURVEYOR

Ronald G. Geisler
OREGON
JULY 16, 1982
RONALD G. GEISLER
1988

C.S. File No. 63/57-6

Duplicate