

FILED

OREGON CORNER RESTORATION FORM

APR 29 1986

Section 12 Township 30S Range 1W  
County Douglas Date 4/86

COUNTY SURVEYOR  
DOUGLAS COUNTY, ORE.

Corner Designation

North 1/4 corner

- Condition Report Only
- Not Found
- Renewed
- Unrecorded
- Surveyed In
- Referenced Out

Previous Renewals/Surveys, etc. \_\_\_\_\_

Monument(s) & Accessories Found: (Condition and Source)

7" W. Fir bears S60°15'W; 5.30 Ft. scribe visible (1978)  
16" D. Fir bears N12°51'W; 24.40 Ft. scribe partially visible (1978)

Monument Detail

2 1/2" B.C. on a 2 1/2" I.P. protrudes  
2" above ground.

Sketch

T30S R1W  
1/4  $\frac{S1}{S12}$

R.L.S. 866  
1978

Monument Set (Procedures and Description)

New Accessories

Location & Comments

Compass Declination 19°E  
Firm/Agency Champion  
International  
Address P.O. Box 1328  
Roseburg, OR.  
Party Chief Lynn Sibley  
Notes Lynn Sibley  
Witness Dean Turner

Surveyor's Seal

REGISTERED  
PROFESSIONAL  
LAND SURVEYOR

Ronald G. Geisler

CREATED  
JULY 19, 1982  
RONALD G. GEISLER  
1973

See June  
Visit Notes  
Attached

U.S. File No. 63/349

FILED

JUN 25 1986

OREGON CORNER RESTORATION FORM

Section 12 Township 30S Range 1W

County Douglas Date 6-18-86

COUNTY SURVEYOR  
DOUGLAS COUNTY, ORE.

Corner Designation

North  $\frac{1}{4}$  corner

- Condition Report Only
- Not Found
- Renewed
- Unrecorded
- Surveyed In
- Referenced Out

Previous Renewals/Surveys, etc. \_\_\_\_\_

Monument(s) & Accessories Found: (Condition and Source)

1978 BT W. Fir 7" bears  $S60^{\circ}15'W$ ;  $5^{\circ}30'$  ft. Scribe visible

1978 BT D. Fir 16" bears  $N12^{\circ}51'W$ ;  $24^{\circ}40'$  ft. Scribe partially visible

Monument Detail

$2\frac{1}{2}$ " A.C. on a  $2\frac{1}{2}$ " I.P. protrudes  
2" above ground.

Sketch

T305 RIW

$\frac{1}{4}$   $\frac{S1}{S12}$

R.L.S. 866  
1978

Monument Set (Procedures and Description)

New Accessories

Location & Comments

Compass Declination  $19^{\circ}E$

Firm/Agency Champion

International

Address P.O. BOX 1328


Rifle Range Road; Roseburg, OR.

Party Chief Lynn Sibley

Notes Lynn Sibley

Witness Dean Turner

Surveyor's Seal

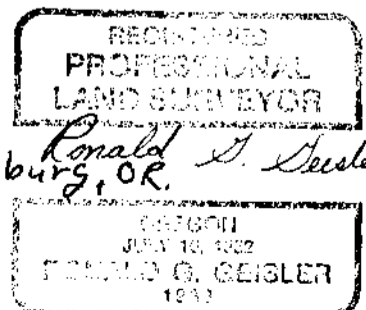

G.S. File No. 63/379A

Duplicate