

FILED

OREGON CORNER RESTORATION FORM

MAR 17 1986

Section 11 Township T27S Range 3W

COUNTY SURVEYOR
DOUGLAS COUNTY, ORE.

County Douglas Date 2-5-86

Corner Designation

CN $\frac{1}{16}$

- Condition Report Only
- Not Found
- Renewed
- Unrecorded
- Surveyed In
- Referenced Out

Previous Renewals/Surveys, etc.

ESTABLISHED BY BEN IRVING IN 1945, FOUND BY SHRUM IN 1964, AND B.L.M. IN 1984. NO RECORD OF CAP SET ON I.P.

Monument(s) & Accessories Found: (Condition and Source)


11" W. OAK Bears S3°W-17⁴⁰ FT (Rec. 1782)

12" W. OAK Bears N70 $\frac{1}{2}$ °E-39²⁷ FT - Scribing partially visible (1945)

Monument Detail

2 $\frac{1}{2}$ " Alum cap on a 1" I.P.
Set Flush with grd.

Sketch

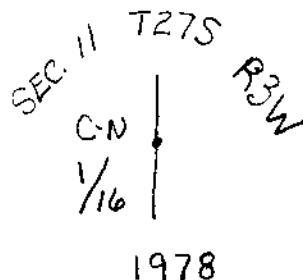

Monument Set (Procedures and Description)

New Accessories

Location & Comments

Compass Declination 19° E

Firm/Agency Champion International

Address P.O. Box 1328, Roseburg, OR

Party Chief Lynn Sibley

Notes Dean Turner

Witness _____

Surveyor's Seal

REGISTERED
PROFESSIONAL
LAND SURVEYOR

Ronald G. Geisler

OREGON
JULY 16, 1982
RONALD G. GEISLER
1988