

FILED

OREGON CORNER RESTORATION FORM

MAR 17 1986

Section 14 Township 27S Range 3W COUNTY SURVEYOR
County Douglas Date 3-12-86 DOUGLAS COUNTY, ORE.

Corner Designation

W 1/16

- Condition Report Only
- Not Found
- Renewed
- Unrecorded
- Surveyed In
- Referenced Out

Previous Renewals/Surveys, etc. _____

Monument(s) & Accessories Found: (Condition and Source)

25" W. Fir Bears N36°W - 34 1/2 FT - Healed Face

Monument Detail

Sketch

"T" Fence post extends
"29" Above grd.

Monument Set (Procedures and Description)

New Accessories

8" D. FIR Bears S04°E - 9 1/2 FT (1986) Scribed; W 1/16
S 23 - B.T.

Location & Comments

Surveyor's Seal

Compass Declination 19°E


Firm/Agency Champion
International

Address P.O. Box 1328
Roseburg OR

Party Chief Lynn Sibley

Notes Dean Turner

Witness _____

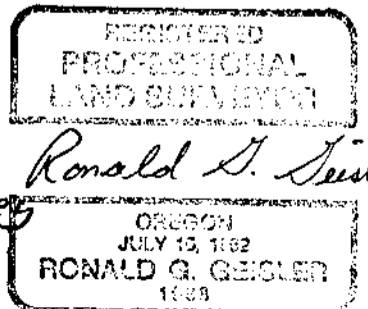

C.S. File No. 63/32-16