

FILED

OREGON CORNER RESTORATION FORM

JUN 25 1986

Section 1 Township 27S Range 3W

COUNTY SURVEYOR
DOUGLAS COUNTY, ORE.

County Douglas Date 6-12-86

Corner Designation

E $\frac{1}{16}$

- Condition Report Only
- Not Found
- Renewed
- Unrecorded
- Surveyed In
- Referenced Out

Previous Renewals/Surveys, etc.

Set By: HAROLD D. Corbin (1958)

Monument(s) & Accessories Found: (Condition and Source)

19" D. FIR Bears N58 $\frac{1}{2}$ °W - 25⁷⁴ FT Healed Face (1958)

7" FIR (downed) Bears S74 $\frac{1}{2}$ °E - 7⁹² FT - Scribing partially visible (1958)

Monument Detail

Sketch

3 $\frac{1}{2}$ " B.C. on a 2 $\frac{1}{2}$ " I.P.
extends 5" above grid.
Set By: HAROLD D, Corbin
(1958)

E $\frac{1}{16}$ SI
SI2
1958

Monument Set (Procedures and Description)


New Accessories

5" D. FIR Bears S37°W - 42¹³ FT - Scribed "X B.T." 1986

Location & Comments

Surveyor's Seal

Compass Declination 19°E
Firm/Agency CHAMPION International
Address P.O. Box 1328
Roseburg OR.
Party Chief Dean Turner
Notes Lynn Sibley
Witness _____

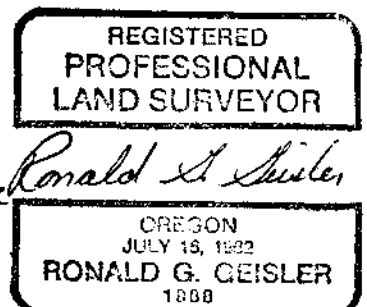

C.S. File No: 63/34-0
27