

FILED

OREGON CORNER RESTORATION FORM

JUN 25 1986

Section 16 Township 27S Range 3W

County Douglas Date 6-12-86

COUNTY SURVEYOR
DOUGLAS COUNTY, ORE.

Corner Designation

North $\frac{1}{4}$

- Condition Report Only
- Not Found
- Renewed
- Unrecorded
- Surveyed In
- Referenced Out

Previous Renewals/Surveys, etc.

Set in 1958 by B.L.M.

Monument(s) & Accessories Found: (Condition and Source)


14" P. FIR (NOW 6' tall STUMP) Bears S07°E - 38²⁸ FT
NO Blazes (1958)

19" Cedar Bears N66°W - 11⁸⁸ FT Scribing Visible (1958)

Monument Detail

Sketch

Found: ^{B.L.M.} 3 $\frac{1}{2}$ " B.C. on a 2 $\frac{1}{2}$ "
I.P. extends 4" Above grd.

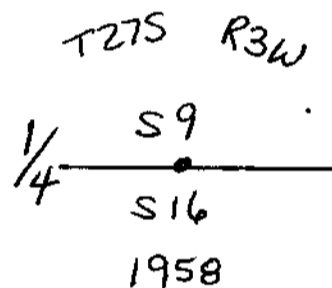

Monument Set (Procedures and Description)

New Accessories

Location & Comments

Surveyor's Seal

Compass Declination 19° E

Firm/Agency CHAMPION
INTERNATIONAL

Address P.O. Box 1328
Roseburg OR

Party Chief Dean TURNER

Notes Lynn Sibley

Witness _____

REGISTERED
PROFESSIONAL
LAND SURVEYOR

Ronald G. Geisler

OREGON
JULY 18, 1982
RONALD G. GEISLER
1988